Paper weight-110# (minimum)

Black nonfading ink required

U.S. PUBLIC LAND SURVEY MONUMENT RECORD


For Public Land Survey Corners In:

WI ADMINISTRATIVE CODE A-E 7.08 REQUIREMENT

EV 10/23/2804 USMONREC.DWG

T. $\frac{4}{N}$ N. R. $\frac{10}{E}$ 4th P.M.

CORNER CODE INDEX

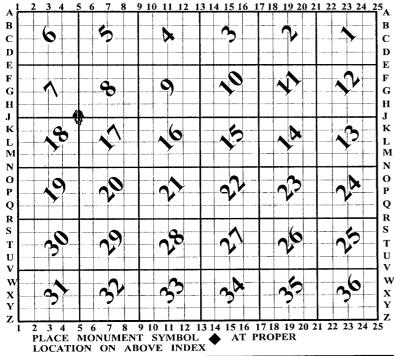

UNION TWP

IF AVAILABLE ROCK COUNTY COORDINATES PERFERRED

North	Elev
East	
Hor. Datum _	Vert. Datum
LATITUDE	ELLIPS. HT
LONGITUDE	
NAD83(91)	NETWORK ADJ. YR 2010
GPS (X)	TRAVERSE (X) X
BASED ON TH	E FOLLOWING CONTROL:

◆ CORNER MONUMENT

WITNESS MONUMENT

FIELD BOOK PAGE #			11-
OIL ODDIER TATIOT CARREST			
SHOW A PLAN VIEW DRAWING DEPICTING THE CORNER MONUMENT AND S	SURROUN	DING	
PHYSICAL FEATURES, INCLUDING THE EXCAVATION AREA AND DEPTH.			
PLANNING & ZONING COMMITTEE ADOPTED THIS FORM ON 12/2/1982			•

UN543 NECORSEC18

(B) Describe any record evidence, monument evidence, occupational evidence, testimonial evidence or any other material evidence you considered, and whether the monument was found or placed.

1833 HARRISON T4N T10E 4TH MER NORTH BET SECS 17 & 18
2640.00 QUARTER SEC COR. SET POST & RAISED
MOUND

4488.00 LEAVE PRAIRIE & ENTER TIMBER

5280.00 COR TO SECS 7,8,17,18 {BURR 0. 18 N40W 9.9'; BURR 0 18 N42E 27.72'; BURR 0 12 S73E 48.18'; BURR 0 12 S16W 54.78' LAND 1ST 3/4 OF THE MILE LEVEL 1ST RATE PRAIRIE GROWTH OF HAZLE, GRASS & WEEDS

1833 HARRISON (NOV 10) EAST ON RAND. BET SECS 8 & 17

1026.96 ROAD S.E.

2640.00 TEMPY 1/4 SEC COR.

3960.00 BROOK 5.28' CRS S.E.

5286.60 ROAD S.W

5330.16 E BDY 19.8'S OF P LAND ROLLING 2ND RATE TIMBER RED BURR & W.O. GROWTH GRASS & WEEDS

WEST COR WEST BET 8 & 17

2663.43 QUARTER SEC COR {BURR O 20 N40W 13.2'; BURR O 12 S72E 19.8' BURR O 20 & BURR O 12}MARKED

5330.16 SEC COR

NOV 10TH 1833

1833 HARRISON T4N T10E 4TH MER WEST BETWEEN SECS 7 & 18

1114.08 BURR 0 12

1980.0 LEAVE TIMBER & ENTER PRAIRIE

2640.00 QUARTER SEC COR SET POST & RAISED MOUND

5396.16 INT. WEST BDY SET COR TO SECS 7 & 18 SET POST & RAISED MOUND LAND 1ST 1980' LEVEL 2ND RATE WITH BURR O TIMBER RUN LEVEL 1ST RATE PRAIRIE

1833 HARRISON (NOV 10TH) T4N T10E 4TH MER NORTH BET SECS 7 & 8

643.5 TO THE ROAD E & W

2640.00 QUARTER SEC COR {WO 19 N55W 64.68; W.O. 12 N25W 106.92' W.O. 19 & WO 12}MARKED

2310.00 ENTERED MARSH CRS S.E.

4950.00 LEAVE MARSH & ENTER TIMBER

5280.00 CORNER TO SECS 5,6,7,8 {BURR 0 15 S85W 213.84'; BURR 0 12 N83W 172.26' LAND 1ST 1/2 SAME AS BEFORE 2ND 1/2 LEVEL & WET 3RD RATE BEING MOSTLY MARSH

1856 CHURCH VOL 1 PG 58 STATES NOTHING ABOUT MON. 2682.24 TO S 1/4 COR SEC 8

1861 RUGER VOL 1 PG 166 SURROUNDED POST BY 4 HH. 2645.28 TO N 1/4 COR SEC 18.

1863 LOCKE VOL 1 PG 193 CORNER SET BY RUGER IN SECTION 18. 2650.56 TO FD 3 HH SET BY RUGER @ S 1/4 COR SEC 7.

1870 RUGER VOL 2 PG 50 STONE MON. SET BY SELF

1870 RUGER AUG REMON-90 EAST ON NORTH LINE OF NW 1/4

SEC 17 ON A VAR 7-10; OFFSET NORTH 20.46'

OFFSET NORTH 18.15' OFFSET SOUTH 15.84'

COULD FIND NO TRACE OF QUARTER CORNER.

CONTINUED EAST ON SAME VARIATION AT

SHEET 1 OF 4

CORNER CODE J-5

Hasle Emboss Paines 0 ct 26,22//

UN543 NECORSEC18

- 5379.00 INTERSECTED EAST BOUNDARY LINE AT CORNER ESTABLISHED NORTH QUARTER CORNER IN A TRUE LINE BETWEEN AND EQUI-DISTANT FROM THE NE AND NW CORNERS OF SAID SECTION, IT BEING 2689.50 DISTANT FROM EACH. COR VAR 7-40
- 1870 RUGER AUG 26 REMON-88 NORTH ON EAST LINE OF SE 1/4 SEC 18 ON A VAR 6-50; AT
 - 2647.42 INTERSECTED QUARTER LINE AT QUARTER CORNER. FOUND LIMESTONE AT CORNER SET BY SELF IN PREVIOUS SURVEY. AUG 26 1870

 NORTH ON EAST LINE OF NE 1/4 SEC 18

ON A VAR 7-23; AT

- 2650.06 INTERSECTED NORTH BOUNDARY LINE 3.3
 WEST OF CORNER. FOUND STAKE SURROUNDED
 BY HARD HEAD STONES AT CORNER SET BY SELF
 IN A PREVIOUS SURVEY. COR VAR 7-19
- 1870 RUGER AUG REMON-89 WEST ON NORTH LINE OF NE QUARTER SEC 18 ON A VAR 7-05; OFFSET SOUTH 21.12'AT
 - 2645.28 INTERSECTED QUARTER LINE AT QUARTER CORNER. FOUND STAKE AT CORNER SET BY SELF IN A PREVIOUS SURVEY. COR VAR 7-32 WEST ON NORTH LINE OF NW 1/4 SEC 18 ON A VAR 7-26 AT
 - 2756.16 INTERSECTED WEST BOUNDARY LINE AT CORNER. FOUND LIME STONE AT CORNER SET BY SELF IN A PREVIOUS SURVEY.
- 1870 RUGER AUG REMON-121 SOUTH ON WEST LINE OF NW
 1/4 SEC 8 ON A VAR 5-05; AT
 - 2657.82 INTERSECTED QUARTER LINE 43.56' EAST OF QUARTER CORNER. FOUND OLD STAKE AT CORNER ALSO FOUND STUMPS OF BOTH BEARING TREES. COR VAR 4-09

SOUTH ON WEST LINE OF SW 1/4 SEC 8 ON A VAR 8-OO; OFFSET EAST 13.20' AT

- 2644.62 INTERSECTED SOUTH BOUNDARY LINE 32.34'
 EAST OF CORNER COR VAR 7-34
- 1971 LEE VOL 4 PG 504 DUG & FD NOTHING @ CENTER OF DRIVEWAY & PLEASANT PRAIRIE RD.
- 1979 BARNES VOL 5 PG 528 N88-55-09E 2694.14 TO N 1/4 COR SEC 17 & S1-07-18E 2656.21 TO W 1/4 COR SEC 17
- 1979 BARNES VOL 5 PG 530 FD CUT LIMESTONE SURROUNDED BY 3 LARGE HH. REFERENCED SAME. 0.5' DEEP. @ FENCE INT.
- 1982 BARNES VOL 6 PG 273 SHOWS REC DISTANCES
- 1996 KARNS CSM VOL 19 PG 340 FD STONE. USED STONE @ W 1/4 COR SEC 8 FOR LINE. COR IS 971.32 SOUTH OF CENTER OF RD
- 2000 KARNS CSM VOL 23 PG 116 ROCK COUNTY SEC COR. 2691.76 TO ROCK COUNTY SEC COR. @ N 1/4 COR SEC 17

RECORD REFERENCE MONUMENTS AND FENCE LINES WERE DESTROYED. FD CUT LS WITH LARGE HH ON EAST & SOUTH SIDE 1.3' DEEP. PLACED 3 MAGNETS ON EAST & SOUTH SIDE OF LS. LS IS 11' WEST OF CENTER OF PVMT & 1.5 WEST OF WEST PVMT EDGE. TOP END OF STONE IS BROKE.

SHEET 2 OF 4

CORNER CODE **J-5**

5=1) faires 0 (T 26, 201)

UN543 NECORSEC18

C) Was the corner restored through acceptance of (1) an obliterated evidence location, or, (2) a found perpetuated location?

ACCEPTED FOUND CUT LIMESTONE.

D) Describe any material discrepancy between the location of the corner as restored or reestablished and the location of that corner as previously restored or reestablished by distance and direction. Show the discrepancy on the plan view drawing under (a), above. Show the distances between the corner as previously restored or reestablished and (1) the corner as restored or reestablished, and (2) to at least 4 of the witness monuments shown on the drawing in (a), above.

NONE

(E) Was the corner reestablished through lost corner proportionate methods? If so, show the method, including the directions and distances to other public land survey corners used as evidence or used for proportioning the corner location.

NO

Onle Baues Oct 26,2011

I, **Donald Barnes**, hereby certify that the corner location as identified by the corner code index was determined by me under my direction and control and that this U.S. Public Land Survey Monument Record is correct and complete to the best of my knowledge and belief.

SHEET 3 OF 4

GORNER GODE J-5

A.E. 7.08 REQUIREMENT

