
U.S. PUBLIC LAND SURVEY MONUMENT RECORD

For Public Land Survey Corners in UNION TWP. T. 4 N., R. 10 E.

For Miscellaneous Corners within Sec. <u>20</u>, T. <u>4</u> N., R. <u>10</u> E.

CORNER CODE INDEX

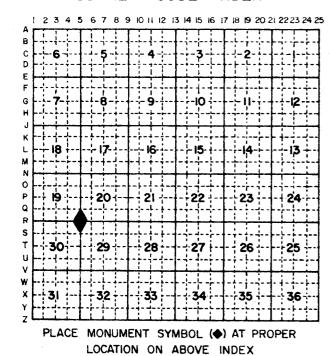

Above code numbers are positioned Meander, Claim, or Fractional corners of the section.
 Township corner code numbers shall be applied to the corners of above typical section.

EXAMPLE

IF AVAILABLE

STATE PLANE COORDINATES

North (Y) Eleve. (Z)


East (X) Zone

Hor. Datum Vert. Datum

(a.)

CORNER MONUMENT

O WITNESS MONUMENT

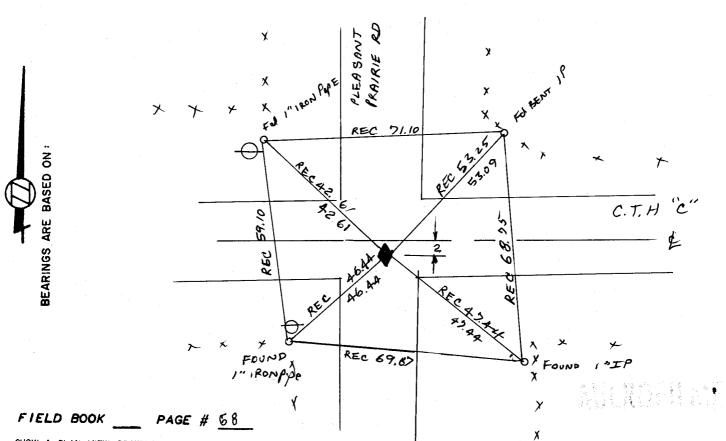

SHOW A PLAN VIEW DRAWING DEPICTING THE CORNER MONUMENT AND SURROUNDING PHYSICAL FEATURES, INCLUDING THE EXCAVATION AREA AND DEPTH. THE CORNER MONUMENT SHALL HAVE THE FOLLOWING CHARACTERISTICS: 1) HAVE AT LEAST TWO PREDETERMINED BREAK-OFF POINTS. 2) IF BROKEN, LEAVE A PERMANENTLY MAGNETIZED REMNANT AT THE ORIGINAL POINT. 3) MUST BE EXTENDABLE. 4) THE CAP IS INSCRIBED: ROCK COUNTY SURVEY MONUMENT - PENALTY FOR DISTURBING MARKER. 5) OR AN EXISTING CUT LIMESTONE. AN IRON PIPE 1 × 4 '0" (MINIMUM) MAY BE USED IN AREAS WHERE GROUND WATER IS WITHIN ONE FOOT OF THE SURFACE. IF THE CORNER IS OCCUPIED BY AN IMPROVEMENT (MANHOLE, BURIED CABLE, ETC.) ANY DURABLE, DISTINCT MONUMENT MAY BE USED. CORNERS SHALL BE REFERENCED WITH AT LEAST 4 DURABLE WITNESS MONUMENTS. SHALL BE MADE OF CONCRETE, NATURAL STONE, IRON OR OTHER EQUALLY DURABLE MATERIAL, EXCEPT WOOD. DESCRIBE THE CORNER AND THE WITNESS MONUMENTS.

CORNER CODE: R 5

		av	FP 0 -00	TIED	11	2 P	$\boldsymbol{\omega}$						
	SET	FE	FRO M	TIES,	VOL	4	lage	245					
					•								
)	Was the	e corr perpet	ner resto	red throu cation?	igh acce	ptanc	e of (1) an ob	iterat	ed evic	lence i	ocation.	or, (2) a
	Accep	TED	FOUN	PERPE	TUATE	D L	CATION	V					
	,,,,,,,,,,,,,,,,,,,,,,,,,,,,,,,,,,,,,,,												
												•	
)	reestal by dist above. and (1	olishe tance Show the	ed and the and dire the dis corner a	l discrepte location sction. Stances be s restore the drawin	n of the how the tween t d or re	at co disc he co estab	rner as repancy rner as lished,	previous on the previous	isly re plan v islv re	stored iew dra stored	or rees wing un	stablishe nder (o), stablishe	d
							ALCOHOL:	. "x =					
									er er				
)	metho	d, ind	cluding t	stablished he direct or proport	ions an	d dis	tances	to other	r publi	c land	survey	fiso, sho corners	w the used as
)	metho	d, ind	cluding t	he direct	ions an	d dis	tances	to other	r publi	c land	survey	f so, sho corners	w the used as
)	metho	d, ind	cluding t	he direct	ions an	d dis	tances	to other	r publi	c land	survey	f so, sho corners	w the used as
.)	metho evide	d, inc	eluding t	he direct	ions an	d dis in de	tances termini	to other	r publi	e land locatio	survey	corners	used as
)	metho evide I, as	ide of struck of the struck of	eluding to used for used for used for settions actions	ed by th	ne cortablisced as	d disin de	nereby code cores equired	cert: index establ: d belo	ify were ished ow an	that , in , mon d in rrent	the a fie ument confo	corners corner ld surv ed, re- rmance al of	points vey on monumer with th
)	metho evide I, as	ide of struck of the struck of	eluding to used for used for used for settions actions	the director proport the director proport the director and rull to find the director and rull to	ne cortablisced as	d disin de	nereby code re-e presse guired states	cert: index establ: d belo	ify were ished ow an ne cu otmen	that, in, mond in rrent t of	the a fie ument confo manu Inter	corners corner ld surv ed, re- rmance al of s ior, Bu	points vey on monumer with th
)	metho evide I, as	ide of struck of the struck of	eluding to used for used for used for settions actions	the director proport the director proport the director and rull to find the director and rull to	ne cortablisced as	d disin de	nereby code re-e presse uired tates	cert: index establ: d belo	ify were ished bw an he cu rtmen	that , in , mon d in rrent t of	the a fie ument confo manu Inter	corners corner ld surv ed, re- rmance al of s ior, Bu	points vey on monumer with th
)	metho evide I, as	ide of struck of the struck of	eluding to used for used for used for settions actions	the director proport the director proport the director and rull to find the director and rull to	ne cortablisced as	d disin de	nereby code, re-epressed tates COUNT	cert: index establ: d belo	ify were ished ow an ie cu rtmen	that , in , mon d in rrent t of	the a fie ument confo manu Inter	corners corner ld surv ed, re- rmance al of s ior, Bu	points vey on monumer with th
)	metho evide I, as	ide of struck of the struck of	eluding to used for used for used for settions actions	the director proport the director proport the director and rull to find the director and rull to	ne cortablisced as	d disin de	nereby code coresse uired tates COUNT Date Date	certindex establiced below the Department of Com	ify were ished ow an itmen VEYOR inpute	that, in, mond in rrent t of	the a fie ument confo manu Inter	corners corner ld surv ed, re- rmance al of s ior, Bu	points vey on monumer with th
)	metho evide I, as	ide of struck of the struck of	eluding to used for used for used for settions actions	the director proport the director proport the director and rull to find the director and rull to	ne cortablisced as	d disin de	nereby code, re-estates COUNT Date Date Date	certification control of the control	ify wered ow an ne cu ctmen VEYOR npute ved tilme	that , in , mon d in rrent t of FILI r Ent	the a fie ument confo manu Inter	corners corner ld surv ed, re- rmance al of s ior, Bu	points vey on monumer with th