Paper weight-110# (minimum)

Black nonfading ink required

U.S. **PUBLIC**


LAND SURVEY MONUMENT RECORD

Public Land Survey Corners In:

WI ADMINISTRATIVE CODE A-E 7.08 REQUIREMENT

T. 4 N. R. 10 E. 4th P.M.

CORNER CODE INDEX

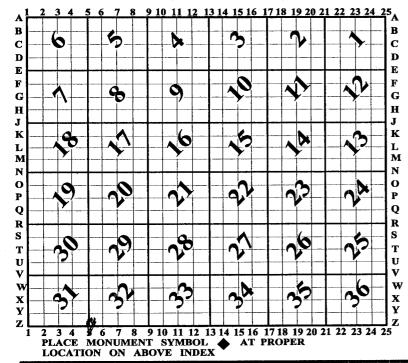

UNION TWP ROCK COUNTY WI

IF AVAILABLE ROCK COUNTY COORDINATES PERFERRED

North	Elev
East	
Hor. Datum	Vert. Datum
LATITUDE	ELLIPS. HT.
LONGITUDE _	
NAD83(91)	NETWORK ADJ. YR 2010
GPS (X)	TRAVERSE (X) X
BASED ON THE	FOLLOWING CONTROL:

♦ CORNER MONUMENT

WITNESS MONUMENT

(a) ROCK COUNTY PROJECTION BEARINGS ARE BASED ON:_

FIELD BOOK PAGE # OR OBSERVATION SHEET	SHEET	OF	4
SHOW A PLAN VIEW DRAWING DEPICTING THE CORNER MONUMENT AND S	SURROUN	DING	
PHYSICAL FEATURES, INCLUDING THE EXCAVATION AREA AND DEPTH.			
PLANNING & ZONING COMMITTEE ADOPTED THIS FORM ON 12/2/1982			
CODNED	CODE	7-	-5

UN623 SECORSEC31

(B) Describe any record evidence, monument evidence, occupational evidence, testimonial evidence or any other material evidence you considered, and whether the monument was found or placed.

1833 BRINK & MULLETT (SEP 12) T4N R10E

WEST ON SOUTH SIDE OF SECTION 32 (PG110)

2640.00 SET QUARTER SECTION POST B OAK 18 N49 1/2W 197.34'; B. OAK 16 N15 1/2W 229.02'

2838 LEAVE PRAIRIE

5280.00 SET POST FOR CORNER TO SECTIONS 31 & 32. W/
PAL 16 N39E 38.94'; BURR OAK 18 N41W 82.5'
FIRST HALF LEVEL RICH PRAIRIE RED ROOT ROSE
WILLOW GRASS & C WESTERN HALF ROLLING
SECOND RATE BURR B & W OAK HAZLE RED ROOT
& C.

1833 BRINK & MULLETT (SEP 12) T4N R10E

WEST ON SOUTH SIDE OF SECTION 31 (PG111)

249.48 W. DAK 14

2640.00 SET QUARTER POST BURR OAK 7 N43E 55.44'; BURR OAK 6 N 70W 65.34'

5732.76 INTERSECTED RANGE LINE 924' NORTH OF
CORNER TO SECTIONS 1 & 12. SET POST AT
INTERSECTION FOR CORNER TO TS 3 & 4N R10E.
W. OAK 16 N61E 15.18'; W OAK 18 S8E 75.9'
LAND ROLLING SECOND RATE BURR OAK W. OAK
HICKORY & C HAZLE ????? SEPT 12TH 1833

1833 HARRISON

T4N T10E 4TH MER

NORTH BET SECS 31 & 32

1980.00 LEAVE TIMBER & ENTER PRIAIRE
2640.00 QUARTER SEC COR. {SET POST & RAISED A
MOUND OF EARTH & SODS

5280.00 COR TO SECS 29,30,31,32 SET A POST & RAISED A MOUND OF EARTH & SODS LAND 1ST 1/2 ROLLING 2ND RATE TIMBER W.O. & BURR O.

GROWTH GRUBS, GRASS, & WEEDS LAST

1/2 ROLLING 1ST RATE PRAIRIE WITH GROWTH OF GRASS & WEEDS

1833 HARRISON (DEC 7TH) T3N T10E 4TH MER

NORTH BET SECS 5 & 6

264 LEFT MARSH OR CREEK BOTTOM

1208.46 BURR 0 24 IN DIAM

2640?? {BURR 0 18 S9W 56.76'; BURR 0 12 S76E 64.02' BURR 0 18; BURR 0 12}MARKED

4809.42 INT. N BDY 246.18'W OF P WO 18 COR TO SEC 5 & 6 LAND ROLLING 2ND RATE LEVE3L BURR & WHITE OAK MOSTLY GRASS, &&& SATURDAY DEC 7TH 1833 (BAD WEATHER SNOW & RAIN)

MAGNOLIA TWP RD REC BK 1 PG 25 """ WHEREOF AN 1859 ACCURATE SURVEY HAS BEEN MADE WHICH IS AS FOLLOWS TO WIT. COMMENCING AT THE QUARTER STAKE ON THE SOUTH LINE DIVIDING SEC 32 OF UNION & SECTION FIVE IN MAGNOLIA AND RUNNING THENCE WEST ALONG SAID LINE TO THE SOUTH CENTER QUARTER POST OF SECTION 31 OF SAID TOWN OF UNION AND SECTION 6 OF MAGNOLIA THE LINE OF SAID SURVEY TO BE THE CENTER OF SAID HIGHWAY THENCE WEST ON THE LINE OF SAID SECTION 31 IN THE TOWN OF UNION AND SECTION SIX OF MAGNOLIA TO THE WEST LINE OF THE EAST HALF OF THE NW 1/4 OF SECTION SIX IN THE TOWN OF MAGNOLIA, LINE OF SAID SURVEY TO BE THE NORTH LINE OF SAID HIGHWAY THENCE WEST ALONG THE LINE OF SECTION 31 AND SECTION 6 OF THE TOWN OF MAGNOLIA TO THE WEST SIDE OF SAID SECTION, THE LINE OF SAID SURVEY TO BE THE CENTER OF SAID HIGHWAY AND THE SAME IS HEREBY ESTABLISHED FOUR RODS WIDE.

SHEET 1 OF 4

CORNER CODE Z-5

Emboracies Nov 10, 2014

- UN623 SECORSEC31
- 1863 LOCKE VOL 1 PG 183 FD STAKE & BEARING TREE. @ NW COR SEC 5 FD WHERE CORNER TREE HAD BEEN DUG UP. NW COR SEC 5 IS WEST 246.18 OF SW COR SEC 32. VAR7-45 2661.78 FROM NW TO SET HH 20X18X10 @ N 1/4 COR SEC 5.
- 1864 LOCKE VOL 1 PG 205 @ NE COR SEC 6 T3N R10E FD WHERE CORNER TREE HAD BEEN DUG UP. @ SE COR SEC 31 FD STAKE & BTS. SE COR SEC 31 IS EAST OF NE COR SEC 6.

 VAR7-15 2613.93 FROM NE TO N 1/4 COR SEC 6
- 1870 RUGER AUG REMON-80 EAST ON SOUTH LINE OF SW 1/4 SEC 32 ON A VAR 7-10 AT
 - 2628.12 INTERSECTED QUARTER LINE 3.3' NORTH OF QUARTER CORNER. FOUND OLD STAKE ON CORNER. ALSO FOUND STUMPS OF BOTH BEARING TREES. COR VAR 7-06

EAST ON SOUTH LINE OF SE 1/4 SEC 32 ON A VAR 6-30 OFFSET SOUTH 3.63' AT

- 2629.11 INTERSECTED EAST BOUNDARY LINE 8.58 SOUTH OF CORNER FOUND OLD STAKE AT CORNER. COR VAR 6-36
- 1870 RUGER AUG REMON-79 SOUTH ON WEST LINE OF NW 1/4 SEC 32 ON A VAZR 7-15 AT
 - 2644.62 INTERSECTED QUARTER LINE 2.64' EAST OF QUARTER CORNER. FOUND STAKE SURROUNDED BY 4 LIMESTONES. COR VAR 7-11

SOUTH ON WEST LINE OF SW 1/4 SEC 32 ON A VAR 6-16' OFFSET WEST 5.44' OFFSET WEST 5.94' OFFSET EAST 9.57' AT

- 2644.62 INTERSECTED SOUTH BOUNDARY LINE 11.88 WEST OF CORNER. FOUND STUMPS OF BOTH BEARING TREES AND ESTABLISHED CORNER FROM THEM. COR VAR 6-29
- 1870 RUGER AUG REMON-82 AUGUST 24 1870 WEST ON
 SOUTH LINE OF SE 1/4 SEC 31 ON A VAR 6-45
 OFFSET SOUTH 30.03' OFFSET NORTH 10.56' AT
 - 2627.79 INTERSECTED QUARTER LINE 11.88 SOUTH OF QUARTER CORNER. FOUND OLD STAKE AT CORNER. ALSO FOUND EAST BEARING TREE AND WHERE STUMP OF WEST BEARING TREE HAD BEEN DUG UP. COR VAR 6-55

WEST ON SOUTH LINE OF SW 1/4 SEC 31 ON A VAR 7-17' OFFSET SOUTH 34.98' OFFSET NORTH 17.82' OFFSET NORTH 15.18' OFFSET NORTH 8.58' OFFET NORTH 7.92 AT

- 2988.48 INTERSECTED WEST BOUNDARY LINE 9.9' SOUTH OF CORNER FOUND OLD STAKE AT CORNER ALSO FOUND STUMPS OF BEARING TREES. COR VAR 6-45
- 1890 BLEEDORN VOL 2 PG 439 STATES NOTHING ABOUT MON @ SE COR SEC 31. @ NW COR SEC 5 FD ROOTS OF STUMP & SET HH 18X111/2X8 @ NW COR SEC 5. NW COR IS 250.36' WEST OF SW COR SEC 32 NW COR SEC 5 TO N 1/4 COR SEC 5 IS 2665.08 & NW COR SEC 5 TO W 1/4 COR SEC 5 IS 2195.82.
- 1890 BLEEDORN VOL 2 PG 441 MON. SHOWS EAST OF NE COR SEC 6.
- 1968 BATTERMAN VOL 4 PG 364 @ NE COR SEC 6 T3N R10E FD HH 18X1 1X8 2^{\prime} DEEP. REF SAME & ON LINE WITH N/S FENCE ON SOUTH SIDE OF RD.
- 1968 BATTERMAN VOL 4 PG 365 FD LIMESTONE 1.5 DEEP & REFERENCED

SHEET 2 OF 4

CORNER CODE **Z-5**

Denbors Barnes Nov 11, 2011

- SECORSEC31 UN623
- LEE CSM VOL 3 PG 192 SET CONC MON @ NW COR SEC 5. 1973 250.26 WEST OF PIN SET @ SW COR SEC 31. ANGLE 89-25-29 @ NW COR SEC 5 FROM NORTH SEC 5 LINE TO W 1/4 COR SEC 5.
- BARNES VOL 5 PG 329 NE COR SEC 6 FD PK AND TIES. @ SE 1977 COR SEC 31 SET ALUM MON ON TOP OF STONE OF RECORD. @ CENTER OF PVMT & ON LINE WITH N/S FENCE TO THE SOUTH.
- COMBS CSM VOL 9 PG 152 FD PK 1979
- COMBS #12964 FD ALUM. MON. WEST FROM ALUM MON @ 1981 SE SEC 31. E 1/4 COR SEC 31 TO SE COR SEC 31 IS SO -08-50W 2647.26
- COMBS CSM VOL 12 PG 365 FD ALUM @ NE COR SEC 6. 1986
- SCHROEDER #11973 STATES NOTHING ABOUT MON @ NE 1991 COR SEC 6 T3N R1DE
- BARNES Z-6 S 1/16TH COR SW 1/4 SEC 32 DID NOT FIND 1991 THE NW & NE REFERENCE PIPES. FD THE SE REF PIPE *REC O.16). ALSO FD THE OLD EXCAVATION PATCH. THE PK THAT I PLACED IS 4.7' NORTH OF THE CENTER OF THE PAVEMENT. DUG 2.8' DEEP AT RECORD DISTANCE FROM THE FD REFERENCE PIPE. I STARTED AT THE SW COR OF THE PATCH & DUG A 2' WIDE HOLE UNTIL I WAS 2 NORTH OF THE CENTER OF THE PVMT & FD NOTHING. I DID NOT RESTORE COR.
- BARNES VOL 6 PG 421 FD R/R SPIKE. N89-36-04W 250.17 1991 TO FD ALUM MON @ NW COR SEC 5, S89-52-08E 2631.01 TO S 1/4 COR SEC 32.
- COMBS CSM VOL 24 PG 264 R/R SPIKE. 2634.14 TO ALUM @ 2001 S 1/4 COR SEC 31
- KARNS #16230 ROCK COUNTY SEC CORNER. S89-45W TO S 2009 1/4 COR SEC 31, NO-06-16W TO E 1/4 COR SEC 31. PIPE NO-06-16W 33.00 FROM COR.
- COMBS #16201 FD ALUM @ S 1/4 COR SEC 31 & @ NE COR 2009 SEC 6 MAGNOLIA TWP. N89-48-05E 2384.03 TO NE COR SEC 6. THENCE SO-45-52E 32.64 TO PROPERTY COR.
- @ NE COR SEC 6 FD ALUM 0.3' DEEP, 1.3' NORTH OF CENTER OF PVMT., & REFERENCE PIPES. USED MY OLD OBSERVATIONS TO COMPUTE THE POSITION OF THE SE COR SEC 31.
- C) Was the corner restored through acceptance of (1) an obliterated evidence location, or, (2) a found perpetuated location?

ACCEPTED ALUM. @ NE COR SEC 6 & CUT LIMESTONE @ SE COR SEC

D) Describe any material discrepancy between the location of the corner as restored or reestablished and the location of that corner as previously restored or reestablished by distance and direction. Show the discrepancy on the plan view drawing under (a), above. Show the distances between the corner as previously restored or reestablished and (1) the corner as restored or reestablished, and (2) to at least 4 of the witness monuments shown on the drawing in (a), above.

THERE IS A 4.42' DISCREPANCY BETWEEN HARRISON & LOCKE'S DISTANCES OF 246.18' AND THE DISTANCES FROM THE 1890s TO PRESENT. I BELIEVE THIS IS BECAUSE LOCKE FD THE ORIGINAL STAKES AND BEARING TREES AT THE NW COR SEC 5 & THE SE COR SEC 31, WHERE AS RUGER IN 1870 DID NOT FIND THE STAKE AT THE SE COR SEC 31. INSTEAD HE ESTABLISHED THE SE COR OF SEC 31 FROM STUMPS OF THE BEARING TREES. THIS POSITION WAS PROBABLY CLOSE BUT NOT EXACT.

- (E) Was the corner reestablished through lost corner proportionate methods? If so, show the method, including the directions and distances to other public land survey corners used as evidence or used for proportioning the corner location. $N\Box$
- I, Donald Barnes, hereby certify that the corner location as identified by the corner code index was determined by me under my direction and control and that this U.S. Public Land Survey Monument Record is correct and complete to the best of my knowledge and belief.

SHEET 3 OF 4

CORNER CODE Z-5

A.E. 7.08 REQUIREMENT

David Baines Nov 11,2011

