

(B) Describe any record evidence, monument evidence, occupational evidence, testimonial evidence or any other material evidence you considered, and whether the monument was found or placed.

1833 LYONS SET POST FOR CORNER TO SEC 36 OF R9E AND SEC 31 OF R10E. BUR OAK 9 N59 1/2E 23.1, WHITE OAK 12 N41W 50.82

1932 SUNNY VOL 3 PG 216 MEASURED FROM 33 SOUTH OF NORTH FENCE. NORTH FENCE SAID TO BE 33 N OF SECTION LINE.

1932 MAP #80012 ST PK 33' SOUTH OF N FENCE. SHOWS 2649.5 TO W 1/4 CORNER SECTION 31. STATES NOTHING ABOUT THE W 1/4 CORNER OF SECTION 31.

1978 TALARCZYK SECTION CORNER TIES. REFERENCED CORNER. CALLS FOR ALUMINUM MONUMENT. STATED CORNER SET BY PROPORTIONATE MEASUREMENT AND EXISTING PHYSICAL EVIDENCE.

1981 BARNES VOL 6 PG 169 FOUND ALUMINUM MONUMENT CALLS FOR 2639.71 TO S 1/4 CORNER SECTION 31 AND AN ORIG JOG DISTANCE OF 658.68.

FOUND ALUMINUM MONUMENT.



C) Was the corner restored through acceptance of (1) an obliterated evidence location, or, (2) a found perpetuated location?

ACCEPTED FOUND MONUMENT.

D) Describe any material discrepancy between the location of the corner as restored or reestablished and the location of that corner as previously restored or reestablished by distance and direction. Show the discrepancy on the plan view drawing under (a), above. Show the distances between the corner as previously restored or reestablished and (1) the corner as restored or reestablished, and (2) to at least 4 of the witness monuments shown on the drawing in (a), above.

(E) Was the corner reestablished through lost corner proportionate methods? If so, show the method, including the directions and distances to other public land survey corners used as evidence or used for proportioning the corner location.

I, Donald Barnes, hereby certify that the corner points as identified by the corner code index were, in a field survey on, Dec 11, 1991, established, re-established, monumented, re-monumented, recovered or restored as expressed below and in conformance with the regulations and rules as required in the current manual of survey instructions of the United States Department of Interior, Bureau of Land Management.

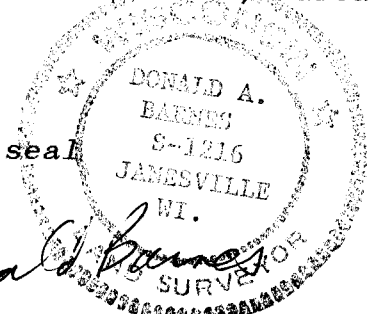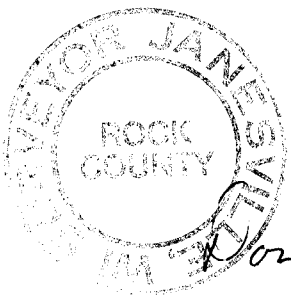

COUNTY SURVEYOR FILING DATA

Date of computer entry _____

Date microfilmed _____

Number of included sheets _____
CORNER CODE

AFFIX YOUR LAND SURVEYOR SEAL