

U.S. PUBLIC LAND SURVEY MONUMENT RECORD


For Public Land Survey Corners in the
T. 1 N., R. 10 E.

CORNER CODE INDEX

| | | | | | | | | | | | | | | | | | | | | | | | | | |
|---|---|---|---|----|----|----|----|----|----|----|----|----|----|----|----|----|----|----|----|----|----|----|----|----|----|
| | 1 | 2 | 3 | 4 | 5 | 6 | 7 | 8 | 9 | 10 | 11 | 12 | 13 | 14 | 15 | 16 | 17 | 18 | 19 | 20 | 21 | 22 | 23 | 24 | 25 |
| A | | | | | | | | | | | | | | | | | | | | | | | | | |
| B | | | | | | | | | | | | | | | | | | | | | | | | | |
| C | 6 | | | | | | | | | | | | | | | | | | | | | | | | |
| D | | 5 | | | | | | | | | | | | | | | | | | | | | | | |
| E | | | 4 | | | | | | | | | | | | | | | | | | | | | | |
| F | | | | 3 | | | | | | | | | | | | | | | | | | | | | |
| G | | | | | 2 | | | | | | | | | | | | | | | | | | | | |
| H | | | | | | | | | | | | | | | | | | | | | | | | | |
| I | 7 | | | | | | | | | | | | | | | | | | | | | | | | |
| J | | 8 | | | | | | | | | | | | | | | | | | | | | | | |
| K | | | 9 | | | | | | | | | | | | | | | | | | | | | | |
| L | | | | 10 | | | | | | | | | | | | | | | | | | | | | |
| M | | | | | 11 | | | | | | | | | | | | | | | | | | | | |
| N | | | | | | 12 | | | | | | | | | | | | | | | | | | | |
| O | | | | | | | 13 | | | | | | | | | | | | | | | | | | |
| P | | | | | | | | 14 | | | | | | | | | | | | | | | | | |
| Q | | | | | | | | | 15 | | | | | | | | | | | | | | | | |
| R | | | | | | | | | | 16 | | | | | | | | | | | | | | | |
| S | | | | | | | | | | | 17 | | | | | | | | | | | | | | |
| T | | | | | | | | | | | | 18 | | | | | | | | | | | | | |
| U | | | | | | | | | | | | | 19 | | | | | | | | | | | | |
| V | | | | | | | | | | | | | | 20 | | | | | | | | | | | |
| W | | | | | | | | | | | | | | | 21 | | | | | | | | | | |
| X | | | | | | | | | | | | | | | | 22 | | | | | | | | | |
| Y | | | | | | | | | | | | | | | | | 23 | | | | | | | | |
| Z | | | | | | | | | | | | | | | | | | 24 | | | | | | | |
| | | | | | | | | | | | | | | | | | | | 25 | | | | | | |
| | | | | | | | | | | | | | | | | | | | | 26 | | | | | |
| | | | | | | | | | | | | | | | | | | | | | 27 | | | | |
| | | | | | | | | | | | | | | | | | | | | | | 28 | | | |
| | | | | | | | | | | | | | | | | | | | | | | | 29 | | |
| | | | | | | | | | | | | | | | | | | | | | | | | 30 | |
| | | | | | | | | | | | | | | | | | | | | | | | | | 31 |
| | | | | | | | | | | | | | | | | | | | | | | | | | 32 |
| | | | | | | | | | | | | | | | | | | | | | | | | | 33 |
| | | | | | | | | | | | | | | | | | | | | | | | | | 34 |
| | | | | | | | | | | | | | | | | | | | | | | | | | 35 |
| | | | | | | | | | | | | | | | | | | | | | | | | | 36 |

PLACE MONUMENT SYMBOL (◆) AT PROPER LOCATION ON ABOVE INDEX

EXAMPLE

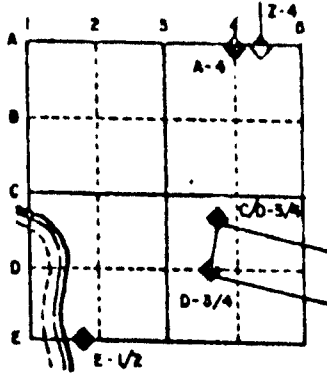

AVON TWP
ROCK COUNTY WI


IF AVAILABLE
STATE PLANE COORDINATES

North (Y) _____ Eleve. (Z) _____
 East (X) _____ Zone _____
 Hor. Datum _____ Vert. Datum _____

◆ CORNER MONUMENT

○ WITNESS MONUMENT

BEARINGS ARE BASED ON: ASSUMED

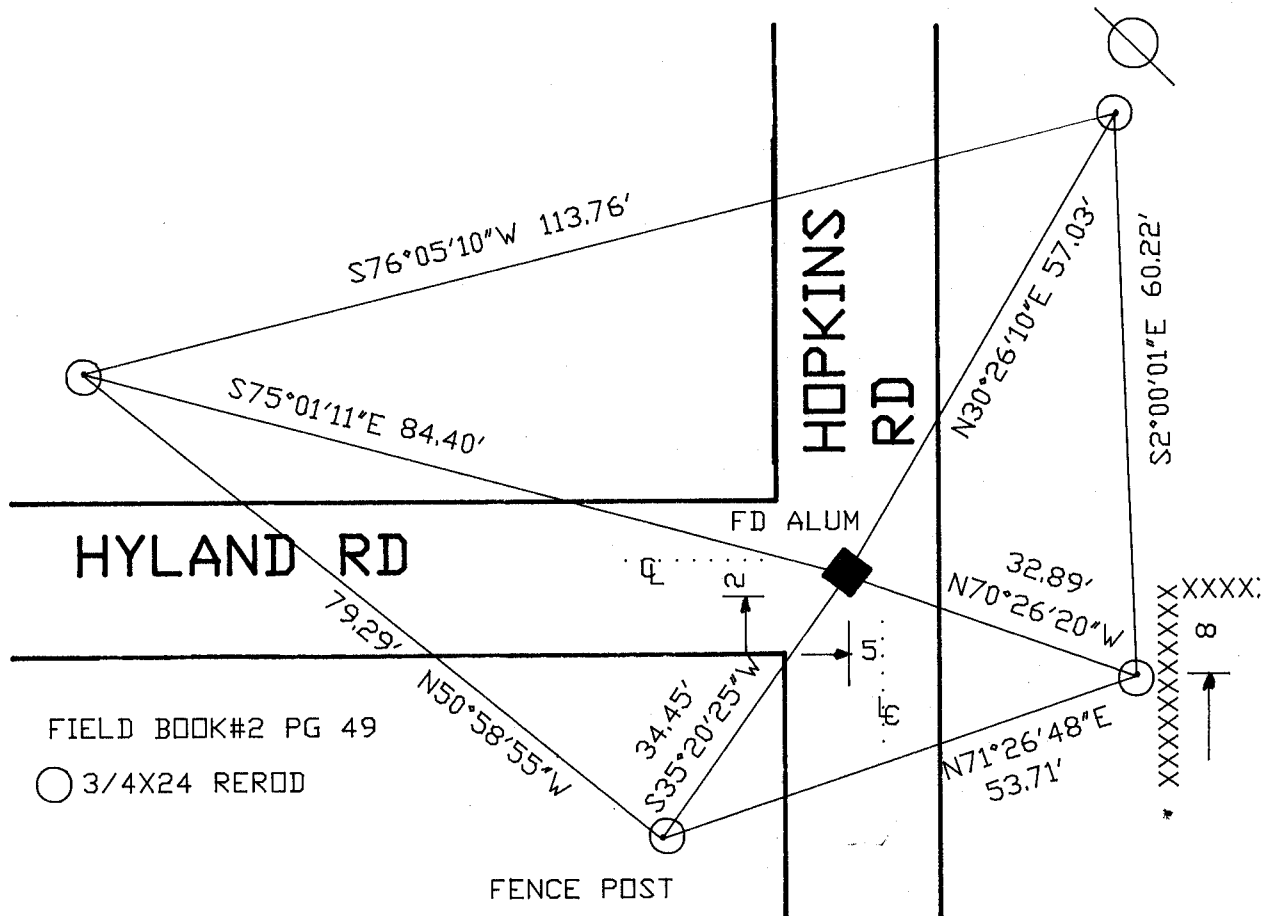

FIELD BOOK#2 PG 49

○ 3/4X24 REROD

MICROFILMED

SHEET ___ OF ___

CORNER CODE: X5

(B) Describe any record evidence, monument evidence, occupational evidence, testimonial evidence or any other material evidence you considered, and whether the monument was found or placed.

1833 HARRISON ORIGINAL SURVEYOR. SET POST FOR 1/4 SEC CORNER. POST & RAISED A MOUND.

1878 RUGER VOL 2 PG 247 FOUND REMAINS OF OLD STAKE. SET HH STONE 16X10X4 1/4 SURROUNDED BY 2 LIMESTONES, 1 SAND, & 1 HH. CALLS FOR 2671.68 TO NW CORNER, 2641.49 TO SW CORNER, AND 5256.08 TO E 1/4 CORNERS OF SECTION 32. SHOWS THAT IT IS NOT ON LINE WITH THE NW AND SW CORNERS OF SECTION 32.

1932 SUNNY VOL 3 PG 216 FOUND RUGER'S STONE SET IN 1878. STONE IS 2 1/2' BELOW SURFACE. USED TO PLACE PIPE AT CENTER OF SECTION 31.

1981 BARNES VOL 6 PG 169 CALLS FOR A DISTANCE OF 2646.49 TO THE SE CORNER OF SECTION 31.

1981 BARNES VOL 6 PG 174 FOUND 2" PIPE THAT WAS 1.5' DEEP. DROVE PIPE DEEP AND PLACED ALUMINUM MONUMENT ON TOP OF PIPE.

FOUND ALUMINUM MONUMENT AND REFERENCED SAME.


C) Was the corner restored through acceptance of (1) an obliterated evidence location, or, (2) a found perpetuated location?

ACCEPTED FOUND CORNER.

D) Describe any material discrepancy between the location of the corner as restored or reestablished and the location of that corner as previously restored or reestablished by distance and direction. Show the discrepancy on the plan view drawing under (a), above. Show the distances between the corner as previously restored or reestablished and (1) the corner as restored or reestablished, and (2) to at least 4 of the witness monuments shown on the drawing in (a), above.

(E) Was the corner reestablished through lost corner proportionate methods? If so, show the method, including the directions and distances to other public land survey corners used as evidence or used for proportioning the corner location.

I, Donald Barnes, hereby certify that the corner points as identified by the corner code index were, in a field survey on, December 16, 1991, established, re-established, monumented, re-monumented, recovered or restored as expressed below and in conformance with the regulations and rules as required in the current manual of survey instructions of the United States Department of Interior, Bureau of Land Management.

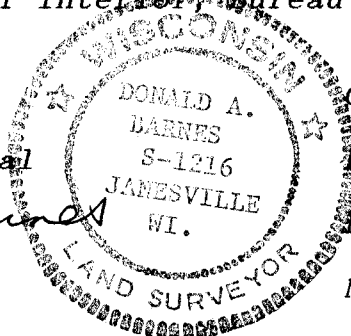

COUNTY SURVEYOR FILING DATA

Date of computer entry _____

Date microfilmed _____

Number of included sheets _____

CORNER CODE

AFFIX YOUR LAND SURVEYOR SEAL