


U.S. PUBLIC LAND SURVEY MONUMENT RECORD

For Public Land Survey Corners in the
T. 1 N., R. 10 E
CORNER CODE INDEX

| | | | | | | | | | | | | | | | | | | | | | | | | | |
|---|----|----|----|----|----|----|----|----|----|----|----|----|----|----|----|----|----|----|----|----|----|----|----|----|----|
| | 1 | 2 | 3 | 4 | 5 | 6 | 7 | 8 | 9 | 10 | 11 | 12 | 13 | 14 | 15 | 16 | 17 | 18 | 19 | 20 | 21 | 22 | 23 | 24 | 25 |
| A | | | | | | | | | | | | | | | | | | | | | | | | | |
| B | | | | | | | | | | | | | | | | | | | | | | | | | |
| C | 6 | | | | | | | | | | | | | | | | | | | | | | | | |
| D | | 5 | | | | | | | | | | | | | | | | | | | | | | | |
| E | | | 4 | | | | | | | | | | | | | | | | | | | | | | |
| F | | | | 3 | | | | | | | | | | | | | | | | | | | | | |
| G | | | | | 2 | | | | | | | | | | | | | | | | | | | | |
| H | | | | | | | | | | | | | | | | | | | | | | | | | |
| I | | | | | | | | | | | | | | | | | | | | | | | | | |
| J | | | | | | | | | | | | | | | | | | | | | | | | | |
| K | | | | | | | | | | | | | | | | | | | | | | | | | |
| L | | | | | | | | | | | | | | | | | | | | | | | | | |
| M | 18 | | | | | | | | | | | | | | | | | | | | | | | | |
| N | | 17 | | | | | | | | | | | | | | | | | | | | | | | |
| O | | | 16 | | | | | | | | | | | | | | | | | | | | | | |
| P | | | | 15 | | | | | | | | | | | | | | | | | | | | | |
| Q | | | | | 14 | | | | | | | | | | | | | | | | | | | | |
| R | | | | | | 13 | | | | | | | | | | | | | | | | | | | |
| S | | | | | | | 12 | | | | | | | | | | | | | | | | | | |
| T | | | | | | | | 11 | | | | | | | | | | | | | | | | | |
| U | | | | | | | | | 10 | | | | | | | | | | | | | | | | |
| V | | | | | | | | | | 9 | | | | | | | | | | | | | | | |
| W | | | | | | | | | | | 8 | | | | | | | | | | | | | | |
| X | | | | | | | | | | | | 7 | | | | | | | | | | | | | |
| Y | | | | | | | | | | | | | 6 | | | | | | | | | | | | |
| Z | | | | | | | | | | | | | | 5 | | | | | | | | | | | |
| | | | | | | | | | | | | | | | 4 | | | | | | | | | | |
| | | | | | | | | | | | | | | | | 3 | | | | | | | | | |
| | | | | | | | | | | | | | | | | | 2 | | | | | | | | |
| | | | | | | | | | | | | | | | | | | 1 | | | | | | | |

EXAMPLE

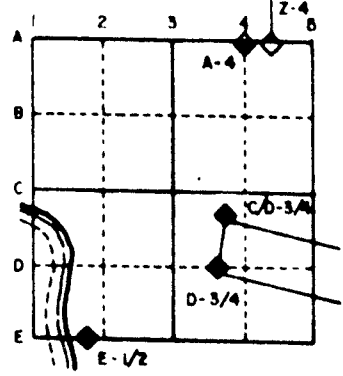

AVON TWP
ROCK COUNTY WI

IF AVAILABLE
STATE PLANE COORDINATES

North (Y) 198,502,693 Eleve. (Z) _____
 East (X) 2,165,850,195 Zone _____
 Hor. Datum _____ Vert. Datum _____

PLACE MONUMENT SYMBOL (◆) AT PROPER LOCATION ON ABOVE INDEX

- (o) ◆ CORNER MONUMENT
- WITNESS MONUMENT

COORDINATES WERE SUPPLIED BY WPL. THE SURVEY WAS BY GPS AND CONNECTED TO THREE ROCK COUNTY GPS CONTROL MONUMENTS: BROADHEAD (305S), AVON (312S), AND NEWARK EAST (313S).

NAD83(91) WISCONSIN STATE PLANE COORDINATES, SOUTH ZONE, US SURVEY FEET.

Don Barnes
2/1/95

CONVERTED 217,923.94 N/S
A 27,306.48 E/W

BEARINGS ARE BASED ON:

FIELD BOOK _____ PAGE # _____

SHOW A PLAN VIEW DRAWING DEPICTING THE CORNER MONUMENT AND SURROUNDING PHYSICAL FEATURES, INCLUDING THE EXCAVATION AREA AND DEPTH. THE CORNER MONUMENT SHALL HAVE THE FOLLOWING CHARACTERISTICS: 1) HAVE AT LEAST TWO PREDETERMINED BREAK-OFF POINTS. 2) IF BROKEN, LEAVE A PERMANENTLY MAGNETIZED REMNANT AT THE ORIGINAL POINT. 3) MUST BE EXTENDABLE. 4) THE CAP IS INSCRIBED. ROCK COUNTY SURVEY MONUMENT - PENALTY FOR DISTURBING MARKER. 5) OR AN EXISTING CUT LIMESTONE. AN IRON PIPE 1 1/2" x 4'0" (MINIMUM) MAY BE USED IN AREAS WHERE GROUND WATER IS WITHIN ONE FOOT OF THE SURFACE. IF THE CORNER IS OCCUPIED BY AN IMPROVEMENT (MANHOLE, BURIED CABLE, ETC) ANY DURABLE, DISTINCT MONUMENT MAY BE USED. CORNERS SHALL BE REFERENCED WITH AT LEAST 4 DURABLE WITNESS MONUMENTS. WITNESS MONUMENTS SHALL BE MADE OF CONCRETE, NATURAL STONE, IRON OR OTHER EQUALLY DURABLE MATERIAL, EXCEPT WOOD. DESCRIBE THE CORNER AND THE WITNESS MONUMENTS.

CORNER CODE:
N 21