

U.S. PUBLIC LAND SURVEY MONUMENT RECORD

For Public Land Survey Corners in:
T. 7 N., R. 10 E

WI ADMINISTRATIVE CODE A-E 7.08 REQUIREMENT

CORNER CODE INDEX

A	1	2	3	4	5	6	7	8	9	10	11	12	13	14	15	16	17	18	19	20	21	22	23	24	25
B	6																								
C		5																							
D			4																						
E				3																					
F					2																				
G	1																								
H		8																							
I			9																						
J				10																					
K					11																				
L						12																			
M	18						17																		
N		18						16																	
O			19						15																
P				20						14															
Q					21						13														
R						22						12													
S							23						11												
T								24						10											
U									25						9										
V										26						8									
W											27						7								
X												28						6							
Y													29						5						
Z														30						4					

AVON TWP

ROCK COUNTY WI

IF AVAILABLE
ROCK COUNTY COORDINATES PREFERRED

North _____ Elev. _____

East _____

Hor. Datum _____ Vert. Datum _____

LATITUDE _____ ELLIPS. HT. _____

LONGITUDE _____

GPS (X) _____ TRAVERSE (X) _____

BASED ON THE FOLLOWING CONTROL:

PLACE MONUMENT SYMBOL AT PROPER LOCATION ON ABOVE INDEX

CORNER MONUMENT

WITNESS MONUMENT

(a)

BEARINGS ARE BASED ON: ASSUMED


FIELD BOOK _____ PAGE # _____

SHEET _____ OF _____

SHOW A PLAN VIEW DRAWING DEPICTING THE CORNER MONUMENT AND SURROUNDING PHYSICAL FEATURES, INCLUDING THE EXCAVATION AREA AND DEPTH.

PLANNING & ZONING COMMITTEE ADOPTED THE ABOVE FORM ON 12/2/1982

CORNER CODE 0-21

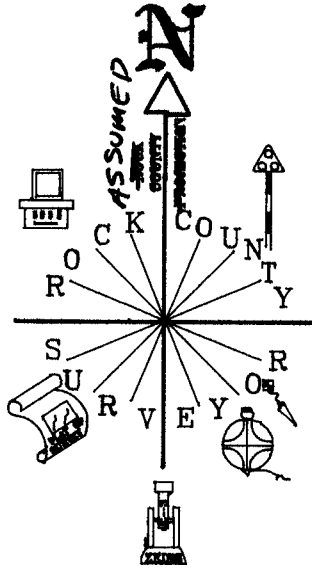


SEC 14

RUGER 2655.84
 RUGER 1871 VAR 5-22
 1327.92 RUGER 1871 1327.92
 1327.92 RUGER 1870 1327.92 VAR 5-32
 S89-34E 1329.2

S89-59-30E 2675.22
 1337.46 1337.76
 S89-59-32E S89-59-28E
 KREBS 2675.22
 1337.41 KREBS 1337.76
 1337.43 LEE 1974 1337.92
 RUGER 2667.72
 RUGER VAR 5-58
 1333.86 RUGER 1870 1333.86

SEC 13

LEE 1974 2675.35
 RUGER VAR 6-15
 RUGER 2668.72
 1334.36 RUGER 1870 1334.36

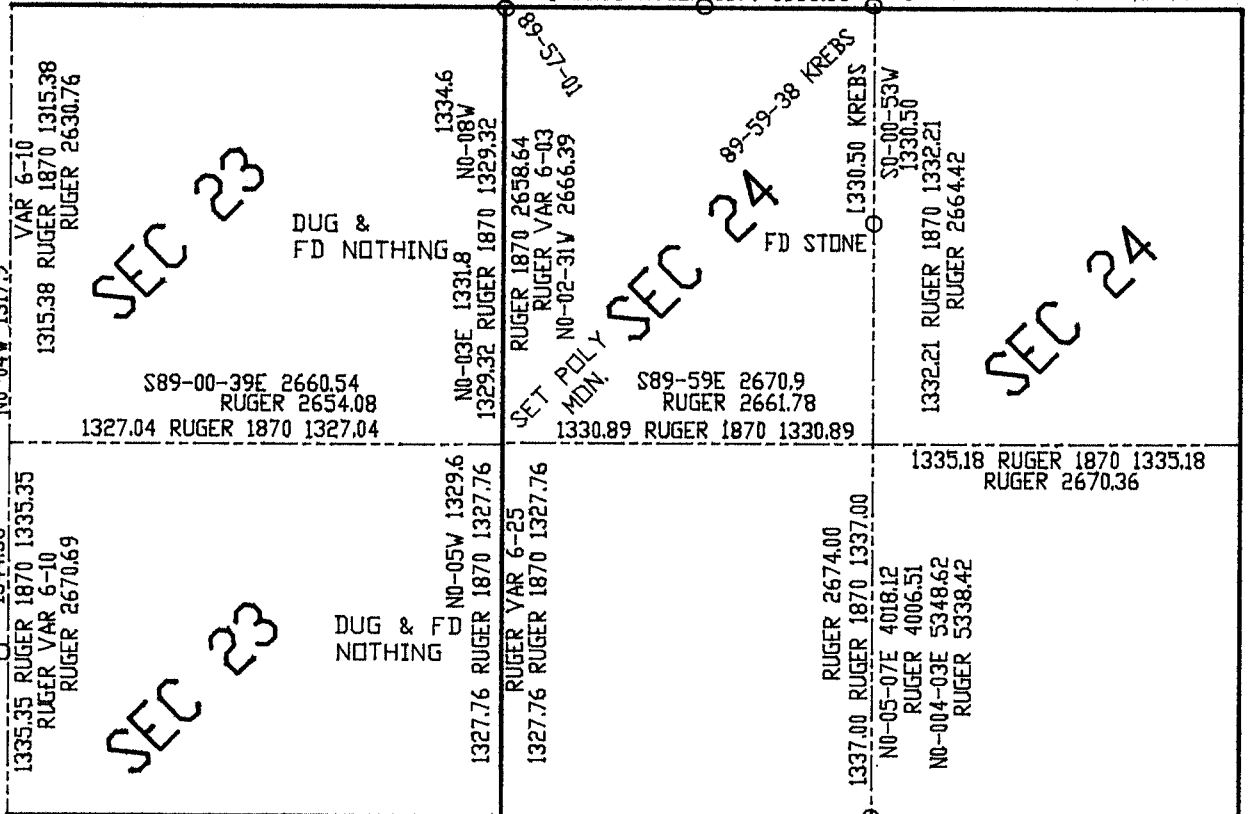

SEC 23

SEC 26

SEC 24

SEC 24

SEC 25

EMBOSSSED SEAL
Donald Barnes
 April 16, 1997