Paper weight-110# (minimum)

Black nonfading ink required

U.S. PUBLIC LAND SURVEY MONUMENT RECORD


For Public Land Survey Corners In:

WI ADMINISTRATIVE CODE A-E 7.08 REQUIREMENT

REV 10/23/2004 USMONREC.DWG

T. 4 N. R. 10 E. 4th P.M.

CORNER CODE INDEX

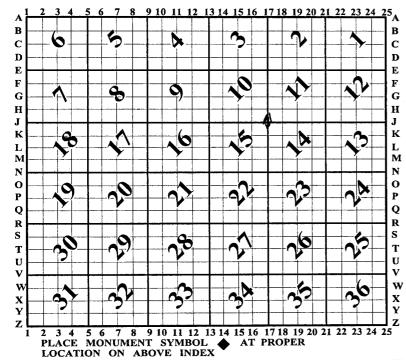

UNION TWP

IF AVAILABLE ROCK COUNTY COORDINATES PERFERRED

North	Elev
East	
Hor. Datum	Vert. Datum
LATITUDE _	ELLIPS. HT
LONGITUDE	
NAD83(91)	NETWORK ADJ. YR 2010
GPS (X)	TRAVERSE (X) X
BASED ON TH	E FOLLOWING CONTROL:

♦ CORNER MONUMENT

WITNESS MONUMENT

BEARINGS ARE BASED ON: ROCK COUNTY PROJECTION ®

FIELD BOOK PAGE #		/	4
OR OBSERVATION SHEET	SHEET		OF '
SHOW A PLAN VIEW DRAWING DEPICTING THE CORNER MONUMENT AND S	URROUN	IDING	
PHYSICAL FEATURES, INCLUDING THE EXCAVATION AREA AND DEPTH.			
PLANNING & ZONING COMMITTEE ADOPTED THIS FORM ON 12/2/1982			1

UN549 SECORSEC10

(B) Describe any record evidence, monument evidence, occupational evidence, testimonial evidence or any other material evidence you considered, and whether the monument was found or placed.

1833 HARRISON (NOV 6TH) T4N R10E 4TH MER NORTH
BETWEEN SECS 14 &15

1127.28 BURR 0 24

2640.00 QUARTER SEC COR {BURR 0 12 S69E 25.74'; BURR 0 12 N73W 39.6'; BURR 0 12 & BURR 0 12}MARKED

3475.56 ROAD & W TO DOUGHERTY S

4047.12 BURR 0 18

4719.00 ENTER THE SW ARM OF PRAIRIE

5280 COR TO SECS 10,11,14,15 SET A POST & RAISED A MOUND LAND LEVEL 2ND RATE TIMBER ?? BURR O. MOSTLY SCRUBS, GRASS, & WEEDS.

1833 HARRISON EAST ON RAND. BET SECS 11 & 14

825.0 LEAVE PRAIRIE BEARING N.E.

2640.00 TEMPY 1/4 SEC COR

4092.0 ENTER PRAIRIE

5215.98 INT E BDY 9.24' N OF P LAND ROLLING 2ND RATE & ? PRAIRIE-WHICH IS 1ST RATE TIMBER OF WOODLAND ALL BUR O.

WEST COR WEST BET SECS 11 & 14

2607.99 QUARTER SEC COR. {BURR 0 8 N8E 47.52'; BURR 0 8 N50W 51.47' BURR 0 8 & BURR 0 8}MARKED

5215.98 SEC COR

1833 HARRISON EAST ON RAND. BET SECS 10 & 15

2640.00 TEMPY 1/4 SEC COR

5215.98 INT E BDY 15.84' N OF P

LAND ROLLING 2ND RATE TIMBER MOSTLY BURR O & W.O. ??? GRUBS GRASS & WEEDS

WEST COR WEST BET SECS 16 & 15

2607.99 QUARTER SEC COR {BURR O S39E 26.4'; BURR O 12 & BURR O 12 & BURR O 12 MARKED

5215.98 SEC COR NOV 8 TH 1833

1833 HARRISON (NOV 6TH) T4N R1DE 4TH MER NORTH
BETWEEN SECS 10 & 11

1155.0 LEAVE PRAIRIE & ENTER TIMBER

2640.00 QUARTER SEC COR IN SOUTHERN EDGE OF SW ARM OF PRAIRIE {BURR 0 24 N74W 38.94'; BURR 0 18 S40E 82.5' BURR 0 24 & BURR 0 18}MARKED

4290.0 ENTER TIMBER

5280.00 COR TO SECS 2,3,10,11

{BURR 0 24 N20E 38.94'; BURR 0 20 S50E
18.48'; BURR 0 20 S45W 82.5'; BURR 0 20
N55W 27.72' LAND WET 2ND RATE WITH BURR 0
TIMBER PRAIRIE LEVEL 1ST RATE

1870 RUGER AUG REMON-100 SOUTH ON EAST LINE OF

NE 1/4 SEC 15 ON A VAR 6-50; OFFET EAST 20.46'

AT

2665.08 INTERSECTED QUARTER LINE 15.18' EAST OF QUARTER CORNER. FOUND REMAINS OF BOTH BEARING STUMPS AND ESTABLISHED QUARTER CORNER FROM THEM. COR VAR 6-57'

SOUTH ON EAST LINE OF SE 1/4 SEC 15 ON A VAR 7-00' OFFSET WEST 5.94' OFFSET EAST 15.18' OFFSET EAST 31.02'

2671.68 INTERSECTED SOUTH BOUNDARY LINE 27.72' EAST OF CORNER. COR VAR 7-16

SHEET 1 OF 4 CORNER CODE J-17(1)

Dans Mill 2011

UN549 SECORSEC10

- 1870 RUGER AUG REMON-101 EAST ON NORTH LINE OF NW 1/4
 SEC 14 ON A VAR 7-20; OFFSET SOUTH 17.82'
 AT
 - 2630.10 INTERSECTED QUARTER LINE 16.5' SOUTH OF QUARTER CORNER. FOUND OLD STAKE AT CORNER. ALSO FOUND BOTH BEARING TREES. STAKE CORRECT. COR VAR 7-18' AUGUST 31, 1870

EAST ON NORTH LINE OF NE 1/4 SEC 14 ON A VAR 7-16; OFFSET NORTH 23.1'AT

- 2623.50 INTERSECTED EAST BOUNDARY LINE 22.44 NORTH OF CORNER. FOUND REMAINS OF OLD STAKE AT CORNER. COR VAR 7-17
- 1870 RUGER AUG REMON-99 EAST ON NORTH LINE OF NW 1/4
 SEC 15 ON A VAR 6-54; OFFSET SOUTH
 11.88' OFFSET SOUTH 7.26' AT
 - 2614.26 INTERSECTED QUARTER LINE 23.76 SOUTH OF QUARTER CORNER. FOUND REMAINS OF STUMPS OF BOTH BEARING TREES. ESTABLISHED QUARTER CORNER FROM THEM. COR VAR 6-52

 EAST ON NORTH LINE OF NE 1/4 SEC 15

 ON A VAR 7-55; OFFSET NORTH 12.54 OFFSET NORTH 11.22 AT
 - 2610.30 INTERSECTED EAST BOUNARY LINE 78.54 NORTH OF CORNER. FOUND REMAINS OF OLD STAKE AT CORNER. COR VAR 6-44
- 1870 RUGER AUG REMON-111 SOUTH ON WEST LINE OF NW 1/4 SEC 11 ON A VAR 7-00'AT
 - 2661.45 INTERSECTED QUARTER LINE 2.97' EAST OF QUARTER CORNER. FOUND OLD STAKE AT CORNER. ALSO FOUND STUMPS OF BOTH BEARING TREES. COR VAR 6-56

NORTH ON WEST LINE OF SW 1/4 SEC 11 ON A VAR 7-OO; OFFSET EAST 5.28' OFFSET WEST 25.08' OFFSET WEST 5.28' AT

- 2658.48 INTERSECTED SOUTH BOUNDARY LINE 22.44'
 WEST OF CORNER. COR VAR 6-57'
- 1957 BATTERMAN VOL 3 PG 516 FD CUT STONE 2613.69 TO CENTER OF HWY OR COR WHICH IS 9.04 WEST.
- 1975 GREENLIE CSM VOL 4 PG 360 COUNTY SURVEYOR MON.
- 2009 COMBS J-17 FD CUT LIMESTONE OF RECOR. SO-15-05W 2672.91 TO PK NAIL @ E 1/4 COR SEC 15. @ FENCE INT. REFERENCED SAME.
- 2009 COMBS CSM VOL 33 PG 35 CUT LS USED FOR LINE. S0-15-05W 2671.91 TO SET R/R SPIKE @ E 1/4 COR SEC 15
- 2009 COMBS #16188 FD CUT STONE. N89-21-05W 2613.78 TO SET PK @ N 1/5 COR SEC 15 & SO-15-05W TP FD RR SPIKE @ E 1/4 COR SEC 15

FD CUT LIMESTONE.

SHEET 2 OF 4

CORNER CODE J-17(1)

Empares Nov 1, 2011

UN549 SECORSEC10

C) Was the corner restored through acceptance of (1) an obliterated evidence location, or, (2) a found perpetuated location?

ACCEPTED FD CUT LIMESTONE.

D) Describe any material discrepancy between the location of the corner as restored or reestablished and the location of that corner as previously restored or reestablished by distance and direction. Show the discrepancy on the plan view drawing under (a), above. Show the distances between the corner as previously restored or reestablished and (1) the corner as restored or reestablished, and (2) to at least 4 of the witness monuments shown on the drawing in (a), above.

NONE

(E) Was the corner reestablished through lost corner proportionate methods? If so, show the method, including the directions and distances to other public land survey corners used as evidence or used for proportioning the corner location.

NO

I, **Donald Barnes**, hereby certify that the corner location as identified by the corner code index was determined by me under my direction and control and that this U.S. Public Land Survey Monument Record is correct and complete to the best of my knowledge and belief.

SHEET 3 OF 4

CORNER CODE J-17(1)

A.E. 7.08 REQUIREMENT

