

Paper weight-110# (minimum)

Black nonfading ink required

# U.S. PUBLIC LAND SURVEY MONUMENT RECORD

For Public Land Survey Corners In:

WI ADMINISTRATIVE CODE A-E 7.08 REQUIREMENT

T.4 N. R. 10 E. 4th P.M.

REV 10/23/2004

USMONREC.DWG

CORNER CODE INDEX

UNION

TWP

ROCK COUNTY WI

IF AVAILABLE

ROCK COUNTY COORDINATES PREFERRED

	1	2	3	4	5	6	7	8	9	10	11	12	13	14	15	16	17	18	19	20	21	22	23	24	25	
A																										A
B																										B
C																										C
D																										D
E																										E
F																										F
G																										G
H																										H
J																										J
K																										K
L																										L
M																										M
N																										N
O																										O
P																										P
Q																										Q
R																										R
S																										S
T																										T
U																										U
V																										V
W																										W
X																										X
Y																										Y
Z																										Z

North \_\_\_\_\_ Elev. \_\_\_\_\_

East \_\_\_\_\_

Hor. Datum \_\_\_\_\_ Vert. Datum \_\_\_\_\_

LATITUDE \_\_\_\_\_ ELLIPS. HT. \_\_\_\_\_

LONGITUDE \_\_\_\_\_

NAD83(91) \_\_\_\_\_ NETWORK ADJ. YR 2010

GPS (X) \_\_\_\_\_ TRAVERSE (X) X

BASED ON THE FOLLOWING CONTROL:

1 2 3 4 5 6 7 8 9 10 11 12 13 14 15 16 17 18 19 20 21 22 23 24 25  
PLACE MONUMENT SYMBOL  AT PROPER LOCATION ON ABOVE INDEX

CORNER MONUMENT

WITNESS MONUMENT

BEARINGS ARE BASED ON: ROCK COUNTY PROJECTION

FIELD BOOK \_\_\_\_\_ PAGE # \_\_\_\_\_

OR OBSERVATION SHEET \_\_\_\_\_

SHEET 1 OF 3

SHOW A PLAN VIEW DRAWING DEPICTING THE CORNER MONUMENT AND SURROUNDING PHYSICAL FEATURES, INCLUDING THE EXCAVATION AREA AND DEPTH.

PLANNING & ZONING COMMITTEE ADOPTED THIS FORM ON 12/2/1982

CORNER CODE N-19(1)

UN570 N1/4CORSEC23

(B) Describe any record evidence, monument evidence, occupational evidence, testimonial evidence or any other material evidence you considered, and whether the monument was found or placed.

- 1833 HARRISON (NOV) T4N R10E 4<sup>TH</sup> MER. EAST ON RAMDOM  
BET 14 & 23  
2640.00 TEMPY 1/4 SEC COR  
5243.70 INT. E AT POST LAND & ???  
WEST COR-WEST BET SECS 14 & 23  
2621.85 QUARTER SEC COR {BURR O 14 S2W 50.16';  
BURR O 18 N70W 26.4' BURR O 14 & BURR O  
18} MARKED  
4162.62 BURR O 18 IN. DIAM  
5243.70 INT. SEC COR NOV 6TH 1833
- 1870 RUGER AUG REMON-74 WEST ON NORTH LINE OF NE 1/4  
SEC 23 ON A VAR 7-06 OFFSET NORTH 15.18'  
OFFSET SOUTH 42.24' AT  
2635.54 INTERSECTED QUARTER LINE 33.66' SOUTH OF  
QUARTER CORNER. FOUND OLD STAKE AT  
CORNER. COR VAR 6-58  
WEST ON NORTH LINE OF NW 1/4 SEC 23  
ON A VAR 8-15 OFFSET NORTH 15.18' AT  
2626.14 INTERSECTED WEST BOUNDARY LINE 23.1' SOUTH  
OF CORNER. FOUND REMAINS OF STUMPS OF 3  
BEARING TREES. ESTABLISHED CORNER FROM  
BEARING TREES. COR VAR 7-25
- 1875 RUGER VOL 2 PG 201 STONE MON. USED TO SUBDIVIDE  
SEC 23. VAR 6-38 2630.10 TO NW COR SEC 23, VAR5-40  
2655.84 TO CENTER OF SEC 23, & VAR5-40 5310.36 TO S  
1/4 COR SEC 23
- 1884 RUGER VOL 2 PG 294 STATES NOTHING ABOUT MON. USED  
TO SUBDIVIDE SEC 23. 2638.02 TO NE COR SEC 32
- 1972 COMBS GSM VOL 2 PG 334 FD CUT LS  
1975 COMBS GSM VOL 4 PG 350 STONE MON.  
1980 GRENLIE CSM VOL 9 PG 298 FD CUT STONE.  
1980 GRENLIE CSM VOL 10 PG 130 FD CUT STONE SOUTH 785.43  
TO CENTER OF RD.  
1989 GRENLIE CSM VOL 13 PG 508 STATES NOTHING ABOUT  
MON  
1997 MARKS N-19 FD A 6X6 CUT STONE MONUMENT. @ FENCE  
INT. REFERENCED SAME. GPS LAT 42-48-08.0152216;  
LONGITUDE 89-16-46.12969874 BASED ON EVANSVILLE  
STATION. 293,224.386; 2,161,867.171'
- 1997 COMBS P32-400 "STONERIDGE MANOR FIRST ADDITION" LS.  
5322.69 TO LS @ S 1/4 COR SEC 23  
1999 COMBS GSM VOL 22 PG 326 FD CUT STONE 5322.62 TO FD  
CUT STONE @ S 1/4 COR SEC 23  
1999 COMBS #7453 FD CUT STONE. N89-56-40E 2640.30 TO FD  
PIPE @ NE COR SEC 23, & SOUTH 5322.62 TO CUT STONE  
@ S 1/4 COR SEC 23. SOUTH 746.04 TO SET PIN ON  
NORTH R/W LINE OF TERRITORIAL RD  
2000 KARNS P32-483 "PINE KNOLL ESTATES" 6X6 STONE MON. SO-  
07-22W 5322.60 TO CUT STONE @ S 1/4 COR SEC 23  
2004 COMBS GSM VOL 27 PG 146 CUT STONE 2640.48 TO IRON  
PIPE @ NE COR SEC 23  
2004 HOLE CSM VOL 28 PG 51 FD CUT STONE. N89-57-01E  
2640.37 TO 1" PIPE @ SEC COR SEC 14

  
SEAL

Emboss

SHEET 1 OF 3

CORNER CODE N-19(1)

UN570 N1/4CORSEC23

FD CUT LIMESTONE 0.1' ABOVE GRADE /CARSONITE POST ON WEST SIDE OF L.S.

C) Was the corner restored through acceptance of (1) an obliterated evidence location, or, (2) a found perpetuated location?

ACCEPTED FD CUT L.S.

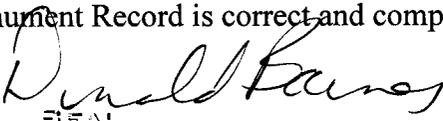
D) Describe any material discrepancy between the location of the corner as restored or reestablished and the location of that corner as previously restored or reestablished by distance and direction. Show the discrepancy on the plan view drawing under (a), above. Show the distances between the corner as previously restored or reestablished and (1) the corner as restored or reestablished, and (2) to at least 4 of the witness monuments shown on the drawing in (a), above.

NONE

(E) Was the corner reestablished through lost corner proportionate methods? If so, show the method, including the directions and distances to other public land survey corners used as evidence or used for proportioning the corner location.

NO

I, **Donald Barnes**, hereby certify that the corner location as identified by the corner code index was determined by me under my direction and control and that this U.S. Public Land Survey Monument Record is correct and complete to the best of my knowledge and belief.

  
SEAL  
May 27, 2011  
Emilio

SHEET 2 OF 3

CORNER CODE N-19(1)

A.E. 7.08 REQUIREMENT

