Paper weight-110# (minimum)

Black nonfading ink required

Black nonfa LAND U.S. PUBLIC SURVEY MONUMENT RECORD


For Public Land Survey Corners In:

WI ADMINISTRATIVE CODE A-E 7.08 REQUIREMENT

REV 10/23/2004 HSMONREC DWG

T. 4 N. R. 10 E. 4th P.M.

CORNER CODE INDEX

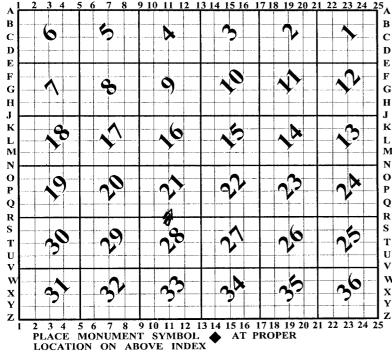

UNION ROCK COUNTY WI

IF AVAILABLE ROCK COUNTY COORDINATES PERFERRED

North Elev. Hor. Datum _____ Vert. Datum **LATITUDE** ELLIPS. HT. LONGITUDE NAD83(91) _____NETWORK ADJ. YR 2010 GPS (X) ____ TRAVERSE (X) X BASED ON THE FOLLOWING CONTROL:

◆ CORNER MONUMENT

WITNESS MONUMENT

(a) ROCK COUNTY PROJECTION BEARINGS ARE BASED ON:

FIELD BOOK

UN586 N1/4CORSEC28

(B) Describe any record evidence, monument evidence, occupational evidence, testimonial evidence or any other material evidence you considered, and whether the monument was found or placed.

1833 HARRISON TAN RIOE 4TH MER EAST BET. SECS 21 & 28

2640.00 TEMPY 1/4 SEC COR

5272.08 INT. E BDY 4.62 S OF P LAND ROLLING 2ND RATE TIMBER ?? RED O ???

WEST COR WEST BET 21 & 28

ON NORTH LINE OF NW 1/4 ON VAR AS ABOVE

2636.04 QUARTER SEC COR {RED 0 10 S64E 33.66'; RED 0 12 N53E 13.20' RED 0 10 & RED 0 12}MARKED

5272.08 SEC COR

1870 RUGER AUG REMON-76 WEST ON NORTH LINE OF NE 1/4

SEC 28 ON A VAR 7-00 COULD FIND NO TRACE

OF QUARTER CORNER. IT HAVING BEEN PLACED

CONCIDERABLY TOO FAR EAST BY THE U.S.

SURVEYORS AND SUBSQUENTLY DESTROYED IN

CONSIQUENCE BY PARTIES INTERESTED AS I

WAS CREDIBLY INFORMED. CONTINUED WEST

GIVEN AT

5277.36 INTERSECTED WEST BOUNDARY LINE AT CORNER. ESTABLISHED NORTH QUARTER CORNER AT A POINT IN A TRUE LINE BETWEEN AND EQUIDISTANT FROM THE NE & NW CORNERS OF SAID SECTION. IT BEING 2638.68 DISTANT FROM EACH.

- 1890 BLEEDORN VOL 2 PG 431MON 2640.00 TO SW COR SEC 21. USED TO SUBDIVIDE SEC 21
- 1899 BROWN VOL 2 PG 512 MON. USED TO SUBDIVIDE SEC 21
- 1942 SUNNY #5219 STATES NOTHING ABOUT MON. SHOWS IT ON NORTH SIDE OF CTH C
- 1966 BATTERMAN VOL 4 PG 289 FD STONE. REFER. SAME.
 NORTH SIDE OF CTH C. 2642.78 TO FD STONE @ NE COR
 SEC 28 & 2642.78 TO NW COR SEC 28
- 1966 LEE #5218 FD CUT STONE MON. 2642.76 TO CUT STONE @ NE COR SEC 28
- 1967 BATTERMAN VOL 4 PG 325 FD CUT STONE.
- 1968 BATTERAN VOL 4 PG 385 CUT STONE MON. REFER. SAME.
 NOTE: ALL BEARINGS ARE TURE NORTH. 543.30 FROM PIPE
 @ CENTER OF BROOKLYN-EVANSVILLE RD.
- 1968 THOM FD CUT STONE MON. WEST 210.26 TO POB A 1" PIPE 543.30' EAST OF A 1" PIPE IN THE INTERSECTION OF BROOKLYN-EVANSVILLE RD & CTH C
- 1969 JENSEN ASSESSORS PLAT SHEET 6 SUB #2183 STONE.

 EASTERLY 1321.00 TO FD PIPE (2.08 W & 0.27N) THENCE

 EASTERLY 1321.12 TO STONE @ NE COR SEC 28. FROM N

 1/4 COR SEC 28 SOUTHERLY 1336.05 TO SET PIPE (4' N &

 12' E OF FD COR.) THENCE SO-28E 1336.05 TO CONC. MON.

 @ CENTER OF SEC 28; THENCE SOUTHERLY 139.53 TO PIPE.

 USED STONE @ S 1/4 COR SEC 28 FOR LINE.
- 1971 THOM CSM VOL 2 PG 17 FD CUT STONE. WEST 280.26 TO PIPE IN CTH C
- 1971 COMBS CSM VOL 2 PG 206 STATES NOTHING ABOUT MON. SOUTH 65.14 TO CENTER OF RD.
- 1973 COMBS CSM VOL 3 PG 90 FD STONE.
- 1977 SCHROEDER CSM VOL 7 PG 24 STATES NOTHING. WEST 543.30 TO CENTER OF N/S RD
- 1979 KIENBAUM VOL 5 PG 523 FD STONE 2.6 DEEP. REF SAME.
- 1982 BARNES R-11 FD CUT LIMESTONE 3' DEEP AS CALLED FOR BY CSM VOL 7 PG 94. REFERENCED SAME. ON NORTH SIDE OF CTH C & NORTH OF NORTH R/W FENCE.
- 1982 BARNES P-9 NO-16-49W 2658.93 TO COMPUTED POINT ON N/S LINE. 5318.69 TO N 1/4 COR SEC 21
- 1982 BARNES VOL 6 PG 288 WEST 2643.06 TO SW COR SEC 21 SHEET 1 OF 3

CORNER CODER R-11(1)

Sept 2011

UN586 N1/4CORSEC28

1996 KARNS CSM VOL 19 PG 104 ROCK SEC. COR. WEST 543.30 TO CENTER OF RD.

2007 COMBS CSM VOL 31 PG 304 FD PIN. 2643.06 TO FD PK @ SW COR SEC 21

2008 COMBS CSM VOL 32 PG 265 FD IRON PIN 2643.05 TO FD R/R SPIKE @ SW COR SEC 21

2011 DELONG #???? COUNTY MONUMENT FOUND PER TIES. 2643.12 TO R.R. SPIKE @ SW COR SEC 21.

FD CUT LIMESTONE 2.5' DEEP. PLACED ON EAST & NORTH SIDE OF CUT LIMESTONE. LS IS IN FARM FIELD.

C) Was the corner restored through acceptance of (1) an obliterated evidence location, or, (2) a found perpetuated location?

ACCEPTED FD LS.

D) Describe any material discrepancy between the location of the corner as restored or reestablished and the location of that corner as previously restored or reestablished by distance and direction. Show the discrepancy on the plan view drawing under (a), above. Show the distances between the corner as previously restored or reestablished and (1) the corner as restored or reestablished, and (2) to at least 4 of the witness monuments shown on the drawing in (a), above.

NONE

(E) Was the corner reestablished through lost corner proportionate methods? If so, show the method, including the directions and distances to other public land survey corners used as evidence or used for proportioning the corner location.

RUGER PLACED LS MIDWAY & ON LINE WITH THE SE & SW CORNERS OF SEC 21.

I, **Donald Barnes**, hereby certify that the corner location as identified by the corner code index was determined by me under my direction and control and that this U.S. Public Land Survey Monument Record is correct and complete to the best of my knowledge and belief.

ELEAL

SHEET 2 OF 3

Sep 2 2011

CORNER CODE R-11(1)

A.E. 7.08 REQUIREMENT

