
## U.S. PUBLIC LAND SURVEY MONUMENT RECORD

For Public Land Survey Corners in:

WI ADMINISTRATIVE CODE A-E 7.08 REQUIREMENT

T. 4N., R. 10E

CORNER CODE INDEX

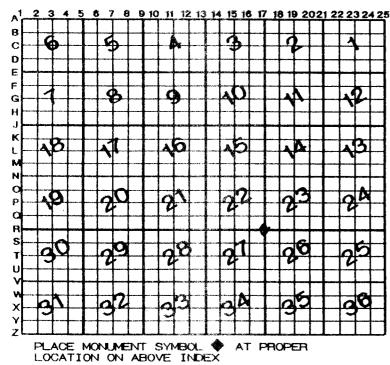

UNIC	TWI	
ROCK	COUNTY	WI

IF AVAILABLE HOCK COUNTY COORDINATES PERFERRED

North	Elev,
East	
Hor. Datum	Vert. Datum
LATITUDE	ELLIPS. H
LONGITUTE	
GPS (X)	TRAVERSE (X)
BASED ON THE	FOLLOWING CONTROL:

♦ CORNER MONUMENT

O WITNESS MONUMENT

BEARINGS ARE BASED ON:

(a)

		. ,		7
FIELD BOOKPAGE #	SHEET		OF	
SHOW A PLAN VIEW DRAWING DEPICTING THE CORNER MONUMENT ANI	D SURRO	UNDING		
PHYSICAL FEATURES, INCLUDING THE EXCAVATION AREA AND DEPTH.				
PLANNING & ZONING COMMITTEE ADOPTED THE ABOVE FORM ON 12/2/1982				

## UN589

- (B) Describe any record evidence, monument evidence, occupational evidence, testimonial evidence or any other material evidence you considered, and whether the monument was found or placed.
- 1870 RUGER REMONUMENTATION PG 68 SOUTH ON WEST NW 1/4 SEC 26 ON A VAR 8-00 AT 2662.66' INTERSECTED QUARTER LINE 9.9' EAST OF QUARTER COR. CORRECTED VAR 7-47 AUG 19, 1870
  PG 67 WEST ON NORTH LINE OF NW 1/4 SEC 26 ON A VAR 6-58 OFFSET NORTH 15.18'. OFFSET SOUTH 33' AT 2650.56 INTERSECTED WEST BOUNDARY LINE 11.22' SOUTH OF COR. FOUND REMAINS OF OLD STAKE ALSO FD SOUTH BEARING TREE & REMAINS OF STUMP OF NORTH BT CORRECTED VAR 7-07
  PG 97 SOUTH ON WEST LINE OF SW 1/4 SEC 23 ON A VAR 6-55 AT 2649.9 INTERSECTED SOUTH BOUNDARY LINE AT COR.
  PG 98 WEST ON NORTH LINE OF NE 1/4 SEC 27 ON A VAR 7-00 OFFSET NORTH 14.52' AT 2616.9 INTERSECTED QUARTER LINE 19.14' NORTH OF QUARTER COR. FD STAKE SURROUNDED BY HH STONES SET BY LOCKE AT COR. ALSO FD STUMPS OF BTS TESTED & FOUND IT CORRECT. CORRECTED VAR 7-06
- 1875 RUGER VOL 2 PG 201 STONE MON. VAR 6-05 2650.56 TO S  $^{14}$  COR SEC 23 & VAR 5-54 2651.88 TO W  $^{14}$  COR SEC 23.
- 1882 RUGER VOL 2 PG 398 STATES NOTHING ABOUT COR. VAR 6-00 2663.10 TO E 1/4 COR SEC 27.
- 1882 RUGER VOL 2 PG 397 STATES NOTHING ABOUT COR. 2652.41 TO N  $^{1}\!\!/_{\!\!\!4}$  COR SEC 26
- 1938 SUNNY VOL 3 PG 389 FD STONE MON AT SW COR SEC 23. N4-OW 2655.7 TO E  $\frac{1}{4}$  COR SEC 22. PENCILED IN: PIPE BY BJ. 2'W, 16.5 EAST OF N/S FENCE, 43 WEST N/S FENCE.
- 1938 SUNNY VOL 3 PG 405 FD STONE MON. GRADED OUT BY C.H. DEPT IN 1929; RESET MON BY PROPORTIONATE MEASUREMENTS. MON 43 FROM E FENCE & 16 ½ FROM W. FENCE. (PENCILED IN -PIPE BY B.J.S 2' WEST). NOTE: SEE PG 389 2655.7 TO E ¼ COR SEC 22, 2668.4 TO E ¼ COR SEC 27, 2657 TO S ¼ COR SEC 23, & 2623.2 TO S ¼ COR SEC 22.
- 1977 BARNES VOL 5 PG 236 FD CUT L.S. & REFERENCED SAME. 3.5 WEST OF WEST PVMT EDGE
- 1985 BARNES VOL 6 PG 337 & 340 MAPS SHOWS FOLLOWING RECORD DISTANCES: TO S ¼ COR SEC 22 S88-46W 2619, SUNNY 1938 2623.2, RUGER 2616.90, ORIG 2607. TO E ¼ COR SEC 22 NO-27-33W 2655.90, SUNNY 2655.7 TO E ¼ COR SEC 27 KERCH 1907 2667.4, SUNNY 1938 2668.4, RUGER 1882 2663.10, RUGER 1870 2662.52, TO E 1/16 OF NE ¼ COR SEC 27 S1-27-22E 1334.79. TO S ¼ COR SEC 23 N89-33-08E 2656.99, KERCH 1907 2655.1, SUNNY 1938 2657, RUGER 1875 2650.56, RUGER 1883 2652.41, RUGER 1870 2650.56, ORIG 2623.50 FROM E 1/16<sup>TH</sup> OF NE ¼ COR SEC 27 TO SE COR SEC 27 S1-23-15E 1333.84
- 1985 BARNES R17 FOUND CUT LIMESTONE & REFERENCED SAME.

FOUND CARSONITE POST, CUT LIMESTONE 0.9' DEEP WITH TOP PARTIALLY BROKE OFF & PIPE 2.01 TO THE WEST. PLACED MAGNETS 1.6 DEEP ON SE SIDE OF STONE.

C) Was the corner restored through acceptance of (1) an obliterated evidence location, or, (2) a found perpetuated location?

## ACCEPTED FOUND STONE.

D) Describe any material discrepancy between the location of the corner as restored or reestablished and the location of that corner as previously restored or reestablished by distance and direction. Show the discrepancy on the plan view drawing under (a), above. Show the distances between the corner as previously restored or reestablished and (1) the corner as restored or reestablished, and (2) to at least 4 of the witness monuments shown on the drawing in (a), above.

I, Donald Barnes, hereby certify that the corner location as identified by the corner code index was determined by me under my direction and control and that this U.S. Public Land Survey Monument Record is correct and complete to the best of my knowledge and belief.

Seal

Indestaires Emiliose 05/08/00

Number of included sheets 1

CORNER CODE R-17(1)

**A-E 7.08 REQUIREMENT** 

