
## U.S. PUBLIC LAND SURVEY MONUMENT RECORD

For Public Land Survey Corners in:

WI ADMINISTRATIVE CODE A-E 7.08 REQUIREMENT

T.4N, R. 10E

CORNER GODE INDEX

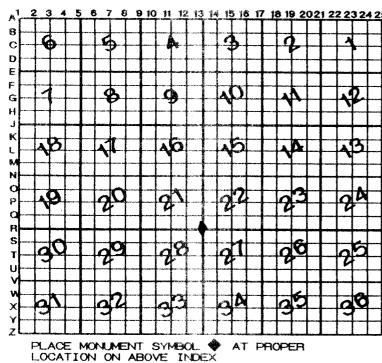

UNIC	N	TWP
ROCK	COUNTY	WI

IF AVAILABLE ROCK COUNTY COORDINATES PERFERRED

North		INVESTIGATION AND	Ele	v		
East	distribution (April 1 de servi					
Hor. Da	tum		Vert. Da	itum .	***************************************	******
LATITU	DE			ELLI	IPS.	Н
LONGIT	UTE	Ξ.				
GPS ()	<b>()</b>		TRAVERS	E (X)		
ASED C	N	THE	FOLLOWING (	CONTE	ROL:	

♦ CORNER MONUMENT

O WITNESS MONUMENT

BEARINGS ARE BASED ON:

(a)

FIELD BOOK \_\_\_\_\_PAGE # \_\_\_\_\_ SHEET \_\_\_\_ OF SHOW A PLAN VIEW DRAWING DEPICTING THE CORNER MONUMENT AND SURROUNDING PHYSICAL FEATURES, INCLUDING THE EXCAVATION AREA AND DEPTH.
PLANNING & ZONING COMMITTEE ADOPTED THE ABOVE FORM ON 12/2/1982

## **UN587**

- (B) Describe any record evidence, monument evidence, occupational evidence, testimonial evidence or any other material evidence you considered, and whether the monument was found or placed.
  - RUGER REMONUMENTATION PG 96 NORTH ON EAST LINE OF SE 1/4 SEC 21 ON A VAR 7-00 OFFSET EAST 6.93' AT 2665.74 INTERSECTED 1/4 LINE 6.6' WEST OF 1/4 COR FD BOTH BEARING STUMPS & ESTABLISHED 1/4 COR FROM THEM. CORRECTED VAR 6-43 NORTH ON EAST LINE OF NE 1/4 SEC 21 ON A VAR 7-00 AT 2658.64 INTERSECTED NORTH BOUNDARY LINE 1.98' EAST OF COR. CORRECTED VAR 7-02. PG 98 WEST ON NORTH LINE OF NE 1/4 SEC 27 ON A VAR 7-00 OFFSET NORTH 14.52' AT 2616.9' INTERSECTED QUARTER LINE 19.14' NORTH OF QUARTER CORNER, FOUND STAKE SURROUNDED BY HH STONES SET BY LOCKE AT CORNER. ALSO FOUND STUMPS OF BEARING TREES. TESTED STAKE & FOUND IT CORRECT. CORRECTED VAR 7-06 WEST ON NORTH LINE OF NW 1/4 SEC 27 ON A VAR 7-00 AT 2632.08'INTERSECTED WEST BOUNDARY LINE 6.6' NORTH OF COR. CORRECTED VAR 7-09 PG 71 NORTH ON WEST LINE OF SW 1/4 SEC 27 ON A VAR 7-20 OFFSET EAST 3.96' AT 2659.47' INTERSECTED 1/4 LINE 9.9' EAST OF 1/4 COR. FD STONE ON COR ALSO FO RENAINS OF BOTH BEARING TREE STUMPS. CORRECTED VAR 7-28. PG 75 NORTH ON WEST LINE OF NW 1/4 SEC 27 ON A VAR 7-50 OFFSET EAST 2.64' AT 2670.69 INTERSECTED NORTH BOUNDARY LINE 22.44' EAST OF COR. FD REMAINS OF OLD STAKE. ALSO FD STUMPS OF BOTH BEARING TREES. CORRECTED VAR 8-15. PG 76 WEST ON NORTH LINE OF NE 1/4 SEC 28 ON A VAR 7-00 COULD FIND NO TRACE OF 1/4 COR.IT HAVING BEEN PLACED CONSIDERABLY TOO FAR EAST BY THE U.S. SURVEYORS & SUBSEQUENTLY DESTROYED IN CONSEQUENCE BY PARTIES INTERESTED AS I WAS CREDIBLY INFORMED. CONTINUED WEST ON NORTH LINE OF NW 1/4 ON VAR AS ABOVE GIVEN AT 5277.36 INTERSECTED WEST BOUNDARY LINE AT COR. ESTABLISHED NORTH 1/4 COR AT A POINT ON A TRUE LINE BETWEEN & EQUAL DISTANT FROM THE NE & NW CORNERS OF SAID SEC IT BEING 2638.68 DISTANT FROM EACH.
- 1893 BLEEDORN VOL 2 PG 431 CALLS FOR A MON. & 2640.00 TO E ¼ COR SEC 21 & 2642.64 TO S ¼ COR SEC 21.
- 1899 BROWN VOL 2 PG 512 CALLS FOR A MON. & 2643.80 TO S  $\frac{1}{4}$  COR SEC 21.
- 1966 BATTERMAN VOL 4 PG 289 FD STONE. 2642.78 TO S ¼ COR SEC 21 & 5285.56 TO SW COR SEC 21.
- 1967 BATTERMAN VOL 4 PG 325 FD CUT STONE & 1321.38 TO THE N  $1/16^{\text{TH}}$  COR OF THE NE 1/4 OF SEC 28.
- 1982 BARNES VOL 6 PG 288 SHOWS RECORD DISTANCES: RUGER 2665.74 & BLEEDORN 2666.40 TO W1/4 COR SEC 22 & BROWN 2643.79 & ORIG 2636.04 TO S1/4 COR SEC 21.
- 1984 GENSKE R-13 FD CUT LIMESTONE & REFERENCED SAME
- 1985 BARNES VOL 6 PG 337 SHOWS RECORD DISTANCES: ORIG 2607 & RUGER 2632.08 TO N ¼ COR SEC 27 & RUGER VAR 8-15 2670.69 TO W ¼ COR SEC 27

## FD GUT LIMESTONE.

C) Was the corner restored through acceptance of (1) an obliterated evidence location, or, (2) a found perpetuated location?

## ACCEPTED FOUND LIMESTONE.

- D) Describe any material discrepancy between the location of the corner as restored or reestablished and the location of that corner as previously restored or reestablished by distance and direction. Show the discrepancy on the plan view drawing under (a), above. Show the distances between the corner as previously restored or reestablished and (1) the corner as restored or reestablished, and (2) to at least 4 of the witness monuments shown on the drawing in (a), above.
- I, Donald Barnes, hereby certify that the corner location as identified by the corner code index was determined by me under my direction and control and that this U.S. Public Land Survey Monument Record is correct and complete to the best of my knowledge and belief.

Soul

05/08/00 Emiles faces

Number of included sheets 1

CORNER CODE R-13(1)