Paper weight-110# (minimum)

Black nonfading ink required

U.S. PUBLIC LAND SURVEY MONUMENT RECORD


For Public Land Survey Corners In:

WI ADMINISTRATIVE CODE A-E 7.08 REQUIREMENT

REV 19/23/2004 USMONREC.DWG

T. 4 N. R. 10 E. 4th P.M.

CORNER CODE INDEX

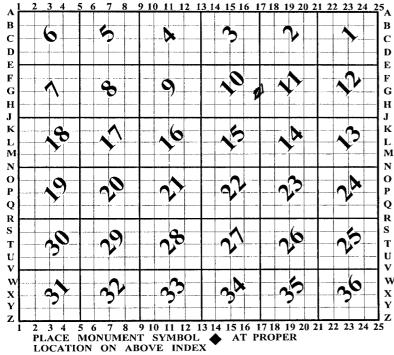

UNION TWP

IF AVAILABLE ROCK COUNTY COORDINATES PERFERRED

North Elev
East
Hor. Datum Vert. Datum
LATITUDE ELLIPS. HT.
LONGITUDE
NAD83(91)NETWORK ADJ. YR 2010
GPS (X) TRAVERSE (X) _X
BASED ON THE FOLLOWING CONTROL:

♦ CORNER MONUMENT

WITNESS MONUMENT

FIELD BOOK PAGE #	SHEET	/	/	
OR OBSERVATION SHEET			OF '	
SHOW A PLAN VIEW DRAWING DEPICTING THE CORNER MONUMENT AND SURROUNDING				
PHYSICAL FEATURES, INCLUDING THE EXCAVATION AREA AND DEPTH.				
PLANNING & ZONING COMMITTEE ADOPTED THIS FORM ON 12/2/1982		<u> </u>	~ ``	

CORNER CODE (5/2)

UN538 W1/4CORSEC11

(B) Describe any record evidence, monument evidence, occupational evidence, testimonial evidence or any other material evidence you considered, and whether the monument was found or placed.

1833 HARRISON (NOV 6TH) T4N R10E 4TH MER NORTH
BETWEEN SECS 10 & 11

1155.0 LEAVE PRAIRIE & ENTER TIMBER

2640.00 QUARTER SEC COR IN SOUTHERN EDGE OF SW ARM OF PRAIRIE {BURR 0 24 N74W 38.94'; BURR 0 18 S40E 82.5' BURR 0 24 & BURR 0 18}MARKED

4290.0 ENTER TIMBER

5280.00 COR TO SECS 2,3,10,11

{BURR 0 24 N20E 38.94'; BURR 0 20 S50E 18.48'; BURR 0 20 S45W 82.5'; BURR 0 20 N55W 27.72' LAND WET 2ND RATE WITH BURR 0 TIMBER PRAIRIE LEVEL 1ST RATE

1870 RUGER AUG REMON-111 SOUTH ON WEST LINE OF NW
1/4 SEC 11 ON A VAR 7-00'AT

2661.45 INTERSECTED QUARTER LINE 2.97' EAST OF QUARTER CORNER. FOUND OLD STAKE AT CORNER. ALSO FOUND STUMPS OF BOTH BEARING TREES. COR VAR 6-56

NORTH ON WEST LINE OF SW 1/4 SEC 11 ON A VAR 7-00; OFFSET EAST 5.28' OFFSET WEST 25.08' OFFSET WEST 5.28' AT

2658.48 INTERSECTED SOUTH BOUNDARY LINE 22.44'
WEST OF CORNER. COR VAR 6-57'

- 1962 SIMEALL #5126 STONE 5245.2 TO PIPE @ W 1/4 COR SEC 10
- 1970 COMBS #5118 FD CUT STONE. N89-15-55W TO W 1/4 COR SEC 10
- 1971 COMBS CSM VOL 2 PG 178 FD MON. USED FD MON @ W 1/4 COR SEC 10 FOR LINE
- 1975 GRENLIE CSM VOL 4 PG 360 FD STONE
- 1979 WIDOT PROJ 5155-00-21 SHEET 4.2 #11781 MONUMENT.
- 1992 KARNS CSM VOL 15 PG 490 STATES NOTHING ABOUT MON.
- 2008 LATHROP G-17 FD 6X6 CUT LIMESTONE. STONE SHOWN AS FD ON PREVIOUS SURVEY BY HAROLD COMBS (RL THOM SURVEY #962) DATE NOT LEGIBLE. REFERENCED SAME. MON @ FENCE INT.
- 2008 LATHROP #16081 FD CUT STONE. NS89-51-08W 5264.32 TO CUT STONE @ W 1/4 COR SEC 11
- 2008 LATHROP CSM VOL 32 PG 241 STONE. 5264.32 TO STONE @ E 1/4 COR SEC 11

FD CUT LIMESTONE @ FENCE INT. PLACED CARSONITE POST NEXT TO L.S. FD REFERENCE PINS.

C) Was the corner restored through acceptance of (1) an obliterated evidence location, or, (2) a found perpetuated location?

ACCEPTED FD CUT LIMESTONE.

- D) Describe any material discrepancy between the location of the corner as restored or reestablished and the location of that corner as previously restored or reestablished by distance and direction. Show the discrepancy on the plan view drawing under (a), above. Show the distances between the corner as previously restored or reestablished and (1) the corner as restored or reestablished, and (2) to at least 4 of the witness monuments shown on the drawing in (a), above. None
- (E) Was the corner reestablished through lost corner proportionate methods? If so, show the method, including the directions and distances to other public land survey corners used as evidence or used for proportioning the corner location. $N\Box$
- I, **Donald Barnes**, hereby certify that the corner location as identified by the corner code index was determined by me under my direction and control and that this U.S. Public Land Survey Monument Record is correct and complete to the best of my knowledge and belief.

SHEET 1 OF 1

CORNER CODE G-17(1)

A.E. 7.08 REQUIREMENT

Oct 24,2011