

U.S. PUBLIC LAND SURVEY MONUMENT RECORD


For Public Land Survey Corners in the

T. 2 N., R. 12 E.

CORNER CODE INDEX

1	2	3	4	5	6	7	8	9	10	11	12	13	14	15	16	17	18	19	20	21	22	23	24	25
A																								
B																								
C		6																						
D			5																					
E				4																				
F					3																			
G						2																		
H																								
I																								
J																								
K																								
L																								
M																								
N																								
O																								
P																								
Q																								
R																								
S																								
T																								
U																								
V																								
W																								
X																								
Y																								
Z																								

EXAMPLE

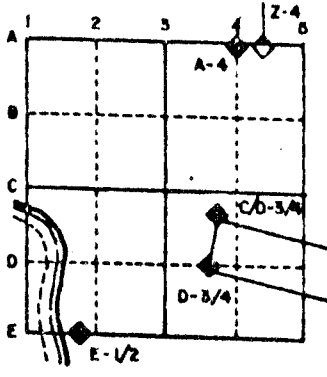

ROCK TWP
ROCK COUNTY WI


IF AVAILABLE STATE PLANE COORDINATES

NAD
27 North (Y) 232,999.80 Elev. (Z) 833.2
East (X) 3265,988.52 Zone _____
Hor. Datum _____ Vert. Datum _____
HURD LA PRAIRIE
233,000.74 233,000.50
2,265,988.96 2,265,988.52

PLACE MONUMENT SYMBOL (◆) AT PROPER LOCATION ON ABOVE INDEX

- ◆ CORNER MONUMENT
- WITNESS MONUMENT
- S.T.H
- 233,000.00
- 2,265,988.48

BEARINGS ARE BASED ON: Assumed

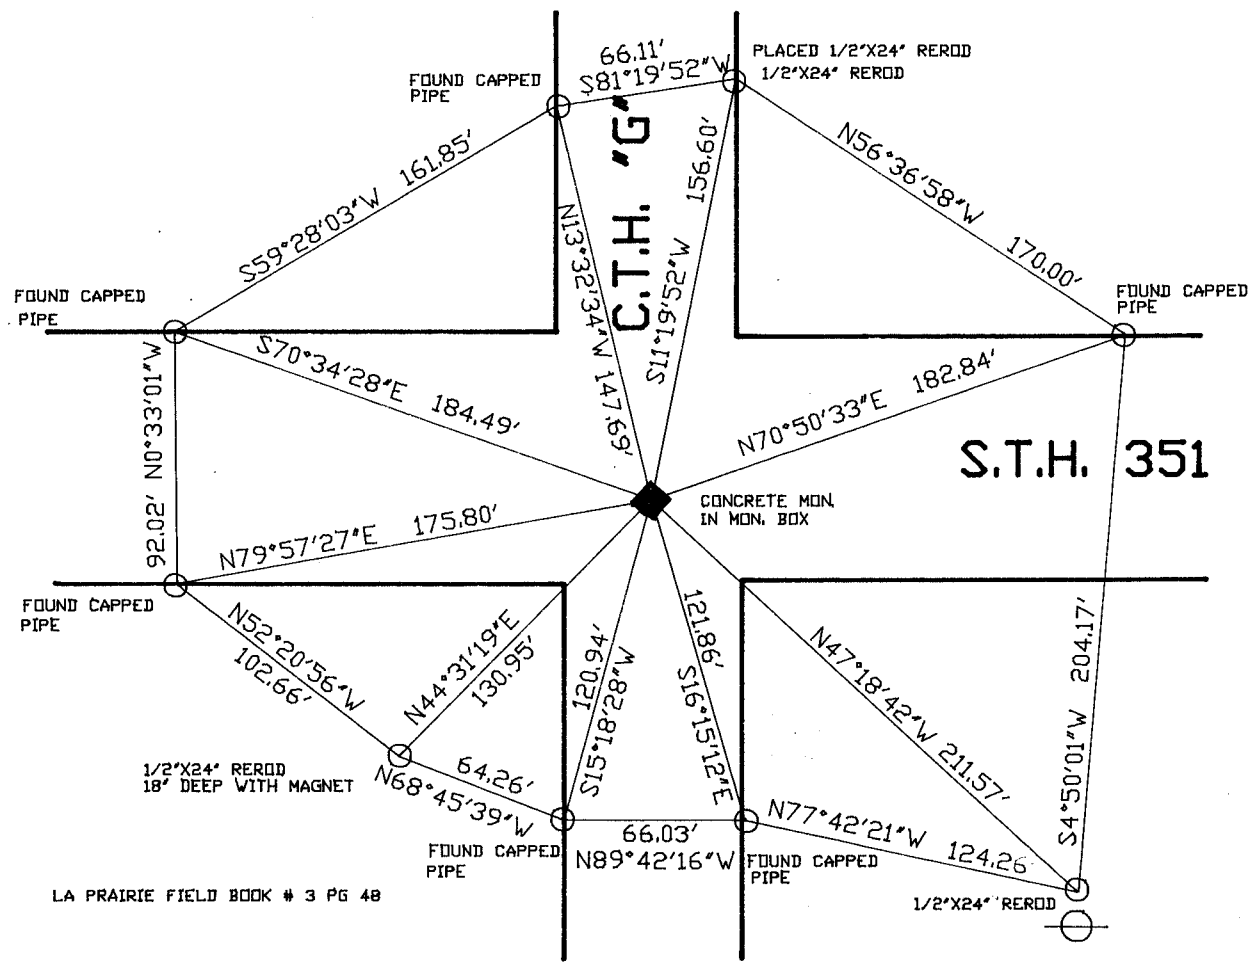

LA PRAIRIE FIELD BOOK # 3 PG 48

SHEET ___ OF ___

CORNER CODE: L 25

.(B) Describe any record evidence, monument evidence, occupational evidence, testimonial evidence or any other material evidence you considered, and whether the monument was found or placed.

- 1835 MULLETT ORIGINAL GOVERNMENT SURVEYOR. FIELD NOTES - SET QUARTER SECTION POST IN MOUND. PIT BEARING SOUTH 1.98'.
1869 LEE VOL 1 PG 346. FOUND POINT OF OLD STAKE. SET PIECE OF SCANTLING 1 1/2 X 4 INCHES SURROUNDED BY 4 LIMESTONES.
1869 LEE VOL 2 PG 4. FOUND CORNER SET BY SELF. SHOWS A DISTANCE OF 2653.20 TO THE NE CORNER OF SECTION 13.
1871 RUGER LA PRAIRIE REMONUMENTATION FIELD NOTES. SOUTH ON WEST LINE NW 1/4 SECTION 18. ON A VAR 7-00 AT 2654.52 INTERSECTED 1/4 LINE 1.98' EAST OF 1/4 CORNER FOUND STAKE SURROUNDED BY 3 LIMESTONES AT CORNER. CORRECTED VAR 6-57. MEASURED 2646.60 TO SW CORNER OF SECTION 18. PLACED CUT LIMESTONE.
1877 RUGER VOL 2 PG 237. SHOWS 2649.08 TO THE NE CORNER AND 2564.43.
1936 SUNNY VOL 3 PG 294 FOUND 6X6 CUT STONE MONUMENT 16" LOW. SET 1 1/2 X 16 " IRON PIPE WITH CAP ON TOP. REFERENCED SAME.
1960 BATTERMAN JR. VOL 4 PG 60. REFERENCED SAME.
19?? HURD VOL 5 PG 517 N/S 233,000.74; E/W 2,265,988.96
1989 BARNES VOL 6 PG 395
N/S 232,999.61;E/W 2,265,988.72;
DOT COORDINATES N/S 233,000.00; E/W 2,265,988.48
TOWNSHIP PROJECT N/S 233,000.50 E/W 2,265,988.52
SHOWS THE FOLLOWING DISTANCES AND BEARINGS
TO NE COR SEC 13 BARNES 1986 2653.41
HURD 19?? N00-46-29W 2653.37
CENTER SEC 13 S89-22-18E 2567.60
SE COR SEC 13 BARNES 1986 2644.82
HURD 19?? 2644.40
N0-40-15W 2644.78
1986 DOT AFTER ROAD CONSTRUCTION, DOT PLACED CONCRETE MONUMENT IN MONUMENT BOX.


FOUND CONCRETE MONUMENT IN ROUND MONUMENT BOX.

C) Was the corner restored through acceptance of (1) an obliterated evidence location, or, (2) a found perpetuated location?

ACCEPTED FOUND MONUMENT BOX.

D) Describe any material discrepancy between the location of the corner as restored or reestablished and the location of that corner as previously restored or reestablished by distance and direction. Show the discrepancy on the plan view drawing under (a), above. Show the distances between the corner as previously restored or reestablished and (1) the corner as restored or reestablished, and (2) to at least 4 of the witness monuments shown on the drawing in (a), above.

I, Donald Barnes, hereby certify that the corner points as identified by the corner code index were, in a field survey on, July 20, 1990, established, re-established, monumented, re-monumented, recovered or restored as expressed below and in conformance with the regulations and rules as required in the current manual of survey instructions of the United States Department of Interior Bureau of Land Management.

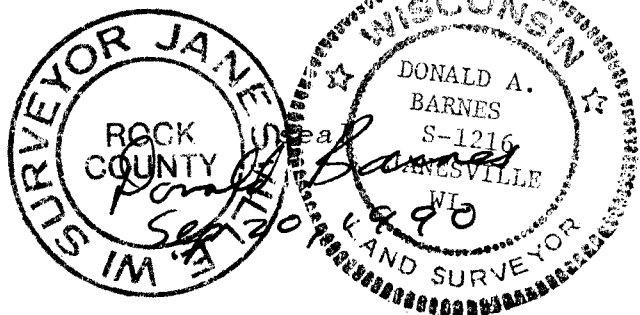

COUNTY SURVEYOR FILING DATA

Date of computer entry _____

Date microfilmed _____

Number of included sheets _____

CORNER CODE

L25