


# U.S. PUBLIC LAND SURVEY MONUMENT RECORD

For Public Land Survey Corners in the  
T. 2 N., R. 12 E.

## CORNER CODE INDEX

	1	2	3	4	5	6	7	8	9	10	11	12	13	14	15	16	17	18	19	20	21	22	23	24	25
A																									
B																									
C	6																								
D		5																							
E			4																						
F				3																					
G					2																				
H																									
I	7																								
J		8																							
K			9																						
L				10																					
M					11																				
N						12																			
O							13																		
P								14																	
Q									15																
R										16															
S											17														
T												18													
U													19												
V														20											
W															21										
X																22									
Y																	23								
Z																		24							

### EXAMPLE

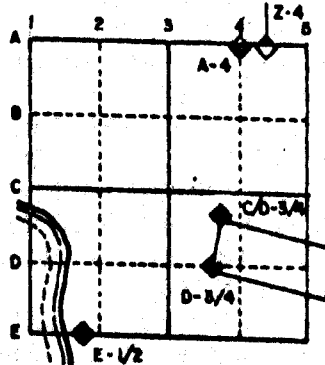

ROCK TWP  
ROCK COUNTY WI

IF AVAILABLE  
STATE PLANE COORDINATES


North (Y) 222,426.48 Elev. (Z) 812.7  
East (X) 2,266,124.31 Zone \_\_\_\_\_

Hor. Datum \_\_\_\_\_ Vert. Datum \_\_\_\_\_

PLACE MONUMENT SYMBOL (●) AT PROPER LOCATION ON ABOVE INDEX  
LA PRAIRIE  
222,427.36  
2,266,124.20

● CORNER MONUMENT ○ WITNESS MONUMENT

BEARINGS ARE BASED ON: ASSUMED

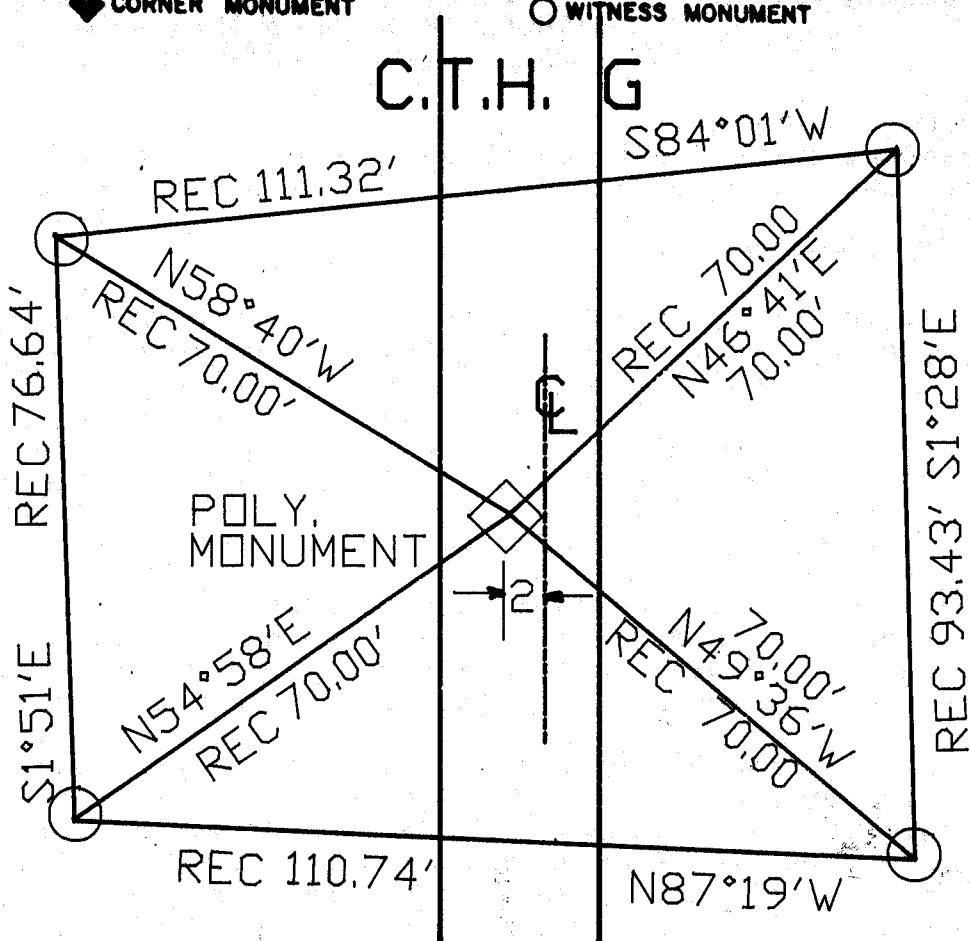

VOL 4 PG 58  
LA PRAIRIE FIELD BOOK #3 PG 10

○ FOUND 1" IRON PIPE  
BEARINGS COMPUTED FROM  
RECORD DISTANCES

**MICROFILMED**  
SHEET \_\_\_ OF \_\_\_  
CORNER CODE: T25

(B) Describe any record evidence, monument evidence, occupational evidence, testimonial evidence or any other material evidence you considered, and whether the monument was found or placed.

1833 MULLETT ORIGINAL GOVERNMENT SURVEYOR. SET QUARTER SECTION POST IN MOUND. PIT BEARING SOUTH 10.56'

1870 RUGER LA PRAIRIE TOWNSHIP REMONUMENTATION PROJECT. SOUTH ON WEST LINE OF NW /4 SEC 30 ON A VAR 7-06 AT 2653.20 INTERSECTED 1/4 LINE 5.28' EAST OF 1/4 CORNER FOUND OLD STAKE AT CORNER. CORRECTED VAR 6-59. MEASURED 2638.68 TO SE CORNER OF SECTION 25. PLACED CUT LIMESTONE.

1873 LEE VOL 2 PG 95 FOUND MONUMENT.

1891 BLEEDORN VOL 2 PG 449 STATES "MONUMENT"

1908 KERCH VOL 3 PG 48 FOUND MONUMENT. SHOWS 2638.94 TO THE SE CORNER OF SECTION 25.

1936 SUNNY VOL 3 PG 295 FOUND 6X8 LIMESTONE, TOP BROKEN OFF. SET 1 1/2 IRON PIPE, CAPPED. RESET WITH 1 1/1 IRON PIPE IN NEW BLACK TOP- 1958. REFERENCED SAME. SHOWS 2664.20 TO THE NE CORNER OF SECTION 25 AND 2637.80 TO THE SE CORNER OF SECTION 25.

1960 BATTERMAN JR. VOL 4 PG 58 SHOWS REFERENCE TIES.

1989 BARNES VOL 6 PG 394 COORDINATES N/S 222,426.05; E/W 2,266,124.19 TOWNSHIP PROJECT N/S 222,427.36; E/W 2,266,124.20. SHOWS THE FOLLOWING DISTANCES:

TO NE COR OF SEC 25	S0-40-03E	2663.15
	RUGER 1871	2653.20
	BARNES 1985	2663.17
CENTER SEC 25	S89-38-10E	2495.76
SE COR SEC 25	S1-27-29E	2637.32
	RUGER 1871	2638.68
	BARNES 1985	2637.32

FOUND POLY MONUMENT.



C) Was the corner restored through acceptance of (1) an obliterated evidence location, or, (2) a found perpetuated location?

ACCEPTED FOUND MONUMENT.

D) Describe any material discrepancy between the location of the corner as restored or reestablished and the location of that corner as previously restored or reestablished by distance and direction. Show the discrepancy on the plan view drawing under (a), above. Show the distances between the corner as previously restored or reestablished and (1) the corner as restored or reestablished, and (2) to at least 4 of the witness monuments shown on the drawing in (a), above.

(E) Was the corner reestablished through lost corner proportionate methods? If so, show the method, including the directions and distances to other public land survey corners used as evidence or used for proportioning the corner location.

I, Donald Barnes, hereby certify that the corner points as identified by the corner code index were, in a field survey on, July 20, 1990, established, re-established, monumented, re-monumented, recovered or restored as expressed below and in conformance with the regulations and rules as required in the current manual of survey instructions of the United States Department of Interior, Bureau of Land Management.

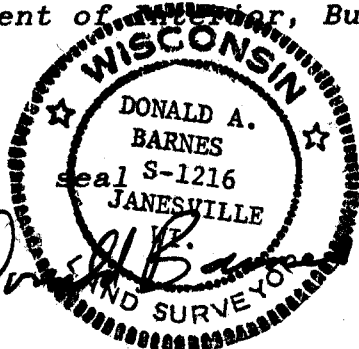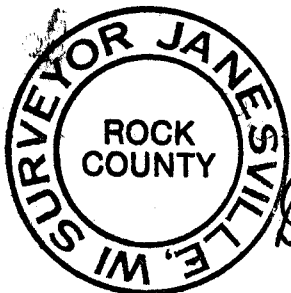

COUNTY SURVEYOR FILING DATA

Date of computer entry \_\_\_\_\_

Date microfilmed \_\_\_\_\_

Number of included sheets \_\_\_\_\_

CORNER CODE

AFFIX YOUR LAND SURVEYOR SEAL

T 25