


U.S. PUBLIC LAND SURVEY MONUMENT RECORD

For Public Land Survey Corners in the
T. 2 N., R. 12 E.

CORNER CODE INDEX

	1	2	3	4	5	6	7	8	9	10	11	12	13	14	15	16	17	18	19	20	21	22	23	24	25
A																									
B																									
C	6																								
D		5																							
E			4																						
F				3																					
G					2																				
H																									
I																									
J																									
K																									
L																									
M																									
N																									
O																									
P																									
Q																									
R																									
S																									
T	30	29	28	27	26	25																			
U																									
V																									
W																									
X	31	32	33	34	35	36																			
Y																									
Z																									

EXAMPLE

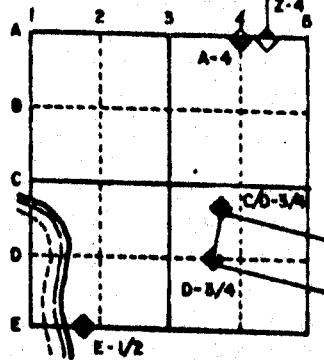


ROCK TWP
ROCK COUNTY WI

IF AVAILABLE
STATE PLANE COORDINATES

North (Y) 219,790.02 Eleve. (Z) 788
 East (X) 2,266,191.47 Zone _____
 Hor. Datum _____ Vert. Datum _____

PLACE MONUMENT SYMBOL (⊙) AT PROPER LA PRAIRIE PROT.
 LOCATION ON ABOVE INDEX
219,790.74
2,266,191.36

e.) ⊙ CORNER MONUMENT ○ WITNESS MONUMENT

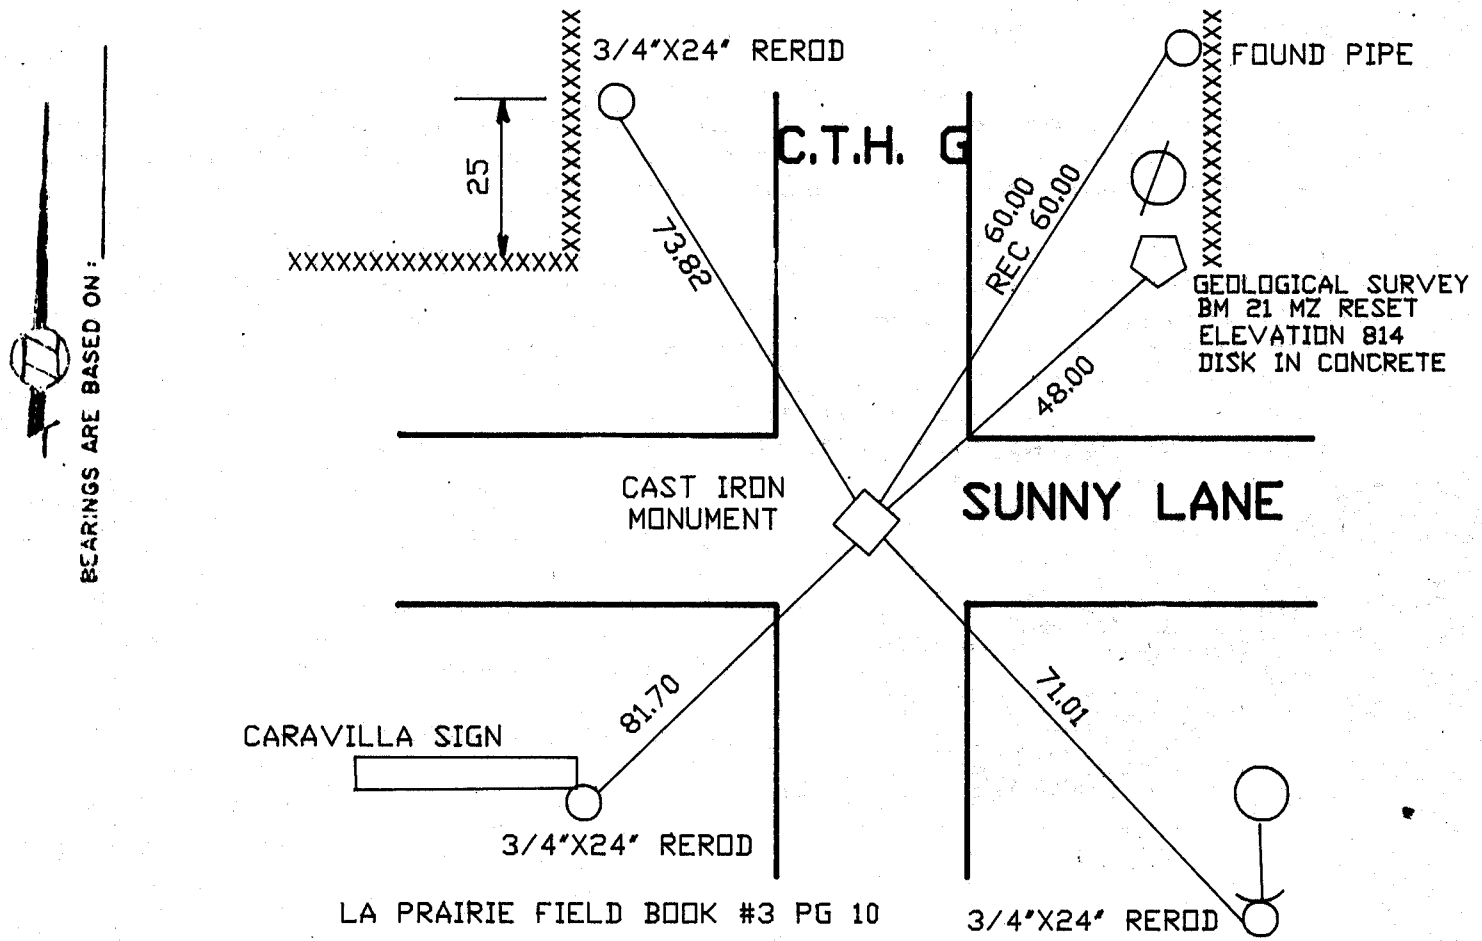

MICROFILMED

SHEET ___ OF ___

CORNER CODE: V 25

(B) Describe any record evidence, monument evidence, occupational evidence, testimonial evidence or any other material evidence you considered, and whether the monument was found or placed.

1870 RUGER LA PRAIRIE TOWNSHIP REMONUMENTATION PROJECT. SOUTH ON WEST LINE OF SW 1/4 SEC 30 ON A VAR 7-12 AT 2638.68 INTERSECTED SOUTH BOUNDARY LINE .66' EAST OF CORNER. FOUND OLD STAKE AT CORNER. VAR CORRECTED 7-11. PLACED CUT LIMESTONE. MEASURED 2648.91' TO THE E 1/4 CORNER OF SECTION 36 AND 2605.35 (VAR 5-13) TO THE S 1/4 CORNER OF SECTION 30.
1876 RUGER VOL 2 PG 216 SHOWS MONUMENT. AND A DISTANCE OF 2643.96 TO E 1/4 CORNER OF SECTION 36.
1908 KERCH VOL 3 PG 48 2517.05 TO S 1/4 CORNER OF SECTION 25 AND 2638.94 TO THE E 1/4 CORNER OF SECTION 25.
1936 SUNNY VOL 3 PG 295 FOUND 6X6 CUT STONE MONUMENT 24" LOW. SET 1 1/2" IRON PIPE MONUMENT CAPPED. REFERENCED SAME.
1960 BATTERMAN JR. VOL 4 PG 58. SHOWS REFERENCES.
1986 BARNES VOL 6 PG 335. SHOWS RECORD DISTANCES AS SHOWN ABOVE.
1989 BARNES VOL 6 PG 394 N/S 219,789.52; E/W 2,266,191.27 TOWNSHIP PROJECT N/S 219,790.94; E/W 2,266,191.36. SHOWS THE FOLLOWING:

TO	S 1/4 COR SEC 25	S89-52-35E	2511.70
	E 1/4 COR SEC 25	S01-27-29E	2637.32
		RUGER 1871	2638.68
		BARNES 1985	2637.32

1989 BARNES VOL 6 PG 397 SHOWS S89-52-35E 2511.70 TO N 1/4 COR SEC 36 AND N01-28-56W 2649.23 TO E 1/4 COR SEC 36.

FOUND CAST IRON MONUMENT.


C) Was the corner restored through acceptance of (1) an obliterated evidence location, or, (2) a found perpetuated location?

ACCEPTED FOUND MONUMENT.

D) Describe any material discrepancy between the location of the corner as restored or reestablished and the location of that corner as previously restored or reestablished by distance and direction. Show the discrepancy on the plan view drawing under (a), above. Show the distances between the corner as previously restored or reestablished and (1) the corner as restored or reestablished, and (2) to at least 4 of the witness monuments shown on the drawing in (a), above.

(E) Was the corner reestablished through lost corner proportionate methods? If so, show the method, including the directions and distances to other public land survey corners used as evidence or used for proportioning the corner location.

I, Donald Barnes, hereby certify that the corner points as identified by the corner code index were, in a field survey on, July 20, 1990, established, re-established, monumented, re-monumented, recovered or restored as expressed below and in conformance with the regulations and rules as required in the current manual of survey instructions of the United States Department of Interior, Bureau of Land Management.

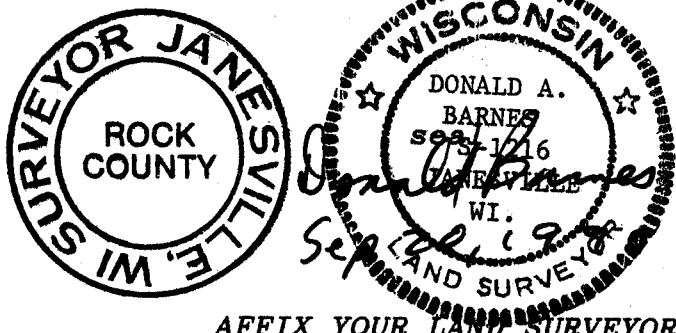

AFFIX YOUR LAND SURVEYOR SEAL

COUNTY SURVEYOR FILING DATA

Date of computer entry _____

Date microfilmed _____

Number of included sheets _____
CORNER CODE

V 25