

U.S. PUBLIC LAND SURVEY MONUMENT RECORD


For Public Land Survey Corners in the
T. 2 N., R. 12 E.

CORNER CODE INDEX

	1	2	3	4	5	6	7	8	9	10	11	12	13	14	15	16	17	18	19	20	21	22	23	24	25
A																									
B																									
C	6																								
D																									
E																									
F																									
G	7																								
H																									
I																									
J																									
K																									
L	18																								
M																									
N																									
O																									
P	19																								
Q																									
R																									
S																									
T	30																								
U																									
V																									
W																									
X	31																								
Y																									
Z																									

PLACE MONUMENT SYMBOL (◆) AT PROPER LOCATION ON ABOVE INDEX

EXAMPLE

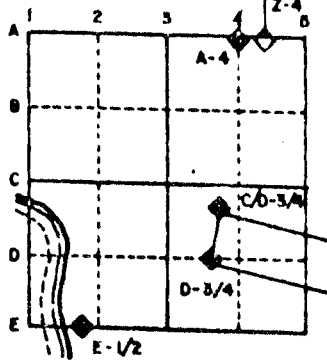


ROCK TWP
ROCK COUNTY WI

IF AVAILABLE
STATE PLANE COORDINATES

NAD North (Y) 240948.29 Eleve. (Z) 828.0
 27 East (X) 2,265,850.19 Zone _____
 Hor. Datum _____ Vert. Datum _____
 LA PRAIRIE PROJECT
 240,948.86
 2,265,850.35

◆ CORNER MONUMENT

○ WITNESS MONUMENT

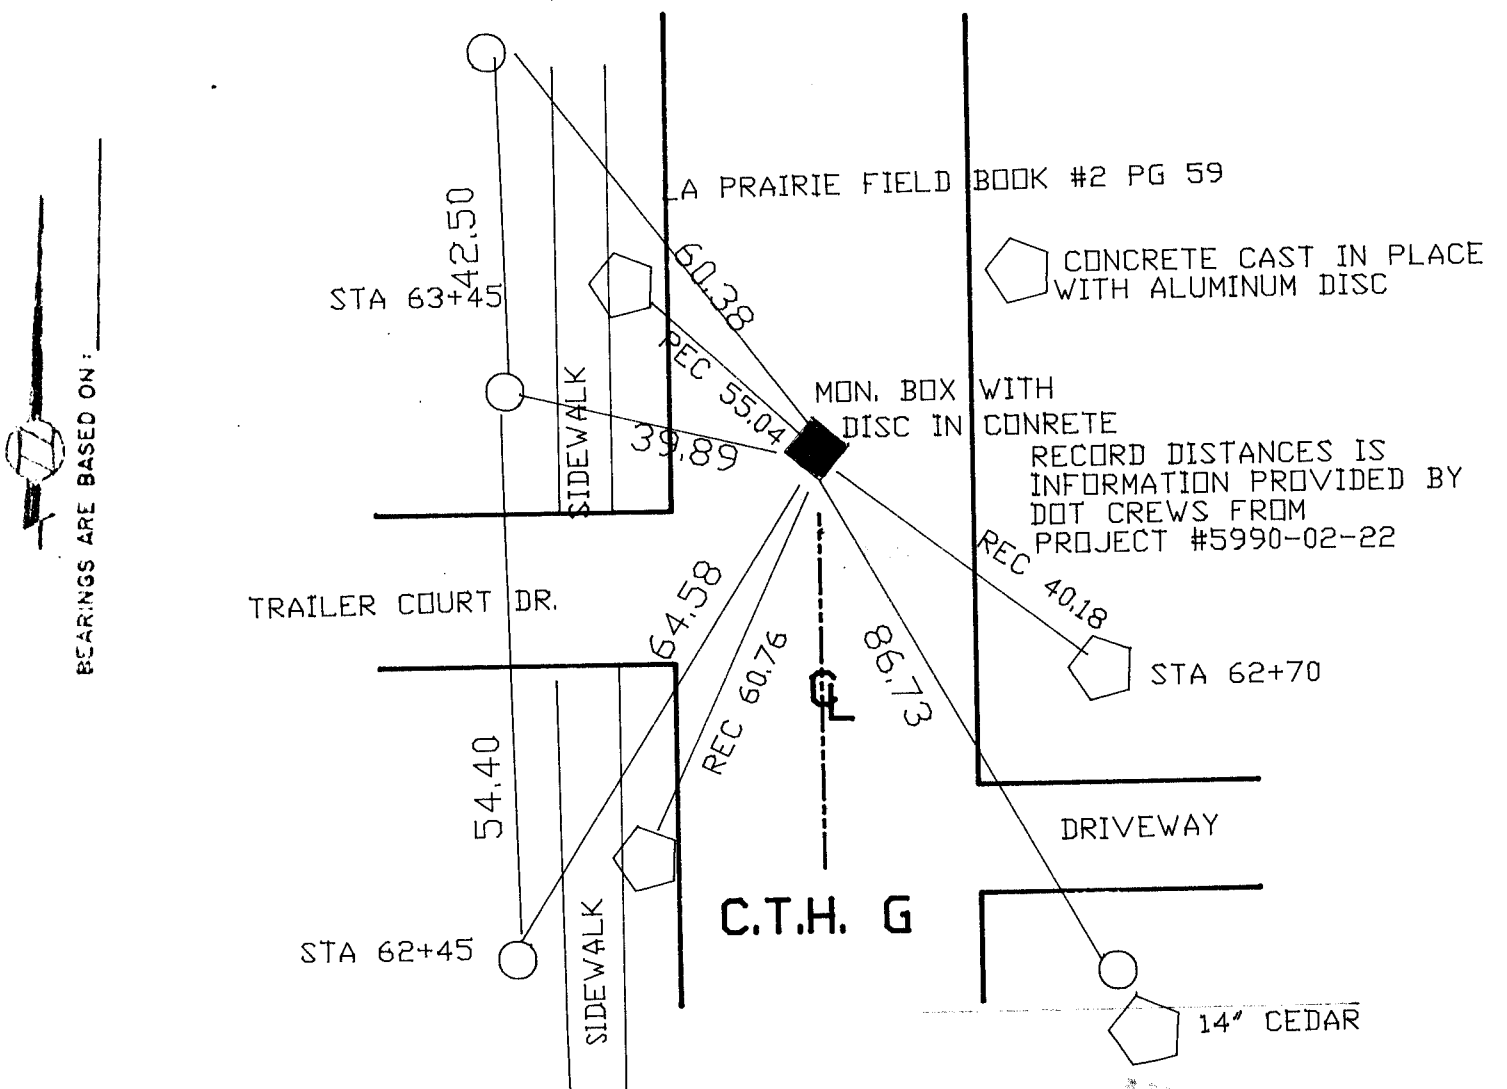

MICROFILMED
SHEET ___ OF ___

CORNER CODE: E25


(B) Describe any record evidence, monument evidence, occupational evidence, testimonial evidence or any other material evidence you considered, and whether the monument was found or placed.

- 1835 MULLETT ORIGINAL GOVERNMENT SURVEYOR. FIELD NOTES - PLACED POST CORNER SECTIONS 1 & 12 IN MOUND. PIT SOUTH 2.64'. LAND HILLY.
- 1836 LYON ORIGINAL GOVERNMENT SURVEYOR. FIELD NOTES - INTERSECTED RANGE LINE 68.64' NORTH OF POST. SHOWS A DISTANCE OF 2533.08 TO S 1/4 CORNER OF SECTION 1 AND 2640 FROM S 1/4 CORNER TO SW CORNER OF SECTION 1.
- 1870 RUGER VOL 2 PG 23 FOUND OLD STAKE AND SET LIMESTONE 15 X 8 X 2 1/2. SHOWED A BEARING TREES: POPLAR 16 S82W 50. SHOWED A DISTANCE OF 2463.12 TO S 1/4 CORNER OF SECTION 6 LA PRAIRIE TOWNSHIP AND 2647.92 TO W 1/4 CORNER OF SECTION 6.
- 1877 RUGER VOL 2 PG 40,41 SHOW A DISTANCE OF 2548.92 TO S 1/4 CORNER OF SECTION 1.
- 1884 RUGER VOL 2 PG 376 SHOWS A DISTANCE OF 2462.46 TO S 1/4 CORNER OF SECTION 6 LA PRAIRIE TOWNSHIP.
- 1919 BATTERMAN VOL 3 PG 86 FOUND MONUMENT AT SECTION CORNER.
- 1935 SUNNY VOL 3 PG 258. FOUND IRON PIPE AT SECTION CORNER.
- 1936 SUNNY VOL 3 PG 294 FOUND IRON PIPE MONUMENT 24" LOW, SET 1 1/2" X 24" PIPE WITH CAP ON TOP. REFERENCED SAME.
- 1938 SUNNY VOL 3 PG 383 SHOWS A DISTANCE OF 2651.60 TO S 1/4 CORNER OF SECTION 6 LA PRAIRIE TOWNSHIP.
- 1962 BATTERMAN VOL 4 PG 122. FOUND 3/4" PIN AND REFERENCED SAME. SHOWS A DISTANCE OF 2649.98 TO E 1/4 CORNER OF SECTION 12 ROCK TOWNSHIP.
- 1970 BATTERMAN VOL 4 PG 122 SET MONUMENT BOX AND REFERENCED SAME.
- 1986 BARNES VOL 6 PG 359 SHOWS A DISTANCE AND BEARING OF N1-11-55W 2651.15 TO E 1/4 CORNER SECTION 1 AND N89-36-54E 2465.27 TO S 1/4 CORNER OF SECTION 6. ALSO SHOWS A 1972 COMBS DISTANCE OF 2465.88 TO S 1/4 CORNER OF SECTION 6. FOUND MONUMENT BOX WITH DISK IN CONCRETE.

C) Was the corner restored through acceptance of (1) an obliterated evidence location, or, (2) a found perpetuated location?
ACCEPTED FOUND DISK.

D) Describe any material discrepancy between the location of the corner as restored or reestablished and the location of that corner as previously restored or reestablished by distance and direction. Show the discrepancy on the plan view drawing under (a), above. Show the distances between the corner as previously restored or reestablished and (1) the corner as restored or reestablished, and (2) to at least 4 of the witness monuments shown on the drawing in (a), above.

I, Donald Barnes, hereby certify that the corner points as identified by the corner code index were, in a field survey on, July 19, 1990, established, re-established, monumented, re-monumented, recovered or restored as expressed below and in conformance with the regulations and rules as required in the current manual of survey instructions of the United States Department of Interior, Bureau of Land Management.

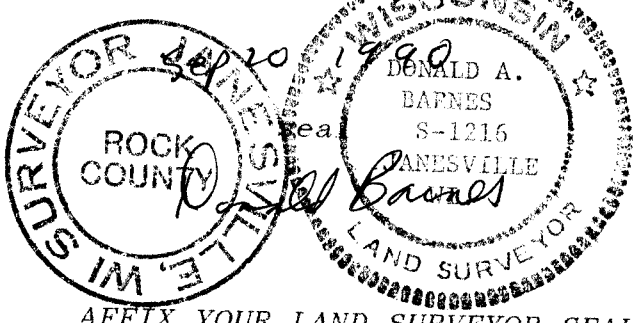

AFFIX YOUR LAND SURVEYOR SEAL

COUNTY SURVEYOR FILING DATA

Date of computer entry _____

Date microfilmed _____

Number of included sheets _____

CORNER CODE
E25