

U.S. PUBLIC LAND SURVEY MONUMENT RECORD

For Public Land Survey Corners in the


T. 2 N., R. 12 E.

CORNER CODE INDEX

	1	2	3	4	5	6	7	8	9	10	11	12	13	14	15	16	17	18	19	20	21	22	23	24	25
A																									
B																									
C	6	5	4	3	2																				
D																									
E																									
F																									
G																									
H																									
I																									
J																									
K																									
L																									
M																									
N																									
O																									
P																									
Q																									
R																									
S																									
T	30	29	28	27	26	25																			
U																									
V																									
W																									
X	31	32	33	34	35	36																			
Y																									
Z																									

PLACE MONUMENT SYMBOL (◆) AT PROPER LOCATION ON ABOVE INDEX

EXAMPLE

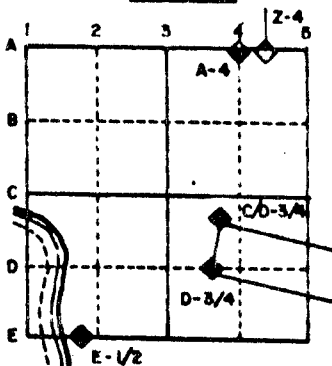

ROCK TWP
ROCK COUNTY WI


IF AVAILABLE
STATE PLANE COORDINATES

North (Y) _____ Eleve. (Z) _____
 East (X) _____ Zone _____
 Hor. Datum _____ Vert. Datum _____

a.)

◆ CORNER MONUMENT
 FOUND BRASS PLUG
 X IN MONUMENT BOX

○ WITNESS MONUMENT

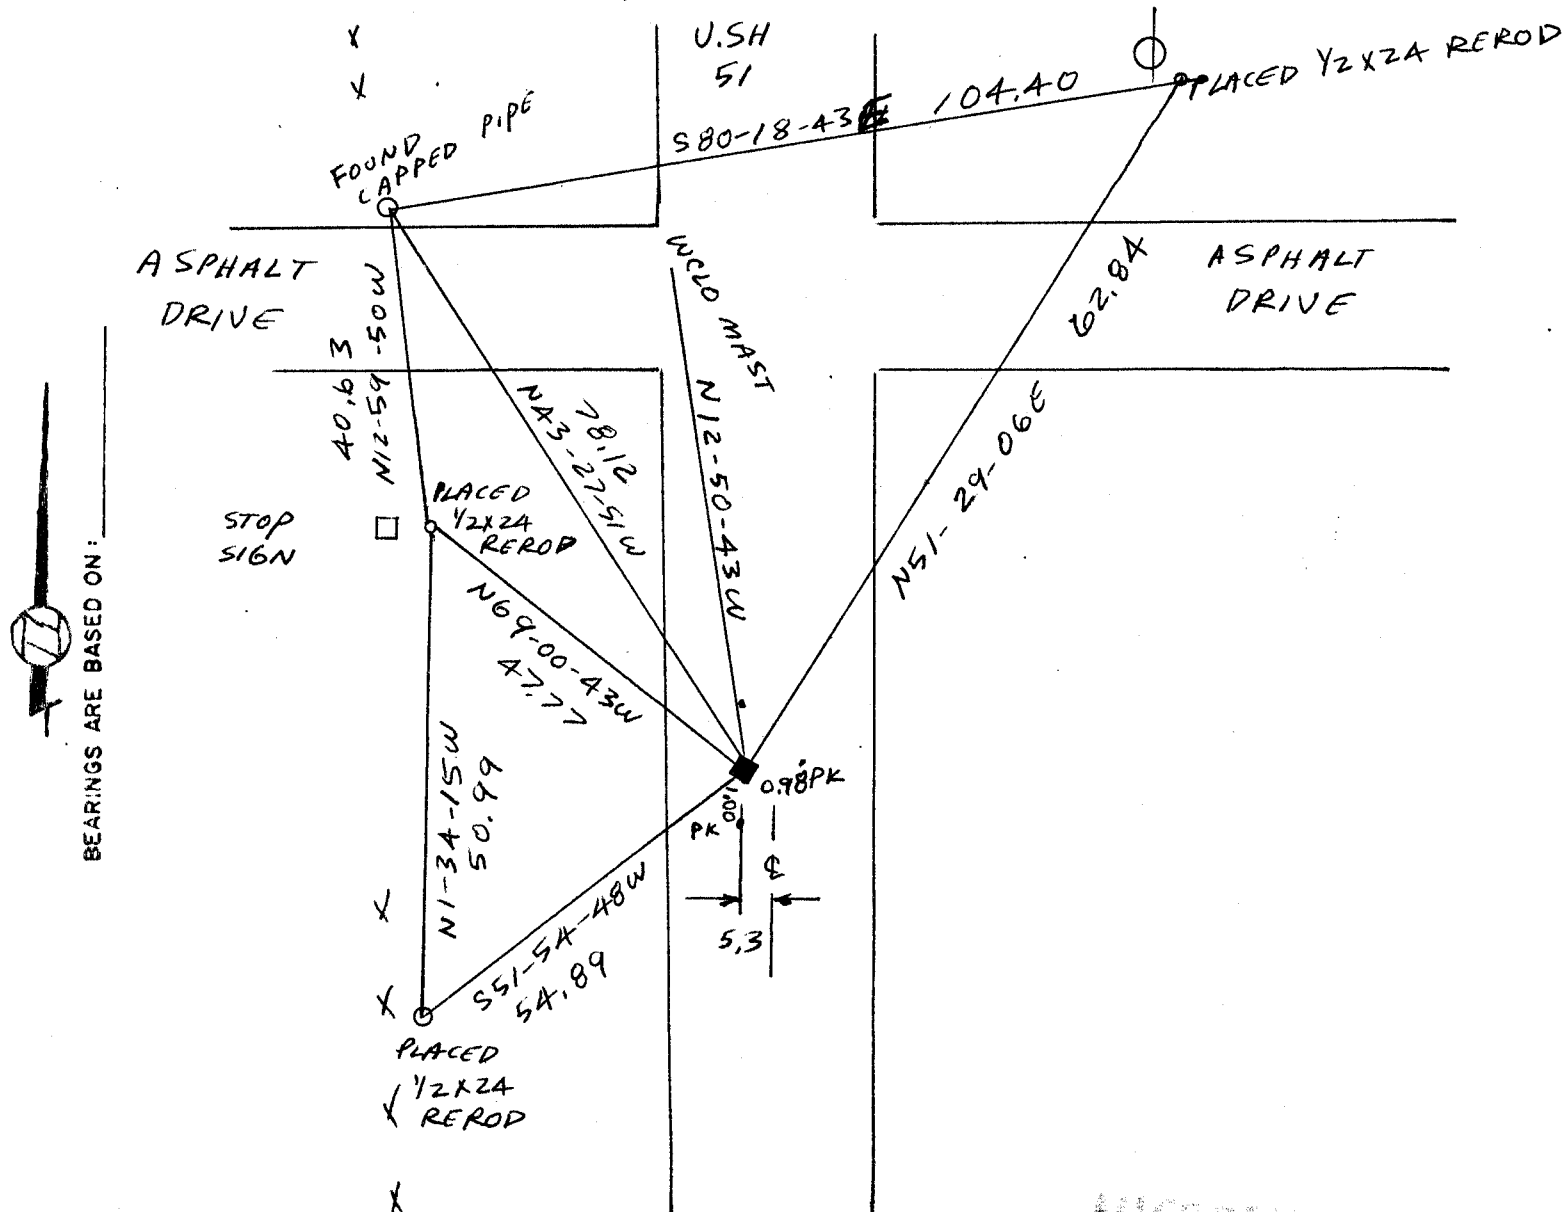

MICROFILMED

1882 LEE VOL 2 PG 370 FOUND CORNER SET BY -
 1885 RUGER VOL 2 PG 279 FOUND STAKE WITH LIMESTONE N & S.
 1919 BATTERMAN VOL 3 PG 91 COVERED BY CONCRETE.
 1938 SUNNY VOL 3 PG 396 ESTABLISHED CORNER FROM PROPORTIONATE
 MEASUREMENTS. SET 2" ROUND C.I. MONUMENT IN CONCRETE
 PAVEMENT.. SET TIES
 1941 SUNNY VOL 3 PG 489 SET 2" ROUND C.I. MONUMENT IN 1938
 CONCRETE.
 1958 BATTERMAN PLAT OF SURVEY COPPER PLUG IN PAVEMENT
 1959 BATTERMAN JR. VOL 3 PG 574 SET 1" PIPE IN MONUMENT BOX &
 REFERENCED.
 1962 BATTERMAN PLAT OF SURVEY BRASS PLUG AT CORNER.
 1966 HAROLD COMBS VOL 3 PG 396 SET MON BOXES WRITTEN AT TOP OF
 PAGE.
 19?? VOL 5 PG 61 SAME TIES AS SHOWN IN VOL 3 PG 396
 1978 HAROLD COMBS PLAT OF SURVEY FOUND PIPE IN MONUMENT BOX
 1975 HAROLD COMBS PLAT OF SURVEY FOUND PIPE IN MONUMENT BOX

 I FOUND A BRASS PLUG INSIDE A MONUMENT BOX



Donald Barnes
 3/4/89

 A circular seal with the text "DONALD BARNES" at the top, "NASHVILLE TENNESSEE" in the middle, and "LAND SURVEYOR" at the bottom.