

# U.S. PUBLIC LAND SURVEY MONUMENT RECORD

For Public Land Survey Corners in the


T. 2 N., R. 12 E.

## CORNER CODE INDEX

	1	2	3	4	5	6	7	8	9	10	11	12	13	14	15	16	17	18	19	20	21	22	23	24	25
A																									
B																									
C	6																								
D		5																							
E			4																						
F				3																					
G					2																				
H																									
I																									
J	7																								
K		8																							
L			9																						
M				10																					
N					11																				
O						12																			
P							13																		
Q								14																	
R									15																
S										16															
T											17														
U												18													
V													19												
W														20											
X															21										
Y																22									
Z																	23								
																		24							
																			25						
																				26					
																					27				
																						28			
																							29		
																								30	
																									31
																									32
																									33
																									34
																									35
																									36

PLACE MONUMENT SYMBOL (◆) AT PROPER LOCATION ON ABOVE INDEX

### EXAMPLE

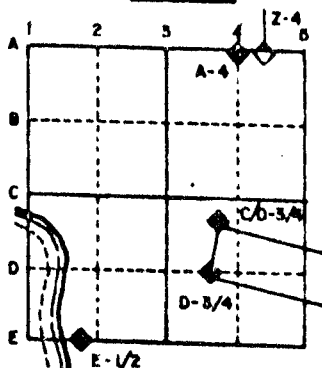


ROCK TWP  
ROCK COUNTY WI

IF AVAILABLE  
STATE PLANE COORDINATES

North (Y) \_\_\_\_\_ Eleve. (Z) \_\_\_\_\_  
 East (X) \_\_\_\_\_ Zone \_\_\_\_\_  
 Hor. Datum \_\_\_\_\_ Vert. Datum \_\_\_\_\_

◆ CORNER MONUMENT      ○ WITNESS MONUMENT

BEARINGS ARE BASED ON: ASSUMED

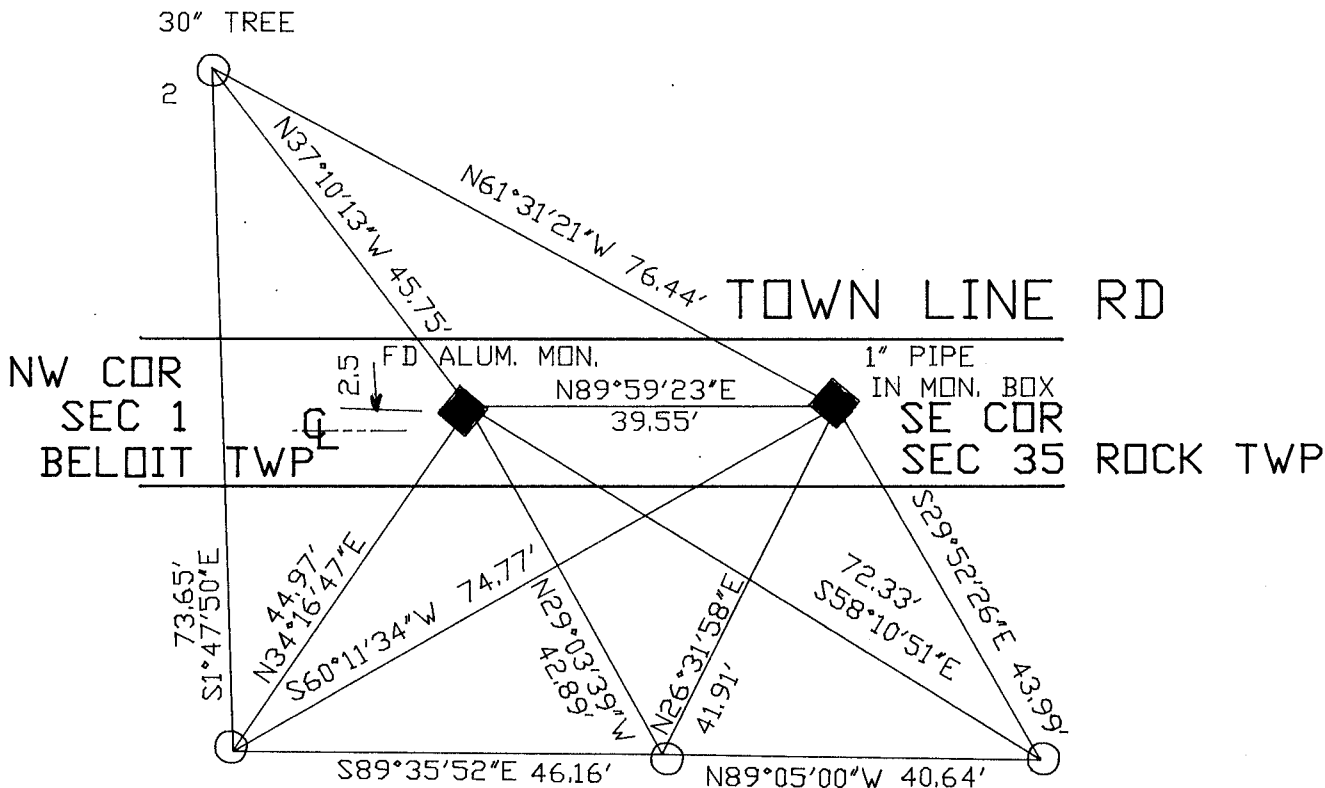

FIELD BOOK #3 PG 27

○ 3/4X24 REROD  
□ ORANGE PLASTIC CAP

SHEET \_\_\_ OF \_\_\_

CORNER CODE: 2 21

(B) Describe any record evidence, monument evidence, occupational evidence, testimonial evidence or any other material evidence you considered, and whether the monument was found or placed.

- 1891 BLEEDORN VOL 2 PG 443 PLACED LIMESTONE 13X10X4. SHOWS 2651.88 TO THE S 1/4 CORNER OF SECTION 35 AND 2257.86 TO MEANDER POST THAT IS TO THE EAST.
- 1868 BATTERMAN VOL 4 PG 375 DUG AND FOUND 13X9X14 LIMESTONE, 3.7' DEEP. PLACED 1"PIPE IN MONUMENT BOX..
- 1979 BARNES VOL 5 PG 576 FOUND MONUMENT BOX. SHOWS 5304.64 TO SW CORNER OF SECTION 35, 2649.97 TO THE W 1/4 CORNER OF SECTION 36, BLEEDORN 2653.20 TO THE W 1/4 CORNER OF SECTION 36, N87-45-46E 169.59', AND N88-34-17E 2585.71
- 1980 BARNES VOL 6 PG 15 FOUND MONUMENT BOX. SHOWS 39.6 TO THE NE CORNER OF SECTION 2 BELOIT TOWNSHIP.
- 1985 BARNES VOL 6 PG 335 SHOWS THE FOLLOWING DISTANCES:  

TO W 1/4 CORNER SEC 36	BARNES	2649.97
	ORIGINAL	2640
	RUGER	2653.2
SE COR SEC 36	BARNES	5224.14
	ORIGINAL	5235.78
NW CORNER SEC 1	ORIGINAL	39.6
	BARNES	39.6
	BATTERMAN	169.59
- 1989 BARNES VOL 6 PG 397 SHOWS RECORD DISTANCES AS PREVIOUSLY SHOWN.

FOUND ALUMINUM MONUMENT.


C) Was the corner restored through acceptance of (1) an obliterated evidence location, or, (2) a found perpetuated location?

ACCEPTED FOUND ALUMINUM MONUMENT.

D) Describe any material discrepancy between the location of the corner as restored or reestablished and the location of that corner as previously restored or reestablished by distance and direction. Show the discrepancy on the plan view drawing under (a), above. Show the distances between the corner as previously restored or reestablished and (1) the corner as restored or reestablished, and (2) to at least 4 of the witness monuments shown on the drawing in (a), above.

(E) Was the corner reestablished through lost corner proportionate methods? If so, show the method, including the directions and distances to other public land survey corners used as evidence or used for proportioning the corner location.

I, Donald Barnes, hereby certify that the corner points as identified by the corner code index were, in a field survey on, August 17, 1990, established, re-established, monumented, re-monumented, recovered or restored as expressed below and in conformance with the regulations and rules as required in the current manual of survey instructions of the United States Department of Interior, Bureau of Land Management.

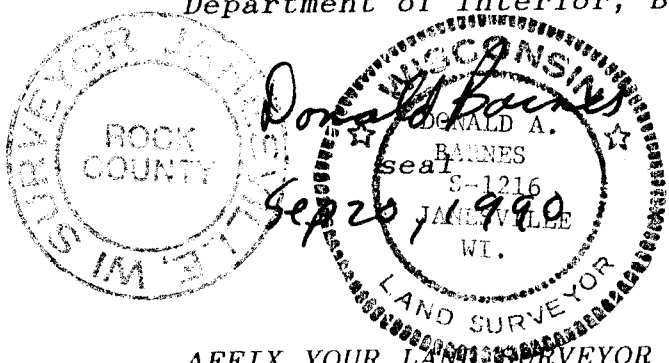

COUNTY SURVEYOR FILING DATA

Date of computer entry \_\_\_\_\_

Date microfilmed \_\_\_\_\_

Number of included sheets \_\_\_\_\_  
CORNER CODE

AFFIX YOUR LAND SURVEYOR SEAL

221