
U.S.

LAND PUBLIC SURVEY MONUMENT RECORD

For Public Land Survey Corners in: T. 2N., R. 12 E

WI ADMINISTRATIVE CODE A-E 7.08 REQUIREMENT

CORNER CODE INDEX

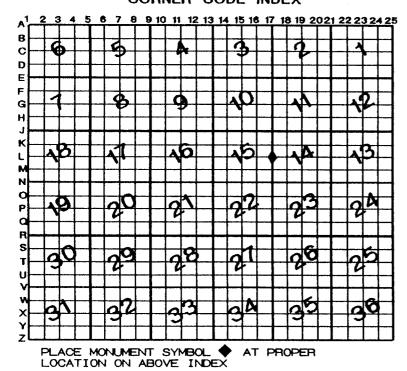

ROCI	TWP	
ROCK	COUNTY	wı

IF AVAILABLE ROCK COUNTY COORDINATES PERFERRED

North			Ele	ev	_
East			MARKET - 1884 - 1884 - 1884 - 1884 - 1884 - 1884 - 1884 - 1884 - 1884 - 1884 - 1884 - 1884 - 1884 - 1884 - 1884		
Hor. I	Datui	m	Vert. D	Datum	
LATIT	UDE	_	<u> </u>	ELLIPS.	н
LONG	TUTI	E .	······································		
GPS	(x)		TRAVER	SE (X)	
BASED	ON	THE	FOLLOWING	CONTROL:	

♦CORNER MONUMENT

O WITNESS MONUMENT

BEARINGS ARE BASED ON:

(a)

							つ
FIELD	BOOK	PAGE #			SHEET	OF	
SHOW	A PLAN VIEW	DRAWING DEPICT	ING THE CORNE	R MONUMENT AN	SURRO	UNDING	
PHYSIC	AL FEATURES,	INCLUDING THE I	EXCAVATION AR	EA AND DEPTH.			

PLANNING & ZONING COMMITTEE ADOPTED THE ABOVE FORM ON 12/2/1982

- (B) Describe any record evidence, monument evidence, occupational evidence, testimonial evidence or any other material evidence you considered, and whether the monument was found or placed.
- 1861 RUGER VOL 1 PG 168 SET RED HARDHEAD 15X8X6. SHOWS A DISTANCE OF 1324.62' TO N 1/6th CORNER OF THE SE 1/4 OF SEC 15.
- 1869 LOCKE VOL 1 PG 284. 1/4 POST AS SET BY RUGER WAS DUG OUT. SET IT IN FROM THE CORNER AND INTERMEDIATE 1/16th CORNER THAT IS TO THE SOUTH. SET RED HARDHEAD 16X14X8 AND SURROUNDED IT BY 4 SMALL LIMESTONES. SHOWS A DISTANCE OF 2657.16 TO THE SE AND 2856.37 TO THE NE CORNERS OF SECTION 15.
- 1867 LOCKE VOL 1 PG 289. FOUND CORNER AS SET BY SELF. SHOWS A DISTANCE OF 2650.56' TO THE CENTER OF SECTION 14.
- 1939 SUNNY VOL 3 PG 412. FOUND RED HARDHEAD AT CORNER 1' NORTH OF N. ROAD FENCE IN LINE WITH FENCE TO SOUTH. SHOWS A DISTANCE OF 2652.7' TO CENTER OF SECTION 14 AND 2663.4 TO THE SW CORNER OF SECTION 14.
- 1965 BATTERMAN VOL 4 PG 264 FOUND RED HARDHEAD. SHOWS A DISTANCE OF 2653.10' TO THE CENTER OF SECTION 14.
- 1990 BARNES L-17 FOUND CAST IRON MONUMENT THAT IS IN HARMONY WITH LOCAL PLAT OF SURVEYS. PLACED CARSONITE POST.
- 1997 BARNES L-17(1) CITY OF JANESVILLE REPORTED THE MONUMENT WAS IN DANGER OF BEING DESTROYED BY SEWER CONSTRUCTION. PLACED NEW REFERENCE MONUMENTS OUT OF CONSTRUCTION OF SEWER AND WATER PROJECTS.

CITY ENGINEER CALLED AND STATED THE MONUMENT WAS DESTROYED AND SHOULD BE REPLACED. PLACED POLY. MONUMENT WITH CARSONITE NEXT TO UTILITY POLY & REFERENCE PIPE. PLACED MAGNETS 1.0' DEEP & NEXT TO MONUMENT.

- C) Was the corner restored through acceptance of (1) an obliterated evidence location, or, (2) a found perpetuated location? ACCEPTED FOUND MONUMENT.
- D) Describe any material discrepancy between the location of the corner as restored or reestablished and the location of that corner as previously restored or reestablished by distance and direction. Show the discrepancy on the plan view drawing under (a), above. Show the distances between the corner as previously restored or reestablished and (1) the corner as restored or reestablished, and (2) to at least 4 of the witness monuments shown on the drawing in (a), above.
 - I, Donald Barnes, hereby certify that the corner points as identified by the corner code index were, in a field survey on, NOV 23, 1998 established, re-established, monumented, re-monumented, recovered or restored as expressed below and in conformance with the regulations and rules as required in the current manual of survey instructions of the United States Department of Interior, Bureau of Land Management.

	COUNTY SURVEYOR FILING DATA
seal	Date of computer entry
	Date microfilmed
14	Number of included sheets CORNER CODE L-17(1)

Puld Baines
NOV 25, 1998

L17(2)

