Paper weight-110# (minimum)


Black nonfading ink required

U.S.

LAND SURVEY **PUBLIC** MONUMENT RECORD

WI ADMINISTRATIVE CODE A-E 7.08 REQUIREMENT For Public Land Survey Corners In: T. $\frac{4}{N}$ N. R. $\frac{10}{E}$ E. 4th P.M.

CORNER CODE INDEX

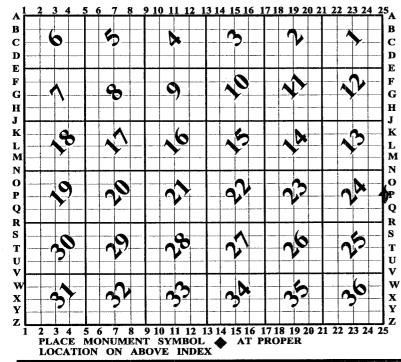

UNION TWP ROCK COUNTY WI

IF AVAILABLE ROCK COUNTY COORDINATES PERFERRED

North	Elev.
East	
Hor. Datum	Vert. Datum
LATITUDE _	ELLIPS. HT.
LONGITUDE	
NAD83(91)	NETWORK ADJ. YR 2010
GPS (X)	TRAVERSE (X) X
BASED ON TH	E FOLLOWING CONTROL:

♦ CORNER MONUMENT

WITNESS MONUMENT

(a) ROCK COUNTY PROJECTION BEARINGS ARE BASED ON:_

FIELD BOOK PAGE #	SHEET OF
OR OBSERVATION SHEET SHOW A PLAN VIEW DRAWING DEPICTING THE CORNE PHYSICAL FEATURES, INCLUDING THE EXCAVATION A	ER MONUMENT AND SURROUNDING
PLANNING & ZONING COMMITTEE ADOPTED THIS FORM C	

UN580 E1/4CORSEC24

(B) Describe any record evidence, monument evidence, occupational evidence, testimonial evidence or any other material evidence you considered, and whether the monument was found or placed.

- 1833 BRINK & MULLETT (SEP) T4N R10E VAR 8-15 NORTH ON EAST SIDE OF SECTION 24
 - 2640.0 SET QUARTER SECTION POST BUR OAK 10 S5W 25.74'; BUR OAK 10 N47W 85.8'
 - 4450.38 BUR OAK 10 IN DIAMETER
 - 5280.00 SET POST CORNER SECTIONS 13 & 24 SET POST CORNER SECTIONS 13 & 24 BUR OAK 14 S63W 10.56'; BUR OAK 14 N43W 37.62' LAND ROLLING SECOND RATE BLACK WHITE AND BUR OAK LAND ROLLING SECOND RATE BLACK WHITE AND BUR OAK
- 1833 ORIG GOV PLAT NW COR SEC 19 PORTER TWP IS 66.00'
 NORTH OF NE COR SEC 24 UNION TWP
- 1833 ORIG GOV PLAT NW COR SEC 30 PORTER TWP IS 39.60'
 NORTH OF NE COR SEC 25 UNION TWP
- 1868 LOCKE VOL 1 PG 329 & #3607 AT W 1/4 COR SEC 19 SET WHITE OAK STAKE WITH HARD HEAD ON N & S. 53.46 NORTH OF E 1/4 COR SEC 24 UNION TWP, WHICH IS LOST & SET IT IN FROM SEC CORS SET W.O STAKE SURROUNDED BY 3 HARD HEADS. WHITE OAK 25 NBW 13.53 VAR 8-04 1215.06 TO WHITE OAK STAKE SURROUNDED WITH HH ON N & S @ S 1/16TH COR OF NW 1/4 SEC 19 AND VAR8-04 2525.49 TO CENTER OF SEC 19. @ E 1/4 COR SEC 24 UNION TWP 1/4 COR LOST. SET IT IN FROM SEC CORS SET W.O STAKE SURROUNDED BY 3 HH W.O 25 NBW 13.53 V. 2656.84 SE SEC 24 TO E 1/4 COR SEC 24 & 2656.84 FROM E 1/4 COR SEC 24 TO NE COR SEC 24.
- 1870 RUGER REMONUMENTATION AUGUST 20 PG 72

 NORTH ON EAST LINE OF SE 1/4 SEC 24 (T4N
 R10E) ON A VAR 6-33 OFFSET WEST 28.38';

 OFFSET WEST 33.00' AT
 - 2650.56 INTERSECTED QUARTER LINE 40.59' WEST OF QUARTER CORNER. FOUND CORNER AS SET BY LOCKE. TESTED IT AND FOUND IT CORRECT. COR VAR 7-00'

NORTH ON EAST LINE OF NE 1/4 SEC 24 (T4N R1OE) ON A VAR 7-OO'AT

- 2650.56 INTERSECTED NORTH BOUNDARY LINE AT CORNER. FOUND CORNER AS ESTABLISHED BY LOCKE. TESTED IT AND FOUND IT CORRECTED.
- 1933 SUNNY VOL 3 PG 223 SHOWS E/W FENCE IN PORTER AS 17'
 NORTH OF 6X6 CUT STONE MON @ E 1/4 COR SEC 24
 UNION TWP. 2657.80 FROM E 1/4 TO SE CORNERS OF SEC
 24.
- 1951 SUNNY #3606 UNION TWP FD STONE @ E 1/4 COR SEC 24, CALLS FOR GOV. JOG 52.8 NORTH OF STONE. STATES PRESENT E/W FENCE 35.8' SOUTH OF E/W 1/4 LINE.
- 1970 BATTERMAN VOL 4 PG 449 FD CUT STONE @ E 1/4 COR SEC 24 UNION TWP. SHOWS @ FENCE INT. N/S FENCE TO THE SOUTH AND E/W FENCE TO THE WEST. CALLS FOR GATE AND SHOWS THE N/S FENCE IS WEST OF THE N/S FENCE TO THE EAST. BELOIT REC. SET ALSO SHOWED THE CUT STONE AT THE INT OF THE N/S FENCE LINE TO THE SOUTH & E/W FENCE LINE TO THE WEST. THE INT. IS SHOWN AS WEST OF THE N/S FENCE TO THE NORTH.
- 1970 WIDOT PROJ 5927-1-00 SHEET 4.6. CALLS FOR A 1-1/2 PIPE @ NW COR SEC 19 & CUT 6X6 STONE @ SE COR SEC 13 T4 R10E. SHOWS NW COR NORTH OF PVMT & ON LINE N/S FENCE. SE COR SEC 13 IS ON SOUTH SIDE OF PVMT.
- 1985 BARNES VOL 6 PG 346 SHOWS RECORD DISTANCES SHEET 1 OF 4

CORNER CODE P-25(1)

Onde Baues Nov 1,2011 UN580 E1/4CORSEC24

BARNES P-25 E 1/4 COR SEC 24 UNION TWP. LANDOWNER 1988 STATED THAT HE COMPLETELY REMOVED THE STONE AND

THEN BULLDOZED THE FENCE LINES OUT. HE REPLACED THE STONE AT A LOCATION HE THOUGHT WAS CORRECT.

1990 SCHROEDER #2237 FD CUT STONE @ E 1/4 COR SEC 24

UNION TWP, NOO-42-29E TO NW COR OF SEC 19.

LATHROP #15421 LEGEND SYMBOL CALLS FOR FINDING 2006

PINS @ E 1/4 COR SEC 24 UNION TWP, @ W 1/4 COR SEC 19, & E 1/16TH COR OF SE 1/4 SEC 24. FROM E 1/4 COR SEC 24 TO W 1/4 COR SEC 19 IS NO1-15-48E 53.09'. FROM E 1/4 COR SEC 24 TO NE COR SEC 24 IS 2654.02. FROM SE COR SEC 24 TO E 1/4 COR SEC 24 N1-41-25W 2660.16, FROM W 1/4 COR SEC 19 TO NE COR SEC 24.N1-47-11E 2600.93, FROM N 1/4 COR SEC 24 TO NE COR SEC 24 S82-20-40E 2614.06 & FROM NE COR SEC 24 TO NW COR SEC 19 N1-45-24E 66.00. FROM @ E 1/16TH COR OF SE 1/4 SEC 24 N1-44-25E 1330.08 TO PIN @ E 1/4 COR SEC 24 & FROM E 1/16TH COR OF SE 1/4 SEC 24 S1-44-25W 1330.08 TO LIMESTONE @ SE COR SEC 24. CALLS FOR A SET PIN

S1-47-11W 5.21 FROM THE NE COR SEC 24.

LAND OWNER WAS PRESENT AND SHOWED ME ROUGHLY WHERE THE CORNER WAS. FD 3/4 PIN ABOUT 0.9' DEEP @ THE ERRONEOUS E 1/4 COR SEC 24 UNION TWP. FD 3/4 PIN ABOUT 8" ABOVE GRADE IN N/S FENCE LINE @ ERRONEOUS W 1/4 COR SEC 19. THE LAND OWNER STATED THAT HE PULLED THE ENTIRE CUT LIMESTONE WHICH HE THOUGHT WAS ABOUT 2" LONG AND AFTER REMOVING THE FENCE LINE WITH A DOZER, HE RESET IT AT THE LOCATION THAT HE THOUGHT IT WAS REMOVED FROM.

I DID NOT FIND A RECORD OF WHO SET THE PINS. THE FOLLOWING WEEK I USED THE PUBLIC WORKS TRACTOR TO EXCAVATE FOR THE STONE. THE FARMER WAS PRESENT. I DUG & FD A CUT LIMESTONE 3.2' LONG WITH TOP 1.0' BELOW GRADE IN FARM FIELD & ON LINE WITH N/S FENCE TO THE NORTH. I BROKE THE TOP 1.5' PORTION OFF. WITH THE TRACTOR I DUG ALONG THE ENTIRE WEST SIDE OF THE STONE. THE BREAK WAS CLEAN & EVEN. THE TOP IS NOW 2.5' BELOW GRADE. I PLACED 2 MAGNETS AT THE BASE AND 2 MAGNETS ON THE TOP. THE LS IS IN EXCELLENT CONDITION. THE TOP OF THE CUT LIMESTONE HAD ORANGE PAINT ON IT. I BROUGHT THE TOP BACK TO THE COURT HOUSE. THE FARMER SHOWED ME AND DESCRIBED THE OLD FENCE LINES & PREVIOUS GATE LOCATIONS. THIS APPEARS TO BE AS SHOWN IN BATTERMAN 1970 VOL 4 PG 449 RECORD. HE ALSO SAID HE REMOVED THE N/S FENCE LINE WITH A DOZER. HE STATED HE DID THE WORK AFTER 1970. CONSIDERING THE LENGTH, CONDITION, AND QUALITY OF THE STONE I BELIEVE THE FARMER DID NOT REMOVE IT AS STATED. THE POSITION IS VERY CLOSE TO THE LOCATION THAT RUGER'S DISTANCES AND VARANCES CALLED FOR.

Donald Barnes Nov 1, 2011

SHEET 2 OF 4

CORNER CODE P-25(1)

UN580 E1/4CORSEC24

C) Was the corner restored through acceptance of (1) an obliterated evidence location, or, (2) a found perpetuated location?

ACCEPTED THE CUT LIMESTONE. IT IS WITHIN 0.01' OF RUGER'S PRORATED DISTANCES AND WITHIN 0.4' OF A LINE BETWEEN THE SE & NE CORNERS OF SEC 24 UNION TWP. THIS IS IN HARMONY WITH LOCKE'S 1868 (VOL 1 PG 329 & #3607) RECORD WHERE HE DECLARED THE E 1/4 COR SEC 24 UNION TWP AS LOST. I DUG & FD NOTHING @ W 1/4 COR SEC 19. AT THE W 1/4 COR SEC 19 I PLACED A POLY/CARSONITE @ REC. DISTANCE & ON LINE WITH THE CUT LIMESTONES.

THE ONLY CALL FOR THE PINS IS BY LATHROP'S SURVEY #15421 IN 2006. ALTHOUGH HIS MAP STATES HE FOUND THEM, I BELIEVE HE SET THE PINS AND THE MAP LEGEND SYMOBLE IS IN ERROR. I BELIEVE THIS IS SUPPORTED BY THE FACT THAT HE CALLS FOR THE FD PIN @ E 1/16TH COR OF SE 1/4 SEC 24 TO BE MIDWAY AND ON LINE WITH THE E 1/4 & SE COR OF SEC 24. SUPPOSEDLY SUNNY SET A PIPE AT THIS LOCATION & THERE IS NO OTHER RECORD OF A MONUMENT AT THIS LOCATION SINCE THEN.

I TOLD RON COMBS & HE STATED HE WAS NOT CONCERNED BECAUSE THIS WOULD HAVE LITTLE EFFECT ON HIS SURVEY LINE.

D) Describe any material discrepancy between the location of the corner as restored or reestablished and the location of that corner as previously restored or reestablished by distance and direction. Show the discrepancy on the plan view drawing under (a), above. Show the distances between the corner as previously restored or reestablished and (1) the corner as restored or reestablished, and (2) to at least 4 of the witness monuments shown on the drawing in (a), above.

THE DISCREPANCY IS SHOWN ON THE DRAWING.

(E) Was the corner reestablished through lost corner proportionate methods? If so, show the method, including the directions and distances to other public land survey corners used as evidence or used for proportioning the corner location.

YES THE E 1/4 COR SEC 24 UNION TWP WAS DECLARED IN 1868 LOST BY LOCKE'S (VOL 1 PG 329 & #3607).

I, **Donald Barnes**, hereby certify that the corner location as identified by the corner code index was determined by me under my direction and control and that this U.S. Public Land Survey Monument Record is correct and complete to the best of my knowledge and belief.

SHEET 3 OF 4

corner code P-25(1)

A.E. 7.08 REQUIREMENT

Donde Baines Nov1, 2011

