Paper weight-110# (minimum)

Black nonfading ink required


LAND U.S. **PUBLIC** SURVEY MONUMENT RECORD

For Public Land Survey Corners In:

WI ADMINISTRATIVE CODE A-E 7.08 REQUIREMENT

T. 4 N. R. 10 E. 4th P.M.

CORNER CODE INDEX

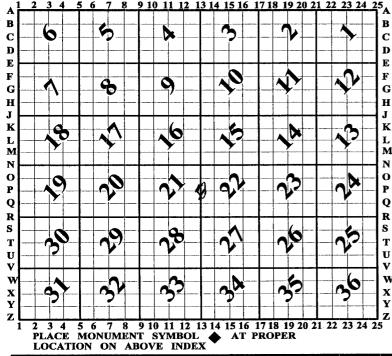

UNION TWP ROCK COUNTY WI

IF AVAILABLE ROCK COUNTY COORDINATES PERFERRED

North	Elev.
East	····
Hor. Datum	Vert. Datum
LATITUDE	ELLIPS. HT.
LONGITUDE	
NAD83(91)	NETWORK ADJ. YR 2010
GPS (X)	TRAVERSE (X) X
BASED ON THE	FOLLOWING CONTROL:

◆ CORNER MONUMENT

O WITNESS MONUMENT

(a) ROCK COUNTY PROJECTION BEARINGS ARE BASED ON:___

FIELD BOOK PAGE # OR OBSERVATION SHEET	SHEET		, 3
SHOW A PLAN VIEW DRAWING DEPICTING THE CORNER MONUMENT AND PHYSICAL FEATURES, INCLUDING THE EXCAVATION AREA AND DEPTH.	SURROUN	DING	
DE ABBURIO & ZONINO COMMITTEE ADODTED THIS FORM ON 12/2/1002		12 15	2/2/
PLANNING & ZONING COMMITTEE ADOFTED THIS FORM ON 12/21962	CODE	Y-13	>(<-/

UN577 E1/4CORSEC21

(B) Describe any record evidence, monument evidence, occupational evidence, testimonial evidence or any other material evidence you considered, and whether the monument was found or placed.

1833 HARRISON T4N R1OE 4TH MER NORTH BET. SECS 21 & 22

1279.0 RED 0.24

1789.0 CREEK 13.0' CRS SE

QUARTER SEC COR. [BURR O 24 N45E 283.8' NO OTHER NEAR BURR O 24 & BURR O 24 MARKED

5280.00 SET COR TO SECS 15,16,21,22
{BURR O 12 N81E 12.54'; BURR O 10 N31E
45.54'; BURR O 12 SBW 26.4'; BURR O 24
N59Q 129.36' LAND ROLLING 2ND RATE
TIMBER SAME MOSTLY WEEDS, GRASS.

1857 CHURCH VOL 1 PG 70 USED COR FOR SUBDIVIDING SEC 21 BUT STATES NOTHING ABOUT THE CORNER.

1870 RUGER AUG REMON-96 NORTH ON EAST LINE OF SE 1/4
SEC 21 ON A VAR 7-OO; OFFSET EAST 6.93 AT

2665.74 INTERSECTED QUARTER LINE 6.60' WEST OF QUARTER CORNER. FOUND BOTH BEARING STUMPS AND ESTABLISHED QUARTER CORNER FROM THEM.

NORTH ON EAST LINE OF NE 1/4 SEC 21 ON A VAR 7-OO; AT

2658.64 INTERSECTED NORTH BOUNDARY LINE 1.98'
EAST OF CORNER. COR VAR 7-02

- 1893 BLEEDORN VOL 2 PG 431 USED COR TO SUBDIVIDE SEC 21 BUT STATES NOTHING ABOUT CORNER.
- 1899 BROWN VOL 2 PG 512 DOESN'T STATE THE TYPE OF MON FD. CALLS FOR 2657.49 TO THE CENTER OF SEC 21 AND 5326.53 TO THE W 1/4 COR SEC 21
- 1966 FRUDDEN PLAT OF SURVEY USED THE CORNER BUT STATES NOTHING ABOUT IT. CALLS FOR 2617.00 TO THE CENTER OF SEC 22 AND 71.30 TO PROPERTY CORNER ALONG THE R/R R/W.
- 1972 THOUSAND CSM VOL 3 PG 4 PLACED A IRON PIPE
- 1977 TALARCZYK CSM VOL 7 PG 10 FD 1" PIPE
- 1982 COMBS #5173 FD IRON PIN
- 1982 BARNES VOL 6-288 SHOWS REC DISTANCES
- 1990 BARNES P-13 SET POLY MON. 2664.00 TO NE COR SEC 21, 2672.10 TO SE COR SEC 21, & 0.79 WEST OF LINE BETWEEN SE & NE CORNERS OF SEC 21. REFERENCED SAME. FD A 1/2 PIN AND A 1 1/4 PIN. FD SEVERAL PIECES OF THE TOP OF THE CUT LIMESTONE ON TOP OF GROUND ABOUT 15" TO THE NW OF THE 1 1/4 PIN. FD SEVERAL PIECES OF THE CUT LIMESTONE 15" DEEP AT AND WEST OF THE 1/2 PIN. DUG & FOUND BOTTOM OF THE CUT LIMESTONE. 0.88' NORTH OF THE 1/2" PIN. PLACED POLY MON ON TOP OF STONE & CARSONITE ON NORTH SIDE.
- 1991 COMBS CSM VOL 15 PG 191 POLY 2664.0X TO STONE @ NW COR SEC 22
- 1991 COMBS CSM VOL 15 PG 194 FD POLY NO-15-55E 2664.0X TO NE COR SEC 21
- 1991 COMBS #11803 FD POLY MON 2664.0X TO STONE MON @ NE COR SEC 21
- 2000 BARNES P-13(1) ACCEPTED COR OF REC.
- 2000 BARNES 6-456 POLY MON ON TOP OF LS. 310,078.18; 416,457.90. NO-09-05W 2663.99 TO NW COR SEC 22, SO-11-08E 2672.07 TO SW COR SEC 22.
- 2001 COMBS #14214 FD ALUM. MON. 2639.02 TO R/R SPIKE @ CENTER OF SEC 22. FD IRON PIN SO-0950W 72.12 (REC 71.3') ON EAST R/W OF RAIL ROAD. SHOWS COR AS EAST OF R/R ROW.

SHEET 1 OF 3

CORNER CODE P-13(2)

Barres Nov 1, 2011

FD POLY & TIES

C) Was the corner restored through acceptance of (1) an obliterated evidence location, or, (2) a found perpetuated location?

ACCEPTED FD POLY., WHICH PERPETUATES CUT LIMESTONE.

D) Describe any material discrepancy between the location of the corner as restored or reestablished and the location of that corner as previously restored or reestablished by distance and direction. Show the discrepancy on the plan view drawing under (a), above. Show the distances between the corner as previously restored or reestablished and (1) the corner as restored or reestablished, and (2) to at least 4 of the witness monuments shown on the drawing in (a), above.

NONE

Daves Earls Worl, 2011

(E) Was the corner reestablished through lost corner proportionate methods? If so, show the method, including the directions and distances to other public land survey corners used as evidence or used for proportioning the corner location.

NΠ

I, **Donald Barnes**, hereby certify that the corner location as identified by the corner code index was determined by me under my direction and control and that this U.S. Public Land Survey Monument Record is correct and complete to the best of my knowledge and belief.

SHEET 2 OF 3

CORNER CODE P-13(2)

A.E. 7.08 REQUIREMENT

RERDD N86-50-34E 5.28 POLY S84-41-01E 5.64 POLY N89-37-36E 21.60 1990 BARNES POLY \$87-24-35E 21.62 1990 REROD N84-44-10E 5.23 1990 POLY N89-23-25E 5.64 ### 1990 PIN N89-30-48E 22.02 1990 PILY N89-22 EC 21 UNION TWP 1980 PIN REPORT TO THE PROPERTY OF THE PROPERTY PIN S88-14-50E 21.98 1990 PIN N89-30-48E 22.02 PDLY N0-19-25E 1990 N1-54-14W REROD REROD 1 1/4 PIN SHEET 3 DF 3 1990 BARNES P-13 DBSERVATION SHEET TEXT865 EMBUSSER 63, 217, 393, 251, 352, 865 1/2 RERUD 8 NOV3,2011