

U.S. PUBLIC LAND SURVEY MONUMENT RECORD

For Public Land Survey Corners in the T. 2 N., R. 12 E.

CORNER CODE INDEX

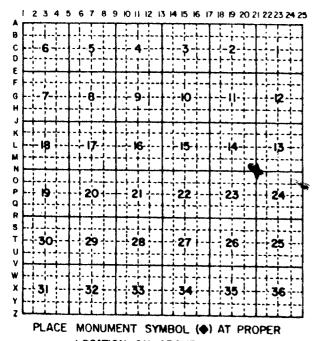


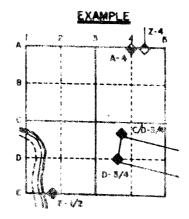

ROCK COUNTY WE

IF AVAILABLE STATE PLANE COORDINATES

North		Eleve. (Z)
East	(X)	Zone
Hor,	Datum	Vert Datum

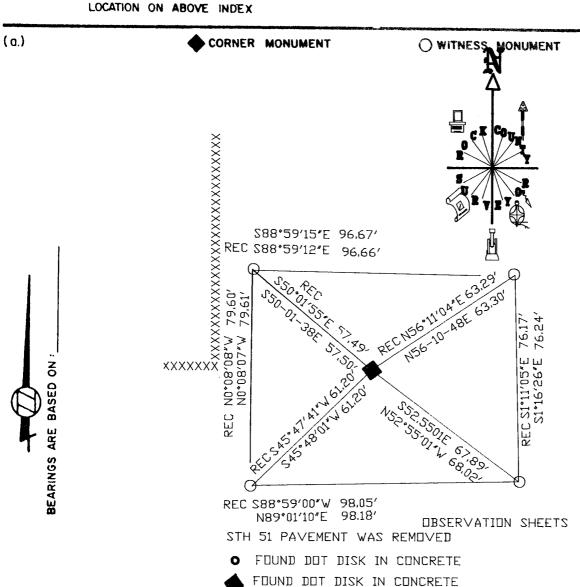

FIELD BOOK ____ PAGE #

MICROFILMED

SHOW A PLAN VIEW DRAWING DEPICTING THE CORNER MONUMENT AND SURROUNDING PHYSICAL FEATURES, INCLUDING THE EXCAVATION AREA AND DEPTH. THE CORNER MONUMENT SHALL HAVE THE FOLLOWING CHARACTERISTICS: 1) HAVE AT LEAST TWO PREDETERMINED BREAK-OFF POINTS. 2) IF BROKEN, LEAVE A PERMANENTLY MAGNETIZED REMNANT AT THE ORIGINAL POINT. 3) MUST BE EXTENDABLE. 4) THE CAP IS INSCRIBED: ROCK COUNTY SURVEY MONUMENT - PENALTY FOR DISTURBING MARKER. 5) OR AN EXISTING CUT LIMESTONE. AN IRON PIPE 1/2 x 4'0" (MINIMUM) MAY BE USED IN AREAS WHERE GHOUND WATER IS WITHIN ONE FOOT OF THE SURFACE. IF THE CORNER IS OCCUPIED BY AN IMPROVEMENT (MANHOLE, BURIED CABLE, ETC.) ANY DURABLE, DISTINCT MONUMENT MAY BE USED. CORNERS SHALL BE REFERENCED WITH AT LEAST 4 DURABLE WITNESS MONUMENTS. WITNESS MONUMENTS SHALL BE MADE OF CONCRETE, NATURAL STONE, IRON OR OTHER EQUALLY DURABLE MATERIAL, EXCEPT WOOD. DESCRIBE THE CORNER AND THE WITNESS MONUMENTS.

N 2/(3)

- Describe any record evidence, monument evidence, c mal evidence, testin /idence or any other evidence you considered, and whether the monument was found or 1836 LYON SET POST TO SEC'S 13,14,23,34 AND MADE MOUND OF EARTH AND SOD 4 FEET SQUARE AND 2 1/2' FEET HIGH.
 1876 RUGER VOL 2 PG 217 FOUND WHERE OLD STAKE HAD BEEN IN THE GROUND. DROVE NEW STAKE IN PLACE OF OLD ONE AND PUT LIMESTONES ON NORTH AND SOUTH SIDES. SHOWS 2645.94 TO E 1/4 CORNER OF SECTION 23. 1880 LEE VOL 2 PG 314 FOUND STAKE AND STONES AT CORNER SET BY RUGER. SHOWED 2642.64' TO E 1/4 CORNER SECTION 14. 1890 BLEEDORN VOL 2 PG 434 FOUND CORNER SET BY RUGER. SHOWS A DISTANCE OF 2642.64 TO W 1/4 CORNER OF SECTION 13. 1919 BATTERMAN VOL 3 PG 91. MONUMENT PLOWED UP BY PAVING CONTRACTOR.
- 1941 SUNNY VOL 3 PG 469 COPPER PLUG AND CROSS CUT IN CEMENT. 1" PIPE IN MONUMENT BOX 1966. SHOWS 2654.2 TO N 1/4 COR
- SEC 23 AND 2650.2 TO E 1/4 COR SEC 23. 1959 BATTERMAN VOL 3 PG 574. 5/16" IRON PIN 12.08' FROM WEST EDGE OF PAVEMENT. SET 1" PIPE IN MONUMENT BOX 1966. REFERENCED SAME.
- 1975 SCHROEDER VOL 5 PG 60 5/16 IRON PIN 12.08 FROM WEST EDGE OF
- PAVEMENT.; SHOWS REFERENCE TIES.
 1975 SCHROEDER VOL 5 PG 61. SHOWS 3/16TH IRON PIN.
- 19?? HURD N/S 230,406.64; E/W 2.260,806.45 1989 BARNES VOL 6 PG 394 SHOWS THE FOLLOWING DISTANCES

N 1/4 COR SEC 24

S89-45-41E 2645.81 BATTERMAN 1961 2647.12

TO W 1/4 COR SEC 24

S1-12-39E 2650.46

COMBS 1973 2650.20

BATTERMAN 1938 2650.36

1989 BARNES VOL 6 PG 395 N/S 230,405.22; E/W 2,260,806.44 SHOWS THE FOLLOWING DISTANCES:

W 1/4 COR SEC 13

NO-47-55W 2639.53

NW COR OF SW 1/4 OF SW 1/4 SEC 13 BATTERMAN 1961

S 1/4 COR SEC 13

1318.84 S89-45-41E 2645.81

BATTERMAN 1961

1989 BARNES VOL 6 PG 396 SHOWS THE FOLLOWING DISTANCES:

TO: N 1/4 COR SEC 23

N89-26-46E 2654.28

BATTERMAN 1958 2654.30 S1-12-39E 2650.46

E 1/4 COR SEC 23 1992 BARNES N21(2) FOUND 1" PIPE IN MONUMENT BOX

FOUND DOT DISK IN CONCRETE

Was the corner restored through acceptance of (1) an obliterated evidence location, or, (2) a found perpetuated location? ACCEPTED FOUND MONUMENT.

I, Donald Barnes, hereby certify that the corner points as identified by the corner code index were, in a field survey on, Pec / 1992 , established, re-established, monumented, re-monumented, recovered or restored as expressed below and in conformance with the regulations and rules as required in the current manual of survey instructions of the United States Department of Interior, Bureau of Land Management.

	COUNTY SURVEYOR FILING DATA
seal	Date of computer entry
	Date microfilmed
	Number of included sheets
ald Danes	CORNER CODE AFFIX YOUR LAND SURVEYOR SEAL