

PUBLIC LAND SURVEY MONUMENT RECORD


For Public Land Survey Corners in the
T. 4 N., R. 10 E.

CORNER CODE INDEX

	1	2	3	4	5	6	7	8	9	10	11	12	13	14	15	16	17	18	19	20	21	22	23	24	25
A																									
B																									
C	8																								
D																									
E																									
F																									
G	7	6																							
H																									
I																									
J																									
K																									
L	6	5	4	3	2																				
M																									
N																									
O																									
P	5	4	3	2	1																				
Q																									
R																									
S																									
T	30	29	28	27	26	25																			
U																									
V																									
W																									
X	31	32	33	34	35	36																			
Y																									
Z																									

PLACE MONUMENT SYMBOL (◆) AT PROPER LOCATION ON ABOVE INDEX

EXAMPLE

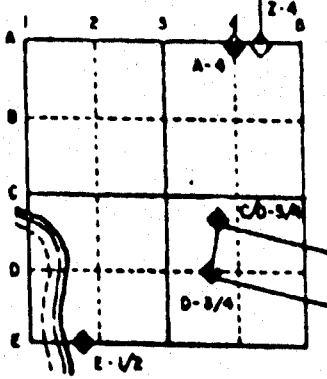

UNION TWP
ROCK COUNTY WI

IF AVAILABLE
STATE PLANE COORDINATES

North (Y) _____ Elev. (Z) _____
East (X) _____ Zone _____
Hor. Datum _____ Vert. Datum _____

◆ CORNER MONUMENT

○ WITNESS MONUMENT

BEARINGS ARE BASED ON

SHEET _____ OF _____

CORNER CODE: R1512

(B) Describe any record evidence, monument evidence, occupational evidence, testimonial evidence or any other material evidence you considered, and whether the monument was found or placed.
FOUND ALLUMINUM MONUMENT INSIDE MONUMENT BOX.

C) Was the corner restored through acceptance of (1) an obliterated evidence location, or, (2) a found perpetuated location?
ACCEPTED FOUND MONUMENT. ROAD CONSTRUCTION WILL DISTURB AREA.

D) Describe any material discrepancy between the location of the corner as restored or reestablished and the location of that corner as previously restored or reestablished by distance and direction. Show the discrepancy on the plan view drawing under (a), above. Show the distances between the corner as previously restored or reestablished and (1) the corner as restored or reestablished, and (2) to at least 4 of the witness monuments shown on the drawing in (a), above.

(E) Was the corner reestablished through lost corner proportionate methods? If so, show the method, including the directions and distances to other public land survey corners used as evidence or used for proportioning the corner location.

NO

I, Donald Barnes, hereby certify that the corner points as identified by the corner code index were, in a field survey on, May 1, 1994, established, re-established, monumented, re-monumented, recovered or restored as expressed below and in conformance with the regulations and rules as required in the current manual of survey instructions of the United States Department of Interior, Bureau of Land Management.

seal
Donald Barnes

COUNTY SURVEYOR FILING DATA

Date of computer entry _____

Date microfilmed _____

Number of included sheets 1 _____

CORNER CODE

AFFIX YOUR LAND SURVEYOR SEAL

R15(2)

SET 3/4X24"
REROD

S89-00-00E 79.91

FD PIN 24.18
N76-58-30E

REC 38.77
S52-41-37E 38.32

REC 54.16
54.02
N66-09-58E

N69-30-08E 77.90
REC 77.88

FD ALUM. MON.
INSIDE MON. BOX

FD 1/2" PIPE

N1-52-14E 134.37

N17-25-37E 116.42

N11-55-29E 179.92

FD PIN

REC 65.06
N2-02-08E 65.00


FD PIN

SIDEWALK

N28-26-49E 231.23

STH 14

S 1/4 COR
SEC 22

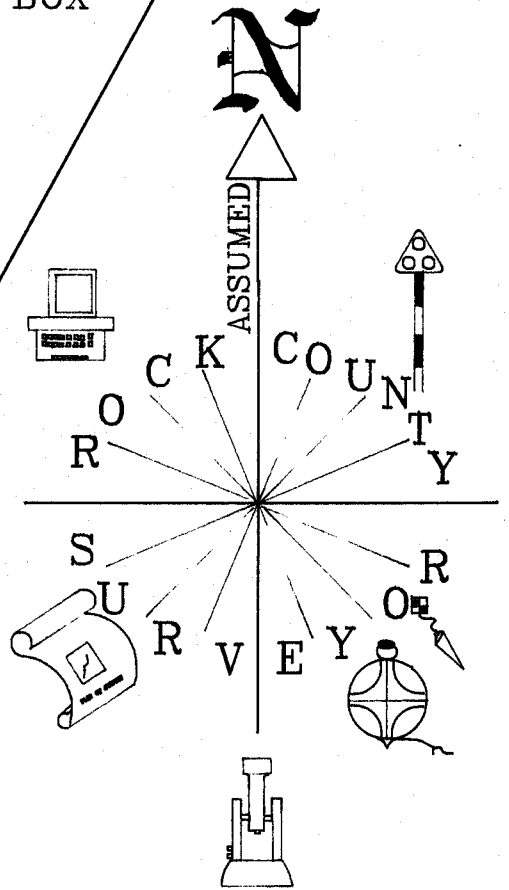

CENTER TWP
FIELD BOOK#2 PG 25

2 OF 2

Ronald Barnes
JUNE 1, 199A

R 15(2)