

Paper weight-110# (minimum)      Black nonfading ink required

# U.S. PUBLIC LAND SURVEY MONUMENT RECORD

For Public Land Survey Corners In:  
**T. 4 N. R. 10 E. 4th P.M.**  
 CORNER CODE INDEX

WI ADMINISTRATIVE CODE A-E 7.08 REQUIREMENT  
 REV 10/23/2004      USMONREC.DWG

UNION TWP  
**ROCK COUNTY WI**

IF AVAILABLE  
 ROCK COUNTY COORDINATES PREFERRED

A	1	2	3	4	5	6	7	8	9	10	11	12	13	14	15	16	17	18	19	20	21	22	23	24	25	A
B			6				5					4				3				2				1		B
C																										C
D																										D
E																										E
F																										F
G																										G
H																										H
J																										J
K																										K
L																										L
M																										M
N																										N
O																										O
P																										P
Q																										Q
R																										R
S																										S
T																										T
U																										U
V																										V
W																										W
X																										X
Y																										Y
Z																										Z

North \_\_\_\_\_ Elev. \_\_\_\_\_

East \_\_\_\_\_

Hor. Datum \_\_\_\_\_ Vert. Datum \_\_\_\_\_

LATITUDE \_\_\_\_\_ ELLIPS. HT. \_\_\_\_\_

LONGITUDE \_\_\_\_\_

NAD83(91) \_\_\_\_\_ NETWORK ADJ. YR 2010 \_\_\_\_\_

GPS (X) \_\_\_\_\_ TRAVERSE (X) X

BASED ON THE FOLLOWING CONTROL:

PLACE MONUMENT SYMBOL **◆** AT PROPER LOCATION ON ABOVE INDEX

**◆** CORNER MONUMENT

**○** WITNESS MONUMENT

BEARINGS ARE BASED ON: ----- ROCK COUNTY PROJECTION

FIELD BOOK \_\_\_\_\_ PAGE # \_\_\_\_\_  
 OR OBSERVATION SHEET \_\_\_\_\_

SHEET 2 / OF 3

SHOW A PLAN VIEW DRAWING DEPICTING THE CORNER MONUMENT AND SURROUNDING PHYSICAL FEATURES, INCLUDING THE EXCAVATION AREA AND DEPTH.

PLANNING & ZONING COMMITTEE ADOPTED THIS FORM ON 12/2/1982

CORNER CODE G-9(2)

UN536 W 1/4CORSEC9

(B) Describe any record evidence, monument evidence, occupational evidence, testimonial evidence or any other material evidence you considered, and whether the monument was found or placed.

- 1833 (NOV) HARRISON (NOV 9) T4N R10E 4<sup>TH</sup> MER. NORTH  
BETWEEN 8 & 9  
13.2 ROAD S.W  
2640.00 QUARTER SEC COR {BURR O 12 N54W 26.4';  
BURR O 12 N81E 27.72'  
5280.00 SEC COR TO SECS 4,5,8,9 {BURR O 12 S70E  
44.88'; BURR O 10 S84W 46.2'; BURR O 10 S84W  
44.22'; BURR O 12 N28E LAND LEVEL 2ND RATE  
TIMBER ALL BURR O. UNDERGROWTH GRASS &  
WEEDS.
- 1856 CHURCH VOL 1 PG 58 STATES NOTHING ABOUT MON. USED  
TO SUBDIVIDE SEC 8. 2653.2 TO NE COR SEC 8, VAR 8  
2682.57 TO CENTER OF SEC 8, & 5365.14 TO W 1/4 COR SEC  
8.
- 1859 RUGER VOL 1 PG 116 & 5108 STATES NOTHING ABOUT  
MON. VAR 8-23 2673.66 TO CENTER OF SEC 9
- 1870 RUGER AUG REMON-120 SOUTH ON WEST LINE OF NW  
1/4 SEC 9 ON A VAR 6-35; OFFSET EAST 19.8'  
OFFSET EAST 7.26 OFFSET WEST 7.92' OFFSET  
EAST 3.30' AT  
2654.52 INTERSECTED QUARTER LINE 8.58' EAST OF  
QUARTER CORNER. FOUND OLD STAKE AT  
CORNER. ALSO FOUND STUMPS OF BEARING  
TREES. COR VAR 6-53'  
SOUTH ON WEST LINE OF SW 1/4 SEC 9 ON A  
VAR 7-10; OFFSET EAST 11.88' AT  
2644.62 INTERSECTED SOUTH BOUNDARY LINE 11.88'  
EAST OF CORNER. SEPTEMBER 8 1870
- 1890 BLEEDORN VOL 2 PG 429 & #5101 MON. VAR 5-15 2753.52  
TO CENTER OF SEC 8 & 5463.48 TO MON @ W 1/4 COR SEC  
8.
- 1964 BATTERMAN VOL 4 PG 194 FD CUT STONE WITH TOP  
BROKEN OFF. REFERENCED SAME. ON LINE WITH N/S  
FENCE LINES.
- 1964 LEE #5109 DUG & FD 6X6 CUT STONE MON
- 1972 WEIR CSM VOL 2 PG 259 STATES NOTHING ABOUT MON.  
USED W 1/4 COR SEC 8 FOR LINE.
- 1974 GRENLIE CSM VOL 4 PG 148 W 1/4 COR SEC 9 FD CUT  
STONE & E 1/4 COR SEC 9 FD CUT STONE.
- 1974 GRENLIE CSM VOL 4 PG 194 W 1/4 COR SEC 9 FD CUT  
STONE & E 1/4 COR SEC 9 FD CUT STONE.
- 1974 GRENLIE CSM VOL 4 PG 195 W 1/4 COR SEC 9 FD CUT  
STONE & E 1/4 COR SEC 9 FD CUT STONE.
- 1979 BARNES VOL 5 PG 528 SO-11-47W 2651.00 TO SE COR SEC  
8.
- 1986 SARKO CSM VOL 12 PG 360 PK SET PER COUNTY TIES.  
USED PK SET @ W 1/4 COR SEC 8 FOR LINE
- 1988 BARNES G-9 REFERENCED SAME. FD ALL 4 REFERENCE  
MONUMENTS WITH NW & NE REFERENCE PIPES LEANING. FD  
PK @ PVMT CENTER & ON N/S FENCE LINE ON SOUTH SIDE  
OF RD.
- 1988 BARNES #12708 FD PK S88-57-18W 2762.24 TO INT OF 1/4  
LINES & S88-57-18W 5474.78 TO W 1/4 COR SEC 8
- 1989 MILLER #12209 STATES NOTHING ABOUT MONUMENT BUT  
SHOWS IT AS A SOLID TRIANGLE. S89-40-36W 2788.44 TO  
N/S 1/4 LINE OF SEC 8
- 1994 KARNS CSM VOL 18 PG 325 ALUM. MON. N89-51-50E  
2680.16 TO ALUM @ CENTER OF SEC 9

SEAL  
Donald Barnes  
Emboss

SHEET 2 OF 3

JUNE 20, 2011

CORNER CODE G-9(2)

UN536 W 1/4CORSEC9

2009 COMBS G-9(1) USED REFERENCE MONUMENTS & TIE SHEET  
G-9 DATED JAN 11, 1988 TO SET PK 2680.09 TO ALUM @  
GEN OF SEC 9. REFERENCED SAME. FD ALL REFERENCE  
MONUMENTS WITH NE & NW REFERENCE PIPES LEANING.

2009 COMBS CSM VOL 33 PG 138 SET PK MASONRY NAIL 2680.09  
TO ALUM @ CENTER OF SEC 9

FD NEWER PK JUST UNDER PVMT SURFACE & FD OLD PK 0.05'  
DEEPER. NEWER PK WAS PROBABLY ALONG NORTH TOP OF OLD PK.

*C) Was the corner restored through acceptance of (1) an obliterated evidence location, or, (2) a found perpetuated location?*

ACCEPTED OLD PK.

*D) Describe any material discrepancy between the location of the corner as restored or reestablished and the location of that corner as previously restored or reestablished by distance and direction. Show the discrepancy on the plan view drawing under (a), above. Show the distances between the corner as previously restored or reestablished and (1) the corner as restored or reestablished, and (2) to at least 4 of the witness monuments shown on the drawing in (a), above.*

*(E) Was the corner reestablished through lost corner proportionate methods? If so, show the method, including the directions and distances to other public land survey corners used as evidence or used for proportioning the corner location.*

NO

I, **Donald Barnes**, hereby certify that the corner location as identified by the corner code index was determined by me under my direction and control and that this U.S. Public Land Survey Monument Record is correct and complete to the best of my knowledge and belief.

  
DEAL

June 20, 2011  
Emboss

SHEET 2 OF 3

CORNER CODE G-9(2)  
A.E. 7.08 REQUIREMENT

E 1/4 COR  
SEC 8

OBSERVATION SHEET #536

UNION TWP  
T4N R10E

FD 3/4 PIPE  
LEANING TO  
THE SOUTH EAST

FD BENT PIPE

2009 N81-56-18E 47.35  
2009 N82-25-34E 47.35  
1964 N82-25-34E 47.92  
2009 S19-35-34E 54.92  
2009 S19-05-16E 54.92  
1964 S19-05-16E 54.97

2009 N37-25-10E 38.71  
2009 N36-56-07E 38.71  
1964 N37-25-10E 39.30  
1988 N37-25-10E 39.30  
2009 N37-25-10E 39.30

2009 S0-08-56E 48.64  
2009 S0-20-33E 48.64  
1964 S43-40-05E 34.06  
1988 S43-40-05E 33.92  
2009 N44-07-56W 33.90  
2009 N43-47-39E 33.70  
1964 N44-17-43E 33.70  
1988 N44-17-43E 33.70

W. UNION RD


FD PK  
.05' DEEP

2009 S63-00-01E 46.67  
2009 S63-31-02E 46.57  
1964 S63-00-01E 46.57  
1988 S63-31-02E 46.57  
2009 S63-00-01E 46.58

2009 N43-47-39E 33.70  
1964 N44-17-43E 33.70  
1988 N44-17-43E 33.70  
2009 S87-22-51W 65.11  
1964 S87-22-51W 65.11  
1988 S87-22-51W 65.11  
2009 N86-53-03E 65.11  
1964 N86-53-03E 65.11

FD 3/4 PIPE

FD 3/4 PIPE

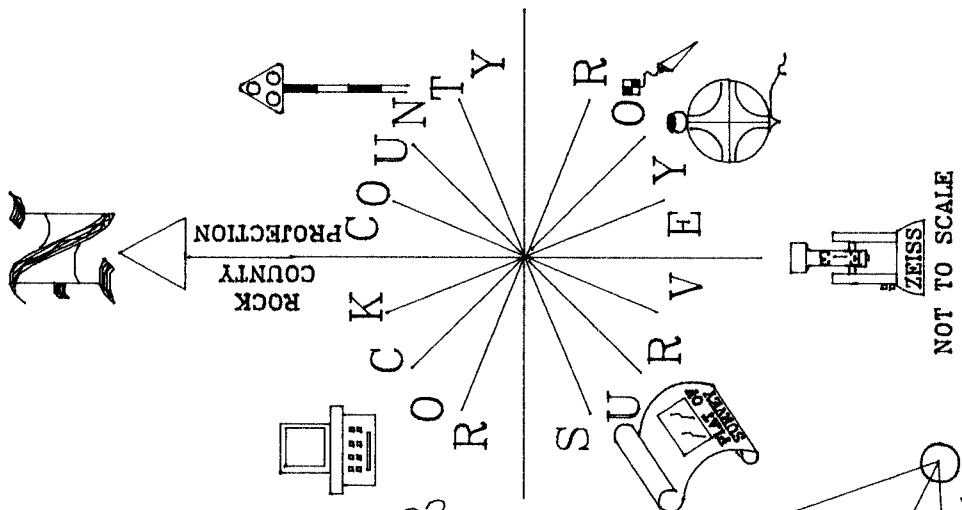

NOT TO SCALE

EMBOSSSED  
SEAL

*Ronald Barnes*

June 20, 2011

SHEET 3 OF 3

G-9(2)