


A Record and Plat of a survey made on Sec 16 Town 3 Range 13 East of the 4th Principal Meridian for School district N in the Town of Harmony

The above survey was made on the 28th of January 1859 by Edward Ruger County Surveyor of Rock County Wisconsin

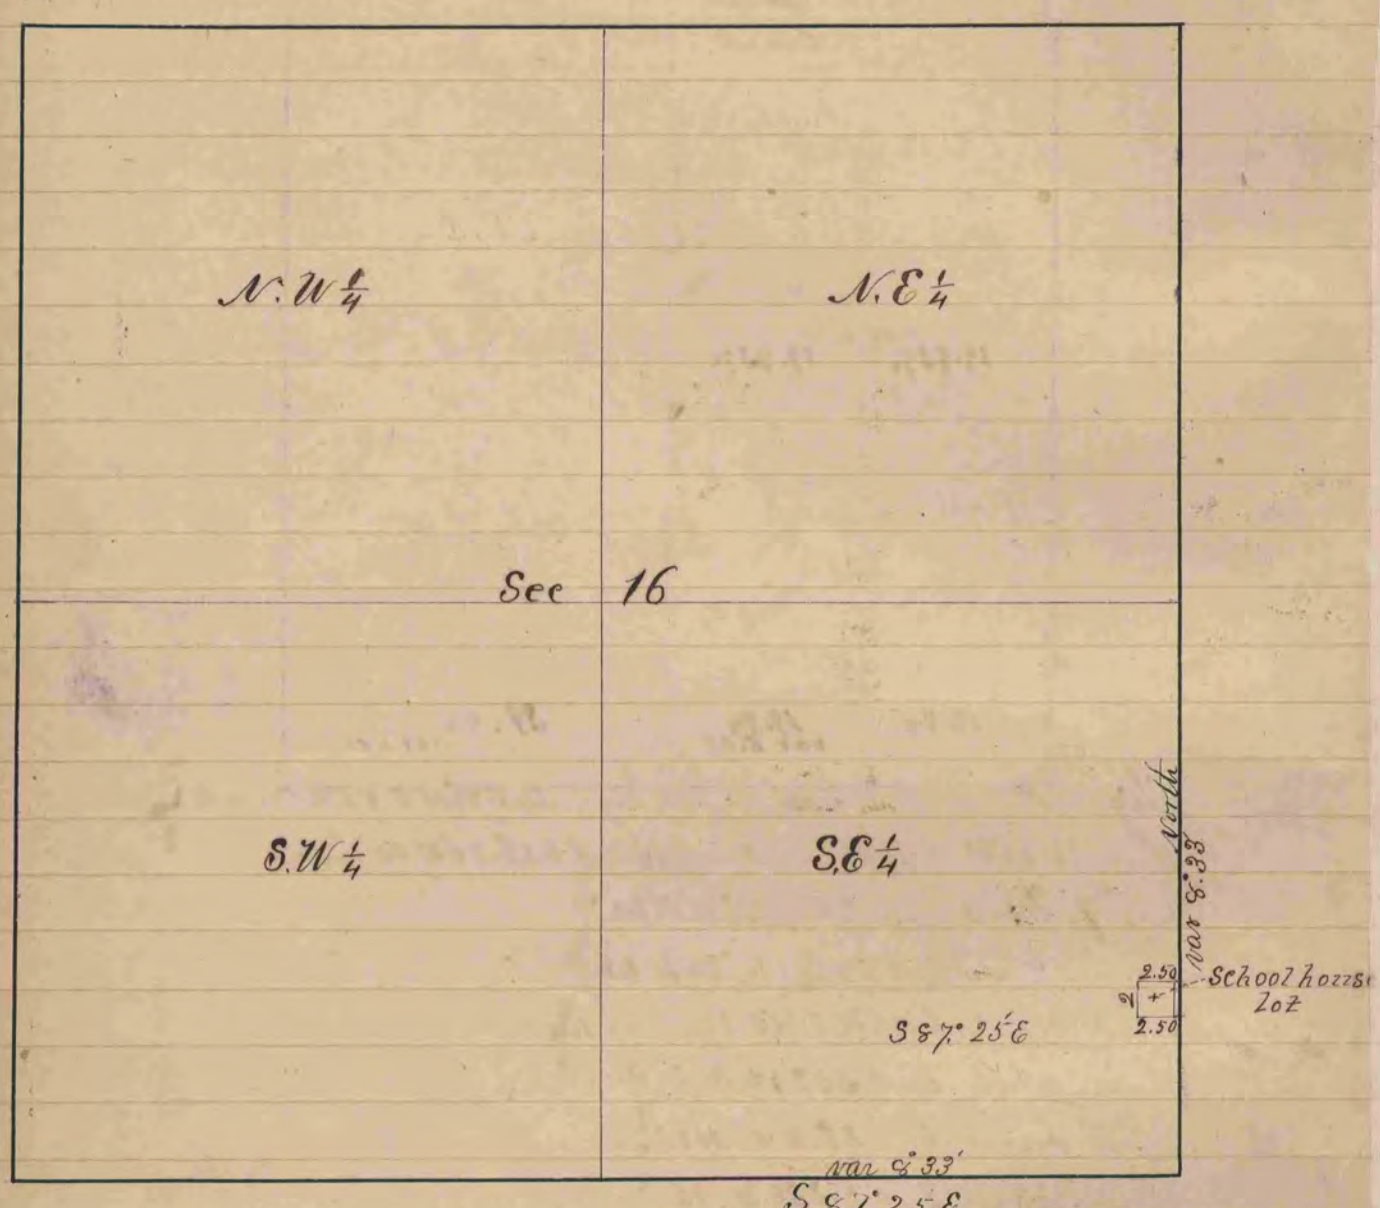

+ Represents the School House Lot of the district above referred to distances given in chains