



Set stake on line A. B. to build N. S. fence by
 but not to mark any corner as I did not
 chain that line. S. W. Locke

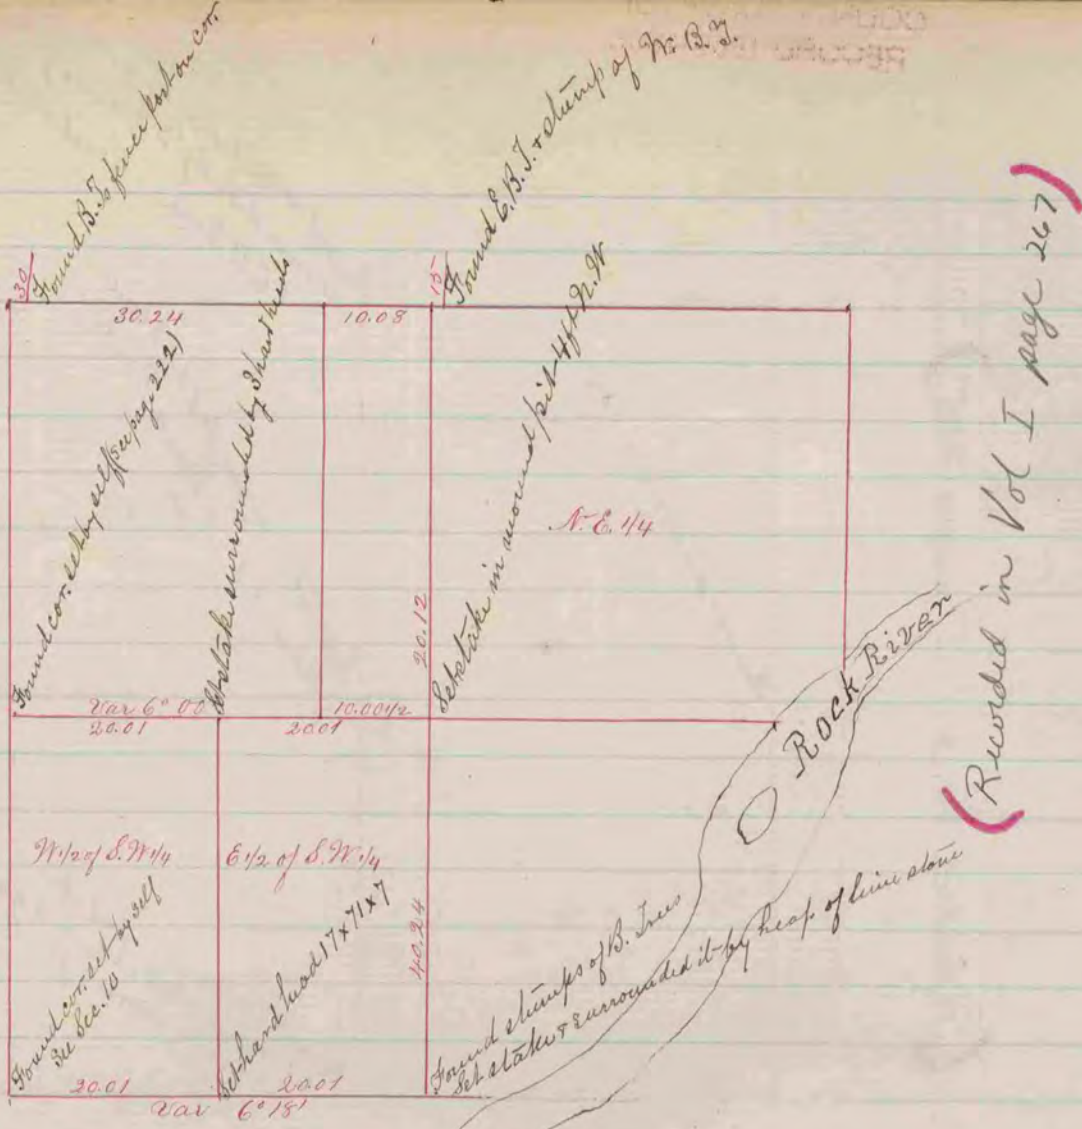

The above is a correct Record & Plat of a survey
 made by me July 6. 1866, on Sec. 3, Township of Rock
 S. W. Locke Co. Surveyor

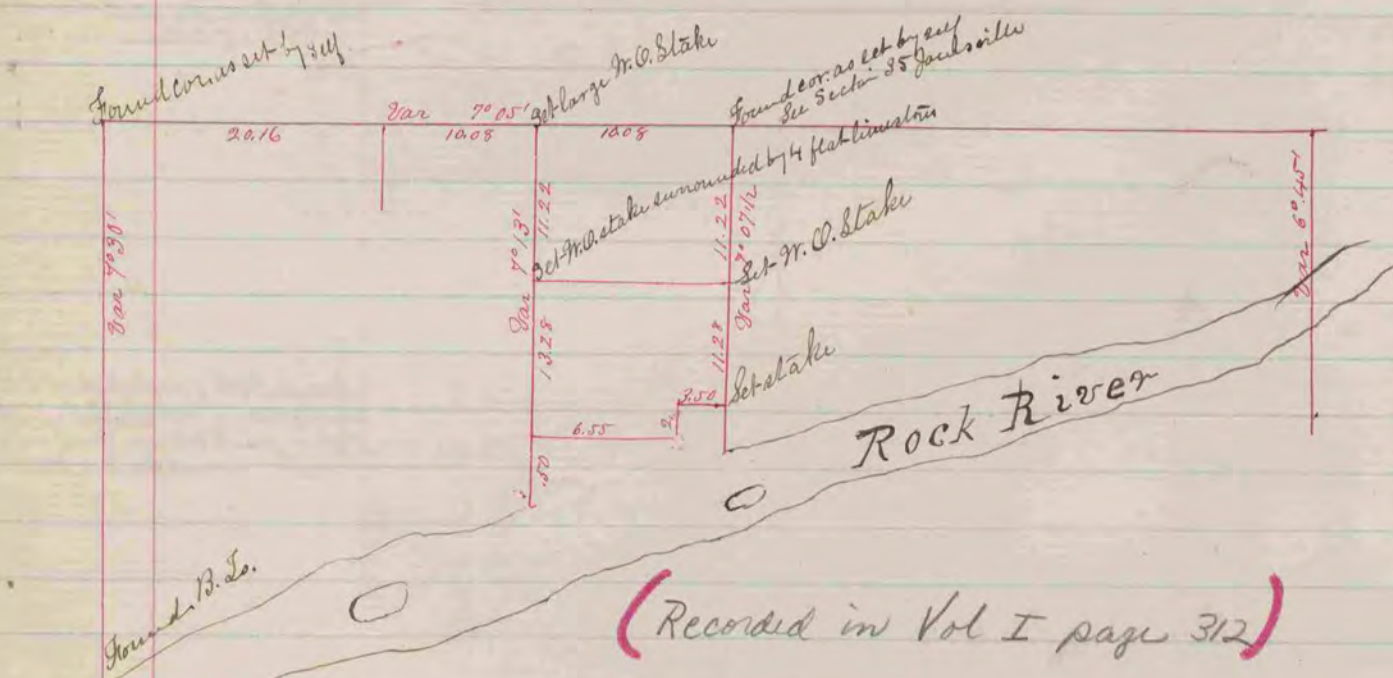

The above is a correct Record & Plat of a survey
 made by me March 14, 1868 on Sec. 2, Township of Rock
 S. W. Locke Co. Surveyor