


Fig 13. Represents the centre of the Section  
" " Br. C. 12 N. 9 1/2 W. 29. Also Br. C. 10 N. 65 1/2 W. 76

A Plat of a survey made on Sec. 25 - T. 1. R. 10  
Avon. June 6<sup>th</sup> - 1854

Peter M. Bean Co. Surveyor

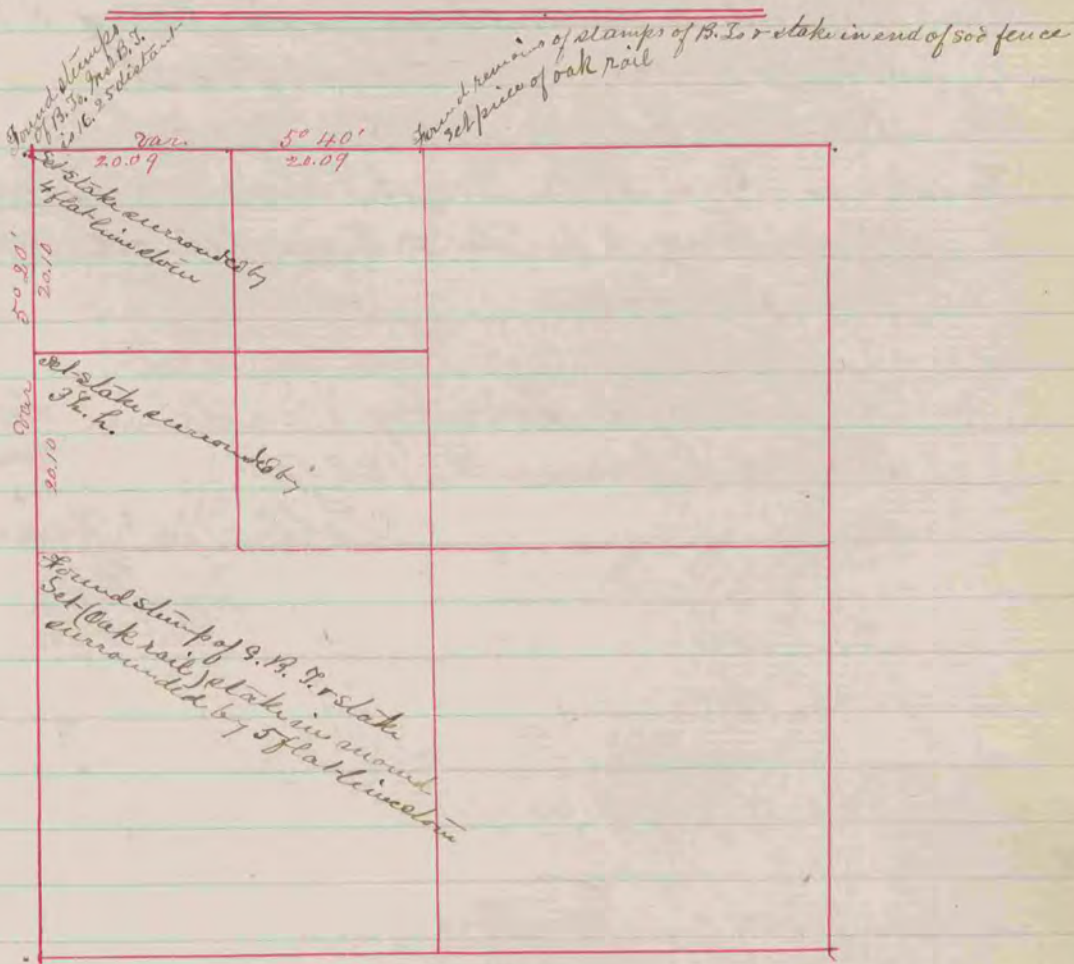

The above is a correct Record & Plat of a  
survey made on Sec. 11. Avon.

S. H. Locke Co. Surveyor