

62
A record and plat of a survey made on the 5th day of March
four thousand 1856

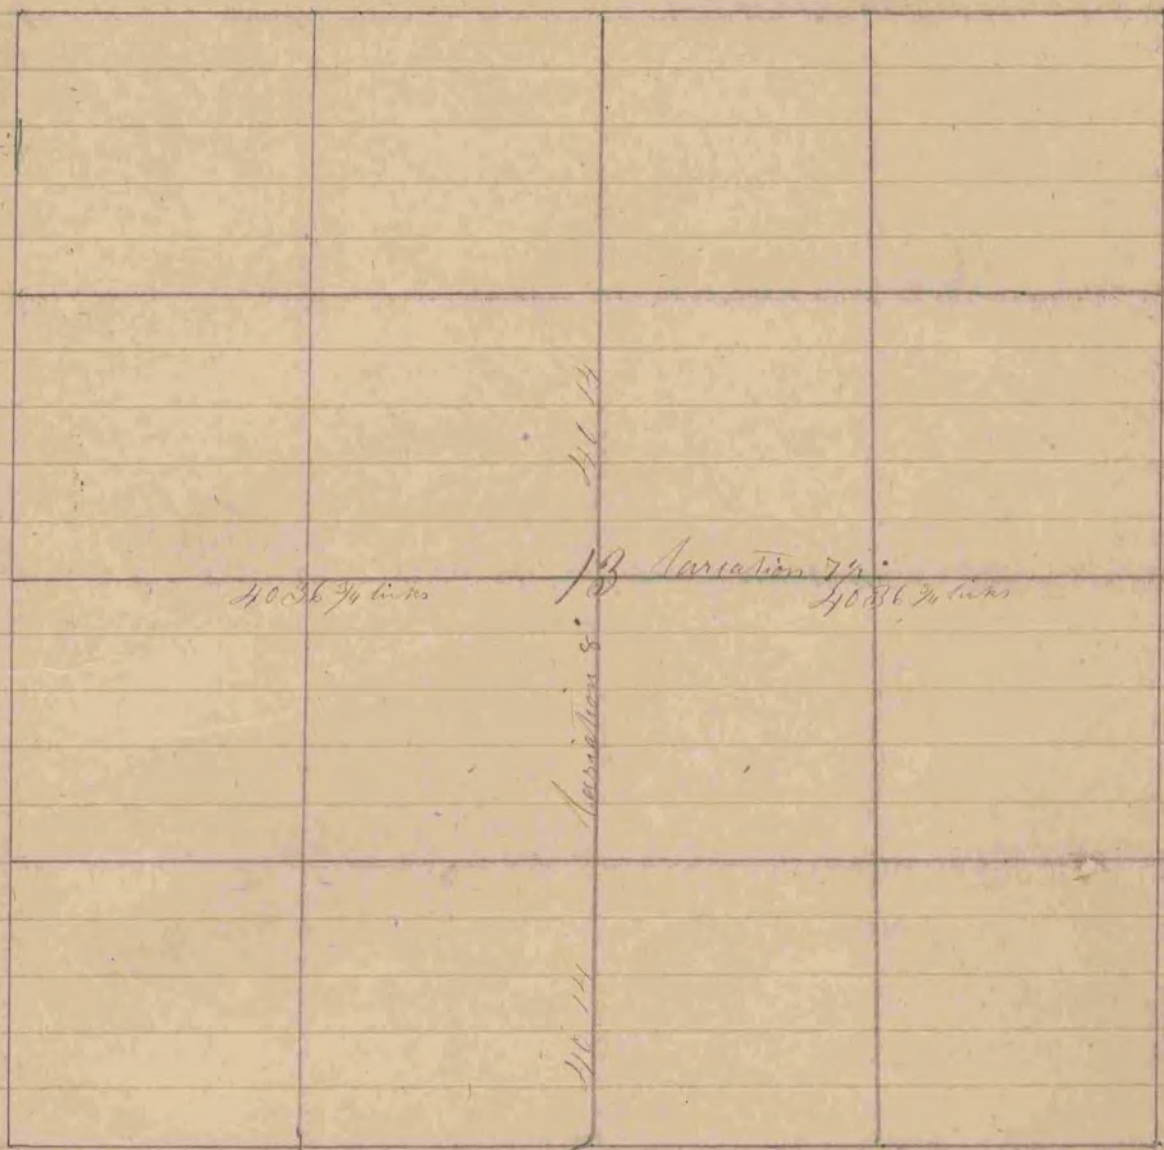


Fig 13 Represents the center of the Section
W to Fig 13 S 10 of 40 W 110
.. 20 S 55 W 215

The above Survey was made March 5th 1856,
Joseph Church
County Surveyor
North County, Mo.