


REC VOL 1 PG 24

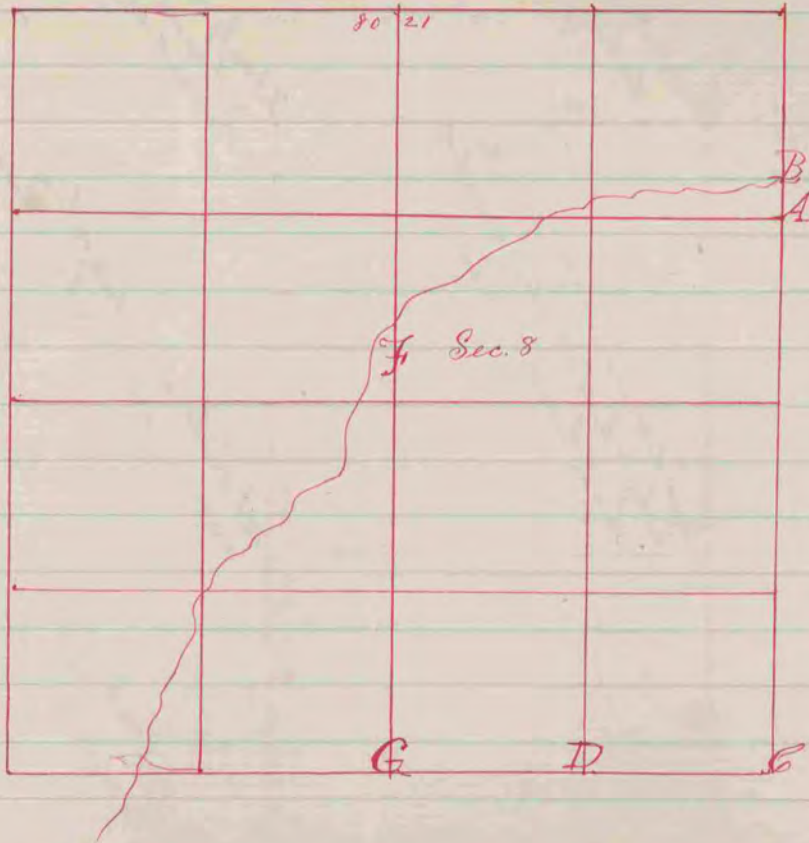

A Plat of a survey made on Sec. 8, T. 1. R. 13  
 Turtle

- Letter A Represents the S. E. Cor. of the N. E. q. of the N. E. q. Sec. — C. D. & G are on the Sec. line at the corners of the different forty's B. E & F represent the lines of forty's and the centre of Turtle Creek from B to C. measures 62 chs. & 30 lks.
- |               |      |        |
|---------------|------|--------|
| from C to G " | 39 " | & 35 " |
| " D to E "    | 63 " | & 35 " |
| " G to F "    | 54 " | & 35 " |

Letter A Br C. 10 S 72 1/2 W 52 no other  
 The above survey was made June 1<sup>st</sup> 1854  
 Peter McDean Co. Surveyor

COUNTY SURVEYOR  
 RECORD 1859-1906

COUNTY SURVEYOR  
 RECORD 1859-1906