Paper weight-110# (minimum)

Black nonfading ink required

## U.S. PUBLIC LAND SURVEY MONUMENT RECORD

For Public Land Survey Corners In:  T	REV 10/23/2004 USMONREC.DWG  TWP  ROCK COUNTY WI  IF AVAILABLE
F G A G G A A A A A A A A A A A A A A A	F G H North Elev Elev Elev
R S T T T T T T T T T T T T T T T T T T	P LATITUDE ELLIPS. HT.  R S LONGITUDE T U V NAD83(91) NETWORK ADJ. YR W X GPS (X) TRAVERSE (X) Z BASED ON THE FOLLOWING CONTROL:
PLACE MONUMENT SYMBOL AT PROPER LOCATION ON ABOVE INDEX	) WITNESS MONUMENT

FIELD BOOK \_\_\_\_\_ PAGE # \_\_\_\_ SHEET \_\_/ OF \_\_\_\_ SHOW A PLAN VIEW DRAWING DEPICTING THE CORNER MONUMENT AND SURROUNDING

PHYSICAL FEATURES, INCLUDING THE EXCAVATION AREA AND DEPTH.

PLANNING & ZONING COMMITTEE ADOPTED THIS FORM ON 12/2/1982

BEARINGS ARE BASED ON:\_\_\_

## UN530 S1/4CORSEC2

(B) Describe any record evidence, monument evidence, occupational evidence, testimonial evidence or any other material evidence you considered, and whether the monument was found or placed.

1833 HARRISON EAST ON RAND. BET 2 & 11

2640

TEMPY 1/4 SEC

5227.2

INT. E BDY 9.9' N OF P. LAND LEVEL 2ND RATE TIMBER ALL BURR O. MOSTLY GRASS & WEEDS

WEST COR. BET. SEC 2 & 11

2613.6

QUARTER SEC COR. {BURR O 18" S37E 91.74' BURR O 18" N64W 48.84' BURR O 18 BURR O 18 NOV 7TH 1833

1870 RUGER REMON FIELD NOTES (SEPTEMBER) PG 110 WEST ON

NORTH LINE OF NE 1/4 SEC 11 ON A VAR 7-47 AT

2601.06' INTERSECTED QUARTER LINE AT QUARTER CORNER. FOUND OLD STAKE AT CORNER ALSO FOUND NORTH BEARING TREE AND STUMP OF SOUTH BEARING TREE.

WEST ON NORTH LINE OF NW 1/4 SEC 11 ON A VAR 7-30 AT

2629.77

INTERSECTED WEST BOUNDARY LINE AT CORNER. FOUND OLD STAKE AND PIECES OF IRON AT COR. ALSO FD STUMPS OF BOTH BEARING TREES.

- 1884 RUGER VOL 2 PG 387 2629.77 TO STONE MON @ SW COR SEC 2, 2601.06 TO STONE MON @ SE COR SEC 2, 2665.74 TO HH @ CENTER OF SEC 2, & 5209.51 TO STONE MON @ N 1/4 COR SEC 2.
- 1970 BATTERMAN VOL 4 PG 442 FD CUT STONE 4' DEEP.
  REFERENCED SAME. SHOWS NORTH OF CENTERLINE.
- 1970 WEIR #5127 FD CUT LS USED FOR SURVEY NEAR NE COR SEC 11.
- 1970 WEIR CSM VOL 1 PG 317 FD CUT STONE. USED FOR LOT NEAR NE COR SEC 11.
- 1971 WEIR CSM VOL 2 PG 101 CUT STONE. USED FOR SURVEY IN NE 1/4 SEC 11.
- 1975 WILHELM VOL 5 PG 161 & #7008 SET A 5/8" REBAR FROM COUNTY TIES. S89-34-27W 2636.50 TO REBAR @ SW COR SEC 2 & N89-34-27E 2607.47 TO COUNTY MON. @ SE COR SEC 2.
- 1984 BARNES E-19 FD NAIL THAT IS IN HARMONY WITH FD REC TIES.
- 1988 COMBS CSM VOL 13 PG 327
  FD MAG NAILS & REFER. MONUMENTS.
- 2008 LATHROP CSM VOL 32 PG 237 FD PK. S0-03-43E 5355.05 TO STONE @ S 1/4 COR SEC 11. S89-47-50W 33.00 TO NE COR LOT. S8947-50W 2632.81 TO NW COR SEC 11. 50.00 R/W.
- 2008 LATHROP #16081 OUT FOR MICROFILMING

PRIOR TO RESURFACING I FOUND A MAG NAIL, NORTH REF. PIPE, NW REF. BOLT, & SW REF. PIPE.

SHEET # OF 3

CORNER CODE E-19(1)

Derald Dans 8-06-2009

## UN530 S1/4CORSEC2

C) Was the corner restored through acceptance of (1) an obliterated evidence location, or, (2) a found perpetuated location?

ACCEPTED FD MAG NAIL. PERPETUATES THE FD CUT LIMESTONE.

D) Describe any material discrepancy between the location of the corner as restored or reestablished and the location of that corner as previously restored or reestablished by distance and direction. Show the discrepancy on the plan view drawing under (a), above. Show the distances between the corner as previously restored or reestablished and (1) the corner as restored or reestablished, and (2) to at least 4 of the witness monuments shown on the drawing in (a), above.

NONE

(E) Was the corner reestablished through lost corner proportionate methods? If so, show the method, including the directions and distances to other public land survey corners used as evidence or used for proportioning the corner location.

I, DONALD BARNES, hereby certify that the corner location as identified by the corner code index was determined by me under my direction and control and that this U.S. Public Land Survey Monument Record is correct and complete to the best of my knowledge and belief.


Emboss

SHEET 2 OF 3

8-06-2009

CORNER CODE E-19(1)

A.E. 7.08 REQUIREMENT

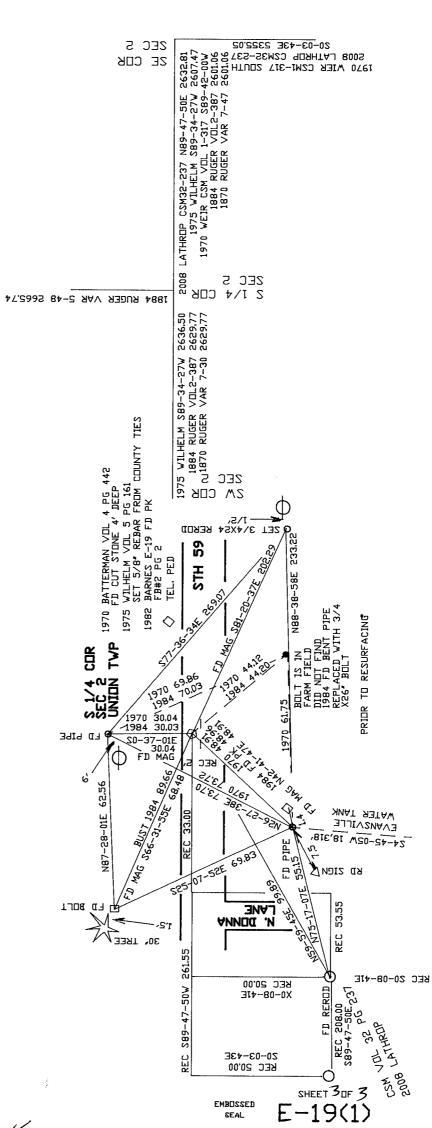

Denald Barres 8-6-2009