Paper weight-110# (minimum)

Black nonfading ink required

U.S. PUBLIC LAND SURVEY MONUMENT RECORD


For Public Land Survey Corners In:

WI ADMINISTRATIVE CODE A-E 7.08 REQUIREMENT

REV 10/23/2004 USMONREC.DWG

T. $\underline{4}$ N. R. $\underline{10}$ E. 4th P.M.

CORNER CODE INDEX

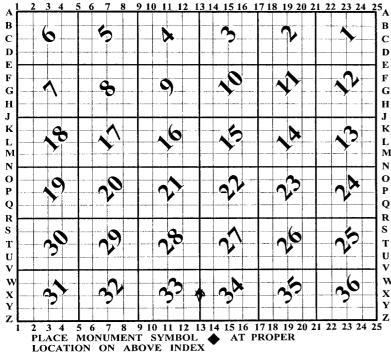

UNION TWP ROCK COUNTY WI

IF AVAILABLE ROCK COUNTY COORDINATES PERFERRED

North	Elev.
East	
Hor. Datum	Vert. Datum
LATITUDE	ELLIPS. HT
LONGITUDE	
NAD83(91)	NETWORK ADJ. YR 2010
GPS (X)	_ TRAVERSE (X) <u>X</u>
BASED ON T	HE FOLLOWING CONTROL:

♦ CORNER MONUMENT

WITNESS MONUMENT

BEARINGS ARE BASED ON: ______ ® |

		,	
FIELD BOOK PAGE #		/	7
OR OBSERVATION SHEET	SHEET		
SHOW A PLAN VIEW DRAWING DEPICTING THE CORNER MONUMENT AND SURROUNDING			
PHYSICAL FEATURES, INCLUDING THE EXCAVATION AREA AND DEPTH.			

UN617 W1/4CORSEC34

(B) Describe any record evidence, monument evidence, occupational evidence, testimonial evidence or any other material evidence you considered, and whether the monument was found or placed.

- 1833 HARRISON T4N R10E 4TH MER NORTH BETWEEN SECS 33 & 34
 - 2640.00 QUARTER SEC. COR {BURR 0 12 S61W 29.04'; BLK 0 8 N31E? 19.14' BURR 0 12 & BLK 0 8}MARKED
 - 5280.00 COR TO SEC 27,28,33,34
 {BURR D 12 S65E 168.96'; BURR D 12 S68W
 56.1'; BURR D 12 N55W 53.46'; BURR D 10 N25E
 143.88' LAND LEVEL 2ND RATE TIMBER ? BURR &
 RED D MOSTLY SCRUBS GRASS & WEEDS.
- 1855 CHURCH VOL 1 PG 45 STATES NOTHING ABOUT MON. USED
 TO SUBDIVIDE SEC 34. 2629.44 TO CENTER OF SEC 34,
 5258.88 TO E 1/4 COR SEC 34, 2657.16 TO NW COR SEC 34,
 & 2679.60 TO SW COR SEC 34
- 1870 RUGER AUG REMON-69 SOUTH ON WEST LINE OF NW 1/4 SEC 34 ON A VAR 7-06 OFFSET EAST 17.82' AT
 - 2663.92 INTERSECTED QUARTER LINE 13.2' EAST OF QUARTER CORNER. FOUND OLD STAKE AT CORNER ALSO FOUND STUMP OF NORTH BEARING TREE AND REMAINS OF STUMP OF SOUTH BEARING TREE. COR VAR 7-12

SOUTH ON WEST LINE OF SW 1/4 SEC 34 ON A VAR 7-10 OFFSET EAST 13.04' AT

- 2661.34 INTERSECTED SOUTH BOUNDARY LINE 17.00'
 EAST OF CORNER AS SET BY LOCKE TESTED IT
 AND FOUND IT CORRECTED. COR VAR 7-05'
- 1891 BLEEDORN VOL 2 PG 456 MON. USED TO SUBDIVIDE SEC 34. VAR 5-10 TO E 1/4 COR SEC 34.
- 1906 KERCH VOL 3 PG 36 FD MON. USED TO SUBDIVIDE SEC 33. SET GAS PIPE 1 /12X24" LONG 0 CENTER OF SEC 33
- 1963 COMBS #6985
- 1963 BATTERMAN VOL 4 PG 150 JANESVILLE SET. FD CUT STONE. WESTERLY 1324.38 TO 1/16TH CORNER. NORTHERLY 372.70 TO SET PIPE. REFERENCED SAME.
- 1963 BATTERMAN VOL 4 PG 149 BELOIT SET. SIMILAR TO JANESVILLE SET, EXCEPT DISTANCE OF 126.57 IS FROM NE REFERENCE PIPE TO THE MOST SW REFERENCE PIPE. DISTANCE 83.45 IS FROM MOST SE REFERENCE PIPE TO THE MOST SW REFERENCE PIPE. BELOIT RECORD CALLS FOR FINDING 2" PIPE OVER BROKEN CUT STONE.
- 1971 LEE CSM VOL 2 PG 200 LS N89-27-28W 1324.38 TO FD PIN @ 1/16TH COR. FROM 1/16TH COR NO-16-20W 666.00
- 1972 LEE CSM VOL 2 PG 229 L.S.
- 1973 LEE #5256 STATES NOTHING ABOUT MON. NORTH 482.70 TO PIPE.
- 1978 BARNES VOL 5 PG 398 SET ALUM MON. FD PK AS FD & VERIFIED 1 YEAR AGO.
- 1978 COMBS BK 30 PG 10 BERG ESTATES. CI ANGLE @ E 1/4 COR SEC 33 FROM E/W 1/4 LINE OF SEC 33 ALONG EAST LINE OF NE 1/4 SEC 33
- 1984 COMBS CSM VOL 12 PG 1 FD ALUM @ W 1/4 COR & E 1/4 COR SEC 33. FROM E 1/4 COR SEC 33 N89-27-20W 1324.03 TO 1/16TH COR.
- 1985 BARNES X-13 FD ALUM MON. 279,844.21; 2,185,675.99 ELEV 903 REFERENCED SAME. ADDED RISERS. WEST PVMT EDGE.
- 1985 BARNES VOL 6 PG 338 NO-25-58W 2668.37 TO NW COR SEC 34, N89-37-10E 2630.32 TO CEN SEC 34, N89-37-05E 5265.90 TO E 1/4 COR SEC 34

SHEET 1 OF 3

CORNER CODE X-13(1)

Drold Barres Oct 11 2011 UN617 W1/4CORSEC34

- 1985 BARNES VOL 6 PG 339 FD ALUM. S89-35-22W 1324.17 TO FD PK IN PIPE & NO-25-58W 2668.36 TO CUT LS @ SE COR SEC 28
- 1987 COMBS CSM VOL 13 PG 208 ALUM. N89-27-20W 1324.03 TO 1/16TH COR. FROM 1/16TH COR NO-16-30E 845
- 1988 COMBS CSM VOL 13 PG 462 ALUM. @ W 1/4 COR & E 1/4 COR SEC 33.
- 1988 COMBS CSM VOL13 PG 485 STATES NOTHING ABOUT MON.
- 1992 COMBS BK 32 PG 125 ABEY ACRES. ALUM N89-27-20W 2648.43 TO PK @ CENTER OF SEC 33.
- 1993 COMBS BK 32 PG 188 ABEY ACRES FIRST ADDITION" ALUM N89-27-20W 2648.43 TO PK @ CENTER OF SEC 33. N89-27-20W 1324.07 TO 1/16 COR. FROM 1/16 COR NO-16-30E 335.0
- 1994 COMBS CSM VOL 18 PG 43 STATES NOTHING. USED FOR LINE FROM LS @ NE COR SEC 33
- 2000 KARNS CSM VOL 24 PG 35 ROCK COUNTY SEC COR. @ W 1/4 & E 1/4 COR SEC 33. 5264.77 TO W 1/4 COR SEC 33
- 2003 DALSING CSM VOL 26 PG 81 ALUM. N89-27-20W 2648.55 TO FD PK @ CENTER OF SEC 33
- 2003 COMBS CSM VOL 27 PG 58 STATES NOTHING ABOUT MON. 2668.26 TO LS @ NW COR SEC 34
- 2004 DELSING BK 32 PG 634 SOUTH GATE ESTATES. ALUM. N89-27-27W 2648.55 TO FD PK @ CENTER OF SEC 33
- 2004 COMBS BK 32 PG 677 CRULL ESTATES" ALUM, MON 2668.26 TO ALUM @ NE COR SEC 34
- 2006 COMBS #15545 FD IRON PIN 2667.08 TO SET PK @ SW COR SEC 34.

FD ALUM. MON & REF. MONUMENTS. ALUM IS ON LINE WITH CENTER PVMT TO THE WEST & ON LINE WITH WEST PVMT EDGE TO THE SOUTH.

C) Was the corner restored through acceptance of (1) an obliterated evidence location, or, (2) a found perpetuated location?

ACCEPTED PERPETUATED OUT LIMESTONE AS PERPETUATED BY ALUM. MON.

D) Describe any material discrepancy between the location of the corner as restored or reestablished and the location of that corner as previously restored or reestablished by distance and direction. Show the discrepancy on the plan view drawing under (a), above. Show the distances between the corner as previously restored or reestablished and (1) the corner as restored or reestablished, and (2) to at least 4 of the witness monuments shown on the drawing in (a), above.

NONE. THERE ARE DISCREPANCIES IN THE MEASUREMENTS SHOWN IN VOL 4 PG 150 & 149.

(E) Was the corner reestablished through lost corner proportionate methods? If so, show the method, including the directions and distances to other public land survey corners used as evidence or used for proportioning the corner location. \square

I, **Donald Barnes**, hereby certify that the corner location as identified by the corner code index was determined by me under my direction and control and that this U.S. Public Land Survey Monument Record is correct and complete to the best of my knowledge and belief.

SHEET 2 OF 3

CORNER CODE X-13(1)

A.E. 7.08 REQUIREMENT

Oct (1201)

