Paper weight-110# (minimum)

Black nonfading ink required

U.S. PUBLIC LAND SURVEY MONUMENT RECORD


For Public Land Survey Corners In:

WI ADMINISTRATIVE CODE A-E 7.08 REQUIREMENT

V 10/23/2004 USMONREC.DWG

T. <u>4</u> N. R. <u>10</u> E. 4th P.M.

CORNER CODE INDEX

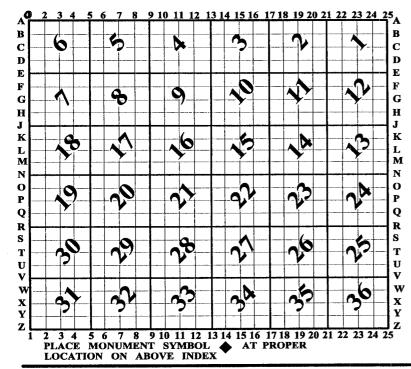

UNION TWP

IF AVAILABLE ROCK COUNTY COORDINATES PERFERRED

North	Elev	
East		
Hor. Datum	Vert. Datum	
LATITUDE	ELLIPS. HT.	
LONGITUDE		
NAD83(91)	NETWORK ADJ. YR 2010	
GPS (X)	TRAVERSE (X) X	
BASED ON THE	FOLLOWING CONTROL:	

◆ CORNER MONUMENT

WITNESS MONUMENT

ROCK COUNTY PROJECTION

BEARINGS ARE BASED ON:_

(a)

E'/A SECI TANR9E

FIELD BOOK _____ PAGE # ____ OF OR OBSERVATION SHEET ____ OF SHOW A PLAN VIEW DRAWING DEPICTING THE CORNER MONUMENT AND SURROUNDING PHYSICAL FEATURES, INCLUDING THE EXCAVATION AREA AND DEPTH.

PLANNING & ZONING COMMITTEE ADOPTED THIS FORM ON 12/2/1982

CORNER CODE

UN 6520 E 1/4 COR SEC 1 T4N R9E

(B) Describe any record evidence, monument evidence, occupational evidence, testimonial evidence or any other material evidence you considered, and whether the monument was found or placed.

1833 [SEP] MULLETT NORTH ON EAST SIDE SEC 1

1688.94 BUR OAK 18

2640 SET 1/4 SEC POST BUR DAK 15 S54W 20.46 BUR OAK 14 N33W 73.26'

SET POST FOR CORNER TO T4 & 5N BLACK OAK 6 5126.88 NB9E 68.64¹, BLACK DAK 12 S45E 235.62¹ LAND ROLLING, SECOND RATE TIMBER BUR AND BLACK OAK SEP 15TH 1833

BY GOOD OBS AT THIS POST VAR 6-35E

1833 BRINK SOUTH BOUNDARY OF T5N R10E WEST ON SOUTH SIDE SECTION 31

> 186.12 BURR OAK 14

2640.00 SET QUARTER SECTION POST BURR OAK 12 NB3E 144.54'; BURR DAK 16 N43 1/2W 49.5'

2962.08 W. DAK 16

5602.08 INTERSECTED RANGE LINE 957.00' NORTH OF CORNER SECTIONS 1 & 12 T4N R9E SET POST AT INTERSECTION FOR CORNER TO T4 & 5N R10E BURR OAK 12 N34E 5.28'; BURR OAK 16 S65E 81.84 LAND & C SAME.

1846 BENSON MAGNOLIA TOWN RD RECORDS BK 1 PG 1 NOTICE OF A SURVEY OF A ROAD LEADING FROM BELOIT ROCK COUTNY, WISCONSIN TERRITORY TO EXETER IN GREEN COUNTY, WISCONSIN. COMMENCING AT THE TOWN LINE 877.80' WEST OF THE 1/4 POST ON THE NORTH SIDE OF SEC 6 T2 RANGE 10 E RUNNING N18W 1188'; THENCE N21-30W 990'; THENCE N18W 1188'; THENCE N34 -15W 2574' THENCE NORTH 17-15 ? 726'; N21-30W 990' TO THE COUNTY LINE HIRAM BROWN, ELISA MC MONTH COMMISSIONERS APPOINTED BY THE ACT OF LEGISLATURE 1945 OF THE ACT TO AURHORIZE THE LOCATION OF CERTAIN TERRITORY ROADS. I DO HEREBY CERTIFY THAT THE ABOVE MINUTES OF THE SURVEY OF A ROAD FROM BELOIT TO EXETER, W.T. AS SURVEYED BY ME. HENRY A. BENSON, SURVEYOR

1851 MAGNOLIA TOWN RD RECORDS RD BK 1 PG 12 ALBON STOUGHTON AND OTHERS OF THE TOWN OF ALBANY TO DO SURVEY AND REROUTE THE ROUTE FOR A HIGHWAY N THE TOWN LINE BETWEEN THE TOWNS OF MAGNOLIA AND ALBANY IT WAS ORDERED THAT THE FOLLOWING SURVEY CONSTITUTE SAID HIGHWAY TO WIT; COMMENCING AT THE SOUTH EAST CORNER OF THE TOWN OF ALBANY AND RUNNING THENCE NORTH ON THE TOWN LINE TO THE 1/4 STAKE ON THE EAST SIDE OF SECTION 36 THENCE NORTH 60 1/2W 299.64; THENCE N47W 231.0' THENCE N11W 259.71 TO A RED OAK TREE THENCE N42 1/2E 698.28 TO THE SAID TOWN LINE THENCE NORTH ON THE TOWN LINE BETWEEN THE TWO TOWNS TO THE CORNER OF THE TOWN OF MAGNOLIA. THE SAID COURSE AND DISTANCE TO BE FOUR RODS WIDE. THE VARIATION OF THE MAGNETIC NEEDLE IS 7- 25 MINUTES

Emboss Pug 17, 2011

SHEET 1 OF 2

CORNER CODE A-1(4)

UN6520 E 1/4 COR SEC 1 T4N R9E

THENCE WEST ON THE LINE OF SAID SECTION 31 IN THE ALUMINUM MON. CORNER SET BY TALARCZYK #7002 1978 PROPORTIONATE MEASUREMENT & EXISTING PHYSICAL EVIDENCE. REFERENCED SAME.

DID NOT SEARCH FOR MONUMENT

C) Was the corner restored through acceptance of (1) and	obliterated evidence location,	or, (2) a found
perpetuated location?	•	

- D) Describe any material discrepancy between the location of the corner as restored or reestablished and the location of that corner as previously restored or reestablished by distance and direction. Show the discrepancy on the plan view drawing under (a), above. Show the distances between the corner as previously restored or reestablished and (1) the corner as restored or reestablished, and (2) to at least 4 of the witness monuments shown on the drawing in (a), above.
- (E) Was the corner reestablished through lost corner proportionate methods? If so, show the method, including the directions and distances to other public land survey corners used as evidence or used for proportioning the corner location.

I, Donald Barnes, hereby certify that the corner location as identified by the corner code index was determined by me under my direction and control and that this U.S. Public Land Survey Monument Record is correct and complete to the best of my knowledge and belief.

SHEET 2 OF 2

Emboss déacres Dug 17,2011

CORNER CODE A-1(4)

A.E. 7.08 REQUIREMENT