Paper weight-110# (minimum)


Black nonfading ink required LAND SUI **SURVEY** U.S. **PUBLIC** MONUMENT RECORD

For Public Land Survey Corners In:

WI ADMINISTRATIVE CODE A-E 7.08 REQUIREMENT

T. $\frac{4}{N}$ N. R. $\frac{10}{E}$ 4th P.M.

CORNER CODE INDEX

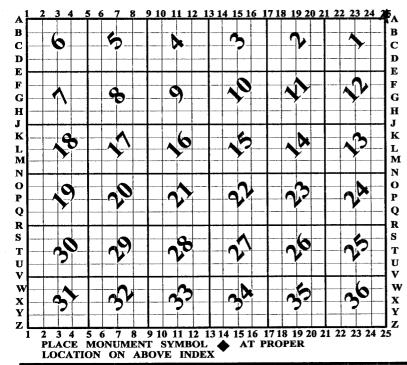

UNION TWP **ROCK COUNTY WI**

IF AVAILABLE ROCK COUNTY COORDINATES PERFERRED

Elev. North East Hor. Datum _____ Vert. Datum LATITUDE ELLIPS. HT. LONGITUDE NAD83(91) _____NETWORK ADJ. YR 2010 GPS (X) ____ TRAVERSE (X) X BASED ON THE FOLLOWING CONTROL:

◆ CORNER MONUMENT

O WITNESS MONUMENT

(a) ROCK COUNTY PROJECTION BEARINGS ARE BASED ON:_

		.,
FIELD BOOK PAGE #		14
OR OBSERVATION SHEET	SHEET	OF
SHOW A PLAN VIEW DRAWING DEPICTING THE CORNER MONUMENT AT		OING
PHYSICAL FEATURES, INCLUDING THE EXCAVATION AREA AND DEPTH.		
PLANNING & ZONING COMMITTEE ADOPTED THIS FORM ON 12/2/1982		2000
CODIVED	CODE	4-75(1)

UN513 NEORSECT

(B) Describe any record evidence, monument evidence, occupational evidence, testimonial evidence or any other material evidence you considered, and whether the monument was found or placed.

MULLETT & BRINK (SEP) TAN RIDE NORTH ON EAST SIDE 1833 OF SECTION 1

> 330 LEAVE PRAIRIE & ENTER MARSH

STREAM 3.96' COURSE NE 627.0

STREAM 5.28' COURSE NW 924.00

1204.50 STREAM 5.28' COURSE NW

LEAVE MARSH & ENTER WOODLAND 2013

2640.00 SET QUARTER SECTION POST BUR OAK 10 S2 1/2 W 66.66; BURR OAK 12 N51W 25.08'

ENTER MARSH 3267

3333.0 STREAM 1.32' C SE

4290 ENTER WOODLANDS

SET TEMPORARY 6-MILE POST. LAND ROLLING 5280 SECOND RATE. EXCEPT MARSH AND TIMBERED WITH BUR BLACK AND WHITE DAK.

T5N R10E VAR 8-15E NORTH ON 1833 MULLETT & BRINK EAST SIDE SECTIONS 36

> 1843.38 WHITE DAK B

SET QUARTER SECTION POST BURR DAK 16 2640.0 S48 1/2 W 143.22'; BURR OAK 16 N63W 92.40'

4620.0 BLACK DAK 18

SET POST CORNER SECTIONS 25 & 36 BURR 5280.00 DAK 14 S60W 116.82'; BURR DAK 7 N36W 42.90' LAND ROLLING SECOND RATE BLACK WHITE & BURR OAK RED ROOT ROSE WILLOW CROSSING

MULLETT & BRINK (SEP 22ND) T5N R11E WEST ON SOUTH 1833 SIDE SECTION 31

> 2640 SET QUARTER SECTION POST BUR OAK 8 N41E 58.08'; BLACK OAK 14 N14W 42.9'

5187.60 INTERSECTED RANGE LINE AT TEMPORARY POST SET POST CORNER TOWNSHIPS 4 & 5 RANGES 10 & 11 E WHITE DAK 14 S11E 56.76': WHITE DAK 18 N1 1/2W 80.52' LAND ROLLING SECOND RATE WHITE BLACK AND BUR DAK, SEPT 22 1833

MULLETT & BRINK T5N R10E VAR 8-10E WEST ON

1833 SOUTH SIDE SEC 36

RAPID STREAM PURE WATER 16.5' WIDE CRS 1320.00

SET QUARTER SEC POST BURR OAK 18 N84E 2640.00 52.8; BURR DAK 14 N48 1/2W 34.98

3493.38 W DAK 16

SET POST CORNER TO SECTIONS 35 & 36 5280.00 BURR OAK 12 N86 1/2E 224.40'; WHITE OAK 18 N12W 39.60'

LAND ROLLING SECOND RATE. BURR OAK, WHITE OAK, RED ROOT CRS

TOWN RD PR BK 1 PG 10 BEGINNING AT THE EAST END OF 1857 N. DAVENPORT MILL DAM; THENCE N52E 99.66' TO STAKE; THENCE N55E 399.96' TO THE TOWN LINE; THENCE NORTH ON THE LINE BETWEEN UNION AND PORTER 401.94 TO THE NE COR OF THE TOWN OF UNION AND THE WHOLE LENGTH OF RD IS 808.5' COURSES GIVEN ACCORDING TO THE TRUE MERIDIAN. VARIATION OF NEEDLE 8 DEGREES.

TOWN RD RECORDS BK 1 PG 10 & 11 BEGINNING AT THE 1857 SOUTH EAST COR OF SAID TOWN OF RUTLAND BEING THE SOUTH EAST COR OF SEC 36 T5N OF RANGE 10E AND THENCE NORTH

SHEET 1 OF 4 CORNER CODE A-25(1)

Pendet Dans 0 ct 27 2011

UNSI3 NE CORSEC!

ON THE LINE 132.0 TO THE NORTH WEST CORNER OF THE TOWN OF PORTER BEING THE NW COR OF SEC 6 T4N R11E THE LENGTH OF THE ABOVE DECRIBED RD IS 132.0 AND IS 66 WIDE THE LINE SURVEYED BEING THE CENTER OF THE SAME. VARIATION OF NEEDLE B COURSE GIVEN ACCORDING TO THE TRUE MERIDIAN.

- (SEP) TOWN RD RECORDS BK 2 PG 5 "" AND THAT THE 1867 AFORESAID SUPERVISORS IN CONNECTION WITH THE UNDERSIGNED SUPERVISORS OF THE TOWN OF DUNKIRK IN THE COUNTY OF DANE, HAVING BEEN SATISFIED THAT THE LAW HAS IN ALL RESPECTS BEEN COMPLIED WITH; IT IS HEREBY ORDERED AND DETERMINED, AND WE DO HEREBY ORDER AND DETERMINE THAT A HIGHWAY BE AND THE SAME IS HEREBY LAID OUT PURSUANT TO SAID APPLICATION: DESCRIBED AS FOLLOWS, TO WIT: BEGINNING AT THE NE COR OF SEC 5 IN SAID TOWN OF PORTER, ON THE TOWN LINE BETWEEN SAID TOWN AND THE TOWN OF DUNKIRK (DUNKIRK BEING IN THE COUNTY OF DANE) AND THENCE RUNNING WEST ON SAID LINE UNTIL IT INTERSECTS MR. SAVAGES ORCHARD (SAID ORCHARD BEING IN THE SW CORNER OF SEC 31 IN THE TOWN OF DUNKIRK DANE COUNTY, THENCE BEARING SOUTH 2 RODS: THENCE WEST TO THE COOKVILLE AND DUNKIRK RD RUNNING SOUTH ON THE CENTER LINE OF SEC 6 IN PORTER THE SAID HIGHWAY IS LAID OUT RUNNING THROUGH THE NORTH HALF OF THE NORTH EAST 1/4 OF SEC 5 AND THE N $\frac{1}{2}$ OF THE NE $\frac{1}{4}$ OF SEC 5 ALSO THE NORTH 1/2 OF THE NE 1/2 OF SEC 6 IN THE TOWN OF PORTER, THE WHOLE LENGTH OF THE ROAD BEING ONE AND ONE HALF (1 1/2) MILES MORE OR LESS. THE LINE OF SAID SURVEY TO BE THE CENTER OF SAID HIGHWAY; AND THE SAME IS ESTABLISHED FOUR RODS IN WIDTH.
- (SEP) TOWN RD RECORDS BK 2 PG 7 DESCRIBED AS 1867 FOLLOWS, TO WIT: BEGINNING AT THE NE COR OF SEC 5 IN SAID TOWN OF PORTER AND AT THE SE COR OF SEC 32 IN THE TOWN OF DUNKIRK, DANE COUNTY; THENCE RUNNING WEST ON SAID LINE UNTIL NEAR THE CORNER OF MR. SAVAGES ORCHARD. SAID ORCHARD BEING ON THE SE $rac{1}{4}$ OF SEC 31 IN SAID TOWN OF DUNKIRK; THENCE BEARING SOUTH 2 RODS; THENCE WEST UNTIL IT INTERSECTS THE COOKVILLE AND DUNKIRK ROAD RUNNING NORTH AND SOUTH ON THE CENTERLINE OF SEC 6 IN PORTER AND THE NORTH AND SOUTH CENTERLINE OF SEC 31 IN DUNKIRK, DANE COUNTY. THE SAID HIGHWAY IS LAID OUT ON THE NORTH LINE OF SEC 5 AND ON THE NORTH LINE OF SEC 6 UNTIL IT REACHES THE NORTH WEST CORNER OF THE NE 1/4 OF SAID SEC 6 [N 1/4 COR SEC 6] INTERSECTING THE RD RUNNING FROM COOKVILLE TO DUNKIRK BEARING SOUTH 2 RODS OPPOSITE J.W. SAVAGES ORCHARD AND THE WHOLE LENGTH OF SAID ROAD BEING ONE AND HALF MILES MORE OR LESS THE LINE OF SAID SURVEY TO BE THE CENTER LINE OF SAID HIGHWAY AND THE SAME IS ESTABLISHED 4 RODS IN WIDTH.

1870 RUGER (SEP) PG 107 REMONUMENTATION

EAST ON NORTH LINE OF THE NW 1/4 SEC 1, ON A VAR 6-40 OFFSET NORTH 3.3' INTERSECTED QUARTER LINE OF SECTION 36 T5NR10E 1.32' NORTH OF SOUTH QUARTER CORNER OF SAID SECTION. COR VAR 6-42 CONTINUED EAST ON NORTH LINE OF NE 1/4 SEC 1 (T4N R10E) ON SAME VARIATION AS ABOVE. OFFSET SOUTH 2.64' SHEET 2 OF 4

CORNER CODE A-25(1)

Call Baine, 0 ct 27, 2011 UNSIB NECORSECT

OFFSET SOUTH <u>1260.6</u> TO AVOID MILL POND. CONTINUED EAST ON SAME VARIATION AS ABOVE AT

5256.24 INTERSECTED EAST BOUNDARY LINE 1260.6 SOUTH OF NE CORNER OF FOUND REMAINS OF OLD STAKE AT CORNER. ALSO FOUND REMAINS OF STUMPS OF BOTH BEARING TREES.
ESTABLISHED NORTH QUARTER CORNER OF SECTION 1 ON TOWN LINE AND EQUI-DISTANT FROM NE AND NORTH WEST CORNER OF SAID SECTION. IT BEING 2628.12 DISTANT FROM EACH THE NORTH QUARTER POST OF SEC 1 IS 6.27 WEST OF THE SOUTH QUARTER POST OF SECTION 36 T5N R10E. COR. VAR. 6-43

1870 RUGER (SEP) PG 105 REMONUMENTATION NORTH ON EAST LINE OF SE 1/4 SEC 1 (T4N R10E) ON A VAR 6-30; OFFSET EAST 3.96' AT

2657.16 INTERSECTED QUARTER LINE 9.57' EAST OF QUARTER CORNER FOUND STUMP OF NORTH BEARING TREE AND REMAINS OF STUMP OF SOUTH BEARING TREE. ESTABLISHED QUARTER CORNER FROM THEM. COR. VAR 6-37

PG 108 NORTH ON EAST LINE NE 1/4 SEC 1 (T4N R10E) ON A VAR 6-45; OFFSET EAST 2.64' OFFSET WEST 2.64'; OFFSET WEST 7.26' AT

2636.04 INTERSECTED NORTH BOUNDARY LINE 0.66'
WEST OF CORNER. COR VAR 6-54
[RUGER PLACED CUT LIMESTONES]

- TOWN ROAD REC BK 3 PG 6 & 7 BEGINNING NEAR THE 1880 LYNN CREEK BRIDGE ON THE LINE BETWEEN SEC 6 OF THE TOWN OF PORTER AND SEC 1 OF THE TOWN OF UNION RUNNING NORTH ON SAID LINE ABOUT 120 RODS [1980']; THENCE IN A NORTHWESTERLY DIRECTION TO INTERSECT THE HIGHWAY ON THE WEST SIDE OF WHAT IS KNOWN AS DAVENPORT MILLS. THE SAME BEING AN ACCURATE SURVEY THEREOF, CAUSED BY US TO BE MADE AND SAID HIGHWAY BEING UPON THE TOWN LINE BETWEEN SAID TOWNS OR SO AS NEAR THERE TO AS THE SITUATION OF THE GROUND WILL ADJUST, THE LINE OF SAID SURVEY IS THE CENTER OF SAID HIGHWAY AND THE SAME IS LAID OUT OF THE WIDTH OF FOUR RODS; AND WE DO FURTHER ORDER AND DETERMINE THAT THE FOLLOWING DESCRIBED PART OF SAID HIGHWAY TO WIT; THE BRIDGE, LYNN CREEK, TO BE BUILT AND MAINTAINED BY """
- 1893 BLEEDORN VOL 2 PG 473 JUST STATES MON. 2612.28 TO N 1/4 COR SEC 6
- 1933 SUNNY #3567 FD 6X6 CUT STONE. 2609.6X TO 1 1/4 PIPE SET BY SUNNY @ N 1/4 COR SEC 6.
- 1933 SUNNY VOL 3 PG 227 FD 6X6 CUT STONE 8" CHERRY S41
 1/2E 38.8'; 12" LOCUST N16E 55.7', 2609.6X TO 1 1/2" PIPE
 @ N 1/4 COR SEC 6
- 1947 SUNNY #5047 UNION TWP FD STONE. 2640 TO E 1/4 COR SEC 6 UNION TWP
- 19?? UNK #12614 NOTE: HORIZONTAL DATUM IS BASED ON THE WI STATE PLANE COORDINATE SYSTEM, SOUTH ZONE. ALL DISTANCES ARE GIRD DISTANCES. ALL BEARINGS ARE REFERENCED TO GRID JNORTH. ALL U.S. PUBLIS LAND CORNERS ARE MARKED WITH AN ALUMINUM MONUMENT OR REFRENCED WITH A PERMANENT OBJECT. PK NAIL 309,207.09; 2,201,098.27 FOR SE COR SEC 36 TOWN OF RUTLAND. NO-36-24W 2617.37 TO 1" PIPE @ E 1/4 COR SEC 36. NO-37-20W 2625.27 FROM E 1/4 COR SEC 36 TO NE COR SEC 36. NO MONUMENT SET @ NE COR SEC 36 SHEET 3 OF 4

CORNER CODE A-25(1)

Dorold Raises Oct 27, 2011 WNS13 NE CORSECT

- 1975 SCHROEDER VOL 5 PG 76 DUG & FD 6X6 CUT L.S. MON 28"
 DEEP @ NE COR SEC 1 T4N R10E REFERENCED SAME. @
 INT. CENTER OF PVMT OF RDS. SHORT TIES CONC. NAIL
 20.00 NORTH & 9.00 WEST.
- 1980 SCHROEDER CSM VOL 9 PG 194 STATES NOTHING ABOUT MON. N88-04-30W 1643.53 TO POB OF CSM.
- 1988 BARNES VOL 6 PG 387 S89-57-07E 2541.46 TO S 1/4 COR SEC 31, S89-57-019E 2611.31 TO N 1/4 COR SEC 6, S00-52-07E 2508.39 TO W 1/4 COR SEC 6, S00-52-07W 2641.87 TO E 1/4 COR SEC 1 UNION TWP
- 1988 BARNES A-1 FD PK & 30" DEEP FD CUT LIMESTONE.
 PLACED POLY MON. ON TOP OF LIMESTONE. CORNER IS AT
 THE INTERSECTION OF THE CENTER OF THE PAVEMENT TO
 THE NORTH, SOUTH, AND EAST. REFERENCED SAME. FD
 NAIL 9.00 TO THE WEST & FD NAIL 20.00 TO THE NORTH.
- 1990 SCHROEDER CSM VOL 14 PG 253 STATES NOTHING ABOUT MON. N88-04-30W 1643.53 TO POB OF CSM.
- 1997 GREENLIE CSM VOL 20 PG 309 STATES NOTHING ABOUT MON. N88-04-30W 1643.53 TO POB OF CSM.
- 2005 COMBS #15203 FD PK. USED FOR LINE @ W 1/4 COR SEC 6.

I USED MY 1988 FIELD OBSERVATIONS

C) Was the corner restored through acceptance of (1) an obliterated evidence location, or, (2) a found perpetuated location?

ACCEPTED FD CUT LIMESTONE AS THE NW COR SEC 6 T4N R11E, THE NE COR SEC 1 T4N R10E, AND THE SE COR OF SEC T5N R10E SE COR OF RUTLAND TWP.

D) Describe any material discrepancy between the location of the corner as restored or reestablished and the location of that corner as previously restored or reestablished by distance and direction. Show the discrepancy on the plan view drawing under (a), above. Show the distances between the corner as previously restored or reestablished and (1) the corner as restored or reestablished, and (2) to at least 4 of the witness monuments shown on the drawing in (a), above.

THE 1857 RD RECORDS [BK 1 PG 10] CALLS FOR THE SURVEY OF THE ROAD. IT CALLS FOR THE SE COR SEC 36 T5N R10E AS 132.0' SOUTH OF THE NW COR OF SEC 6 PORTER TWP.

THIS IS IN CONFLICT WITH THE 1833 FIELD NOTES BY MULLETT & BRINK (SEP 22ND) T5N R11E WEST ON SOUTH SIDE SECTION 31

5187.60 INTERSECTED RANGE LINE AT TEMPORARY
POST SET POST CORNER TOWNSHIPS 4 & 5
RANGES 10 & 11 E WHITE OAK 14 S11E
56.76'; WHITE OAK 18 N1 1/2W 80.52'
LAND ROLLING SECOND RATE WHITE BLACK
AND BUR OAK. SEPT 22 1833

THERE ARE N/S CLOSING CORNERS BETWEEN T4N R10E & T4N R11E WHICH ARE DOCUMENTED ON THE ORIGINAL GOVERNMENT PLAT. THE ORIGINAL FIELD NOTES AND PLATS DO NOT SHOW A JOG OF 132' AS CALLED FOR IN THE ROAD RECORD. THE 132' CALL FOR THIS JOG MAY BE BECAUSE OF THE N/S 132 JOG IN RD R/W THAT WAS CALLED FOR IN THE 1867 TOWN RD RECORDS BK 2 PG 7. RD RECORDS BK 2 PG 7 CALLS FOR THE JOG TO OCCUR AT THE N $\frac{1}{4}$ COR SEC 6. IT APPEARS THIS WAS TO GET AROUND MR. SAVAGES ORCHARD.

- (E) Was the corner reestablished through lost corner proportionate methods? If so, show the method, including the directions and distances to other public land survey corners used as evidence or used for proportioning the corner location. $N \square$
- I, **Donald Barnes**, hereby certify that the corner location as identified by the corner code index was determined by me under my direction and control and that this U.S. Public Land Survey Monument Record is correct and complete to the best of my knowledge and belief.

SHEET 4 OF 4

CORNER CODE A-25(1)

Distiblibaciós
COR
OCTZ7,201/ A.E. 7.08 REQUIREMENT