

U.S. PUBLIC LAND SURVEY MONUMENT RECORD

For Public Land Survey Corners in the


T. 2 N., R. 12 E

CORNER CODE INDEX

	1	2	3	4	5	6	7	8	9	10	11	12	13	14	15	16	17	18	19	20	21	22	23	24	25
A																									
B																									
C																									
D																									
E																									
F																									
G																									
H																									
I																									
J																									
K																									
L																									
M																									
N																									
O																									
P																									
Q																									
R																									
S																									
T																									
U																									
V																									
W																									
X																									
Y																									
Z																									

PLACE MONUMENT SYMBOL (◆) AT PROPER LOCATION ON ABOVE INDEX

EXAMPLE

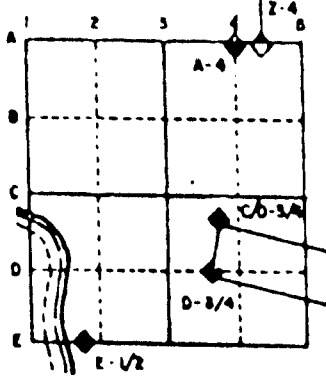

ROCK TWP
ROCK COUNTY WI

IF AVAILABLE
STATE PLANE COORDINATES

North (Y) _____ Eleve. (Z) _____
 East (X) _____ Zone _____
 Hor. Datum _____ Vert. Datum _____

◆ CORNER MONUMENT

○ WITNESS MONUMENT

BEARINGS ARE BASED ON:

(B) Describe any record evidence, monument evidence, occupational evidence, testimonial evidence or any other material evidence you considered, and whether the monument was found or placed.

1835 ORIG MULLET PLACED WOOD POST

1870 RUGER PLACED CUT LIMESTONE.

1892 BLEEDHORN FOUND STONE & TIED INTO IT WITH CARRINGTON'S CROWN ADD.

1917 KERCH NOTES STONE IN SHIELD'S SUB.

1986 BARNES BY USING BLEEDHORN'S SUBDIVISION MAP DISTANCES THE CORNER IS COMPUTED TO BE 11.67' SOUTH OF THE SW CORNER OF LOT 16. THIS IS IN HARMONY WITH THE SCALED LOCATION ON THE PLAT. ESTABLISHED THE CORNER AT THE RECORD DISTANCE FROM THE WEST LINE OF LOT 16 AND THE NW CORNER OF LOT 17. THESE NORTH SOUTH DISTANCES DO NOT AGREE WITH KERCH'S SHIELD'S SUB DISTANCES. THE CORNER AS PLACED IS IN HARMONY WITH RUGER'S 1870 DISTANCES TO THE SW CORNER OF SECTION 6 AND THE COMPUTED INTERSECTION OF THE QUARTER LINES AND EAST QUARTER CORNER OF SECTION 6. DID NOT EXCAVATE FOR THE CORNER BECAUSE OF UNDERGROUND IMPROVEMENTS. PLACED POLY. MONUMENT.

MONUMENT WILL BE DESTROYED BY ROAD CONSTRUCTION.

C) Was the corner restored through acceptance of (1) an obliterated evidence location, or, (2) a found perpetuated location?
ACCEPTED FOUND MONUMENT.

D) Describe any material discrepancy between the location of the corner as restored or reestablished and the location of that corner as previously restored or reestablished by distance and direction. Show the discrepancy on the plan view drawing under (a), above. Show the distances between the corner as previously restored or reestablished and (1) the corner as restored or reestablished, and (2) to at least 4 of the witness monuments shown on the drawing in (a), above.

(E) Was the corner reestablished through lost corner proportionate methods? If so, show the method, including the directions and distances to other public land survey corners used as evidence or used for proportioning the corner location.

NO

I, Donald Barnes, hereby certify that the corner points as identified by the corner code index were, in a field survey on, August 9, 1994, established, re-established, monumented, re-monumented, recovered or restored as expressed below and in conformance with the regulations and rules as required in the current manual of survey instructions of the United States Department of Interior, Bureau of Land Management.

seal

Donald Barnes
Aug 9, 1994

AFFIX YOUR LAND SURVEYOR SEAL

COUNTY SURVEYOR FILING DATA

Date of computer entry _____

Date microfilmed _____

Number of included sheets 1

CORNER CODE

C25(1)

