Paper weight-110# (minimum)

Black nonfading ink required

# U.S. PUBLIC LAND SURVEY MONUMENT RECORD


For Public Land Survey Corners In:

WI ADMINISTRATIVE CODE A-E 7.08 REQUIREMENT

REV 10/23/2004 USMONREC,DWG

T. 4 N. R. 10 E. 4th P.M.

CORNER CODE INDEX

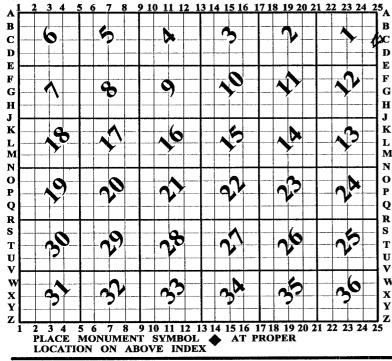

# UNION TWP

IF AVAILABLE ROCK COUNTY COORDINATES PERFERRED

| North        | Elev.                |
|--------------|----------------------|
| East         | ·                    |
| Hor. Datum   | Vert. Datum          |
| LATITUDE     | ELLIPS. HT.          |
| LONGITUDE _  |                      |
| NAD83(91)    | NETWORK ADJ. YR 2010 |
| GPS (X)      | TRAVERSE (X) X       |
| BASED ON THE | FOLLOWING CONTROL:   |

**◆ CORNER MONUMENT** 

WITNESS MONUMENT

| FIELD BOOK PAGE #   |          | ,     |      | ->                   |
|---|----------|-------|------|----------------------|
| OR OBSERVATION SHEET  | SHEET .  |       | OF _ | <u>_</u>             |
| SHOW A PLAN VIEW DRAWING DEPICTING THE CORNER MONUMENT AND  | SURROUND | ING   | •    |                      |
| PHYSICAL FEATURES, INCLUDING THE EXCAVATION AREA AND DEPTH. |          |       |      | $-\langle i \rangle$ |
| PLANNING & ZONING COMMITTEE ADOPTED THIS FORM ON 12/2/1982  |          |       |      | 2                    |
| CORNER  | CODE     | ( - ; | 25   |                      |

#### E1/4CORSEC1

(B) Describe any record evidence, monument evidence, occupational evidence, testimonial evidence or any other material evidence you considered, and whether the monument was found or placed.

1833 MULLETT & BRINK (SEP) TAN RIDE NORTH ON EAST SIDE OF SECTION 1

330 LEAVE PRAIRIE & ENTER MARSH

627.0 STREAM 3.96' COURSE NE

924.00 STREAM 5.28' COURSE NW

1204.50 STREAM 5.28' COURSE NW

2013 LEAVE MARSH & ENTER WOODLAND

2640.00 SET QUARTER SECTION POST BUR OAK 10 S2 1/2 W 66.66; BURR OAK 12 N51W 25.08'

3267 ENTER MARSH

3333.0 STREAM 1.32'C SE

4290 ENTER WOODLANDS

5280 SET TEMPORARY 6 MILE POST. LAND ROLLING SECOND RATE. EXCEPT MARSH AND TIMBERED WITH BUR BLACK AND WHITE DAK.

1833 ORIG GOV PLAT NW COR SEC 7 PORTER TWP IS143.88'
NORTH OF NE COR SEC 12 UNION TWP

1870 RUGER (SEP) PG 105 REMONUMENTATION NORTH ON EAST LINE OF SE 1/4 SEC 1 (T4N R10E) ON A VAR 6-30; OFFSET EAST 3.96' AT

2657.16 INTERSECTED QUARTER LINE 9.57 EAST OF QUARTER CORNER FOUND STUMP OF NORTH BEARING TREE AND REMAINS OF STUMP OF SOUTH BEARING TREE. ESTABLISHED QUARTER CORNER FROM THEM. COR. VAR 6-37

PG 108 NORTH ON EAST LINE NE 1/4 SEC 1
(T4N R10E) ON A VAR 6-45; OFFSET EAST
2.64' OFFSET WEST 2.64'; OFFSET WEST
7.26' AT

2636.04 INTERSECTED NORTH BOUNDARY LINE 0.66'
WEST OF CORNER. COR VAR 6-54
[RUGER PLACED CUT LIMESTONES]

- 1893 BLEEDORN VOL 2 PG 473 PLACED LIMESTONE 12 X 10 X 4 133.48 NORTH OF THE EAST QUARTER CORNER OF SECTION 1 OF UNION TOWNSHIP. HE SHOWS THAT HE FOUND A MONUMENT AT THE EAST QUARTER CORNER.
- 1933 SUNNY VOL 3 PG 227 LIMESTONE 12 X 10 X 4 NORTH
  133.5 OF THE 6" X 6" CUT LIMESTONE AT THE EAST QUARTER
  OF SECTION 1 UNION TOWNSHIP. SHOWS A DISTANCE OF
  2561.5 TO THE CENTER OF SECTION 6. USED TO SET CENTER
  OF SEC 6
- 1947 SUNNY #5047 UNION TWP POST AT COR. 2640 TO STONE @ NE COR SEC 1 UNION TWP. & 2616.6 TO SET PIPE @ CENTER OF SEC 1
- 1958 BATTERMAN #3566 LS 12X10X4 GONE. FD PIPE SET BY SUNNY @ CENTER OF SEC 6, FD CUT STONE @ E 1/4 COR SEC 1 UNION TWP. CALL FOR THE W 1/4 COR SEC 6 BEING 133.50 NORTH OF THE CUT STONE.
- 1988 BARNES C-25 & C-1 W 1/4 COR SEC 6 FD LS OF RECORD 1.2'

  DEEP. PLACED MAGNET ON SOUTH SIDE, FD CUT LIMESTONE

  @ E 1/2 COR SEC 1 UNION TWP. CUT STONE IS 2' SOUTH OF

  E/W FENCE & ABOUT 65' WEST OF N/S FENCE, W 1/4 COR SEC

  6 IG 133.48 NO-52-07E OF CUT LIMESTONE. REFERENCED

  SAME.

THIS POSITION IS NOW IN A PLOWED FARM FIELD. I FOUND THE LIMESTONE OF RECORD 1.2 DEEP AND PLACED A MAGNET ON THE SOUTH SIDE. I RESTORED THE CORNER THROUGH ACCEPTANCE OF FOUND EVIDENCE. IT APPEARS THAT BLEEDORN USED RUGER'S MEASUREMENTS TO PRORATE AGAINST THE ORIGINAL GOVERNMENT DISTANCES AND TO COMPUTE THE JOG DISTANCE. USING THIS METHOD PRODUCES A JOG OF 134.20 AND HE SHOWS A DISTANCE OF 133.48 WHICH IS WITHIN THE LEGAL TOLERANCE OF THE DAY.

SHEET 1 OF 3

CORNER CODE C-# (2)

25

Paires Nov 1,2011 UN 520 EYA COR SPC)

IF I PRORATE MY DISTANCES AGAINST THE ORIGINAL GOVERNMENT DISTANCES THEN THE JOG WOULD BE 137.22. SINCE BLEEDORN'S METHOD IS WITHIN THE LEGAL TOLERANCE OF THE 1800s I AM USING HIS CORNER.

- 1988 BARNES VOL 6 PG 387 & E-23 STATES NOTHING ABOUT MON. S89-02-25E 2554.32 TO PIPE NEAR CEN OF SEC 6, S89-04-52E 5203.51 TO E 1/4 COR SEC 6, S00-52-07W 133.48 TO E 1/4 COR SEC 1 UNION TWP, NO-52-07E 2508.39 TO NW COR SEC 6, & S00-52-33W 2645.28 TO SW COR SEC 6.
- 2003 COMBS CSM VOL 26 PG 385 FD CUT LIMESTONE @ E 1/4 COR SEC 1 UNION TWP. 2655.63 TO ALUM. @ SE COR SEC 1 UNION TWP
- 2005 COMBS #15203 CALLS FOR CUT LIMESTONE. N85-59-08E 5203.85 TO ALUM @ E 1/4 COR SEC 6, N4-03-53W TO PK @ NW COR SEC 6. {THERE IS A JOG AT THE W 1/4 COR. AND SINCE HE CALLS FOR A CUT LIMESTONE HE MAY HAVE THE E 1/4 COR OF SEC 1 UNION TWP.
- 2007 RIESOP C-1(1) 3/4" DIA REBARS FD AS SET BY COMBS MARCH 2005. IRONS MARK PROPERTY LINE ALONG TOP OF WOODED EMBANKMENT AND EDGE OF FIELD.

  RECORD LIMESTONE AT CORNER DOCUMENTED BY DONALD BARNES MONUMENT RECORD OF 1988. SURVEY BY RONALD COMBS IN MARCH 2005 HE FD THE STAONE. THE CORNER AREA IS IN A CHISEL POLOWED FIELD AND SUBJECT TO BEING DISTURBED. I FD 4 OF COMBS IRONS AND IN CONJUNCTION WITH THE MONUMENTED E 1/4 COR, USED A POSITION IN AGREEMENT WITH HIS SURVEY. REFERENCED SAME. S89-57-48E 5203.77 TO ALUM @ E 1/4 COR SEC 6
- 2007 RIESOP #M15533 & S14708 STONE MON O REC. COR IN PLOWED FIELD. COMPUTED POSITION SHOWN BY COMBS IM MAR 2005 SURVEY. S89-57-48E 2563.06 TO INT OF 1/4 LINES. 5203.76 FROM W 1/4 TO E 1/4 COR SEC 6. CALLS FOR FD PIPE AS 8.69' EAST OF INT. 1/4 LINES & 2.07 SOUTH OF E/W 1/4 LINE.

# FD LIMESTONE OF REC @ W 1/4 COR & CUT LS @ E 1/4 COR SEC 1

C) Was the corner restored through acceptance of (1) an obliterated \evidence location, or, (2) a found perpetuated location?

### ACCEPTED MONUMENTS OF RECORD.

D) Describe any material discrepancy between the location of the corner as restored or reestablished and the location of that corner as previously restored or reestablished by distance and direction. Show the discrepancy on the plan view drawing under (a), above. Show the distances between the corner as previously restored or reestablished and (1) the corner as restored or reestablished, and (2) to at least 4 of the witness monuments shown on the drawing in (a), above.

## NONE

- (E) Was the corner reestablished through lost corner proportionate methods? If so, show the method, including the directions and distances to other public land survey corners used as evidence or used for proportioning the corner location.
- I, **Donald Barnes**, hereby certify that the corner location as identified by the corner code index was determined by me under my direction and control and that this U.S. Public Land Survey Monument Record is correct and complete to the best of my knowledge and belief.

SHEET 2 OF 3

CORNER CODE C-4(2)

A.E. 7.08 REQUIREMENT

Haures Nov1,2011

