Paper weight-110# (minimum)

Black nonfading ink required

## U.S. PUBLIC LAND SURVEY MONUMENT RECORD


For Public Land Survey Corners In:

WI ADMINISTRATIVE CODE A-E 7.08 REQUIREMENT

REV 10/23/2004 USMONREC.DWG

T.  $\underline{4}$  N. R.  $\underline{10}$  E. 4th P.M.

CORNER CODE INDEX

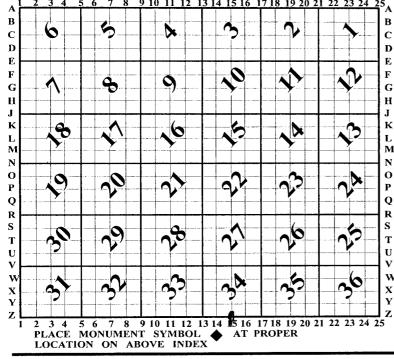

## UNION TWP

IF AVAILABLE ROCK COUNTY COORDINATES PERFERRED

North	Elev
East	
Hor. Datum	Vert. Datum
LATITUDE	ELLIPS. HT
LONGITUDE _	
NAD83(91)	NETWORK ADJ. YR 2010
GPS (X)	TRAVERSE (X) X
BASED ON THE	FOLLOWING CONTROL:

**♦ CORNER MONUMENT** 

WITNESS MONUMENT

FIELD BOOK \_\_\_\_\_ PAGE # \_\_\_\_\_ OF OR OBSERVATION SHEET \_\_\_\_ OF SHOW A PLAN VIEW DRAWING DEPICTING THE CORNER MONUMENT AND SURROUNDING PHYSICAL FEATURES, INCLUDING THE EXCAVATION AREA AND DEPTH.

PLANNING & ZONING COMMITTEE ADOPTED THIS FORM ON 12/2/1982

CORNER CODE 275

## UN628 S1/4CORSEC34

(B) Describe any record evidence, monument evidence, occupational evidence, testimonial evidence or any other material evidence you considered, and whether the monument was found or placed.

1833 BRINK & MULLETT (SEP 12) T4N R10E

WEST ON SOUTH SIDE OF SECTION 34 (PG107)

1840.08 STREAM 11.88 CROSSES SOUTH

2640.00 SET QUARTER SECTION POST IN MARSH AND MADE A MOUND

3630.00 LEAVE MARSH

5280.00 SET POST FOR CORNER TO SECTIONS 33 & 34
BLACK OAK 12 N13E 26.4; BURR OAK 7 N58
1/2W 23.76' WEST OF MARSH LAND ROLLING
BURR OAK B. OAK HAZLE RED ROOT ROSE
WILLOW MARSH RICH BOTTOM WILLOW GRASS
CROSSES ALL SECOND RATE.

- 1855 CHURCH VOL 1 PG 45 GOV. STAKE IN MOUND. USED TO SUBDIVIDE SEC 34. 2622.18 TO SW COR SEC 34, 2657.16 TO CENTER OF SEC 34, & 5314.32 TO N 1/4 COR SEC 34
- 1863 LOCKE VOL 1 PG 194 STATES NOTHING ABOUT MON. USED TO SUBDIVIDE SEC 3. 2197.14 TO SET STAKE @ EDGE OF SOD FENCE & DITCH @ CENTER OF SEC 3 & 4838.46 TO SET BR. O STAKE IN INTERSECTION OF DITCHES @ S 1/4 COR SEC 3
- 1870 RUGER AUG REMON-70 EAST ON SOUTH LINE OF SW 1/4
  SEC 34 ON A VAR 6-55 OFFSET NORTH 5.45'

2622.84 INTERSECTED QUARTER LINE 11.22 NORTH OF QUARTER CORNER. FOUND REMAINS OF OLD STAKE AT CORNER. COR VAR 6-48

EAST ON SOUTH LINE SE 1/4 SEC 34 ON A VAR 6-55 OFFSET NORTH 11.22'AT

2634.06 INTERSECTED EAST BOUNDARY LINE AT CORNER.
COR VAR 7-09'

- 1891 BLEEDORN VOL 2 PG 456 MON. USED TO SUBDIVIDE SEC 34. VAR 5-05 TO N 1/4 COR SEC 34
- 1930 BATTERMAN VOL 3 PG 167 GRADED OUT. N 1/4 COR SEC 3 GRADED OUT. SHOWS S 1/4 COR EAST OF N 1/4 COR SEC 3.
- 1966 SCHIMEALL VOL 3 PG 167 SET PIN ON TOP LS. 5'.
- 1966 BATTERMAN VOL 4 PG 296 C. SHIMEALL DUG 7 FD CUT STONE MON. BROKEN UP. SHOWS IT EAST OF CENTER LINE OF STH 213
- 1968 BATTERMAN VOL 4 PG 444 5/8 PIN SET OVER CUT STONE. 24 EAST OF CENTER OF STH 213 & ON LINE WITH E/W FENCE ON WEST SIDE OF RD & 82' SOUTH OF E/W FENCE ON EAST SIDE OF RD
- 1977 WOODMAN CSM VOL 7 PG 49 FD SQUARE 5/8 ROD. N89-33-06W 2704.34 TO ALUM @ NW COR SEC 3.
- 1985 BARNES VOL 6 PG 338 NO-24-41W 2675.76 TO CENTER OF SEC 34 & 5339.52 TO N 1/4 COR SEC 34
- 1985 BARNES Z-15 FD 5/8 PIN AS DESCRIBED IN VOL 4 PG 444.
  REFERENCED SAME. PIN IS 13 EAST OF EAST PVMT EDGE.
- 1989 KARNS #12270 FD MON NO-24-16W 2663.65 TO 3/4X24 SET REBAR @ CENTER OF SEC 34. NO-24-16W 668.98 TO POB A REBAR.
- 1989 KARNS VOL 6 PG 400 INFORMATION SUPPLIED BY KARNS-ASSUMED NORTH. FD ALUM. MON. N89-21-21E 2639.17 TO ALUM MON @ SE COR SEC 34 & NO-24-16E 2675.92 TO CENTER OF SEC 34
- 1991 WOODMAN CSM VOL 15 PG 305 LOCATION FROM COUNTY TIES. NO-34-46W TO ALUM @ N 1/4 COR SEC 34.
- 1992 COMBS CSM VOL 16 PG 72 STATES NOTHING ABOUT MON. N89-40-45W 2625.58 TO ALUM @ SW COR SEC 34
- 1992 COMBS CSM VOL 16 PG 217 STATES NOTHING ABOUT MON. N89-40-45W 2625.58 TO ALUM 0 SW COR SEC 34.

SHEET 1 OF 3

CORNER CODE Z-15(2)

De 21, 2011

SEAL

UN628 S1/4CORSEC34

- 1992 COMBS #9383 IRON BAR N89-38-06W TO ALUM @ NW COR SEC 3.
- 1995 COMBS #9066 ALUM. MON.
- 1995 COMBS #9389 SET PIN. N89-37-45W 2704.39 TO ALUM @ NW COR SEC 3
- 1995 BARNES Z-15(1) & A-15 @ S 1/4 COR SEC 34 FD 1 5/8 IRON PIN & REFERENCE TIES. REFERENCED N 1/4 COR SEC 3. 2639.88 TO SE COR SEC 34, 2625.56 TO SW COR SEC 34. N 1/4 SEC 3 TO CI @ NE COR SEC 3 IS N89-02-12E 2642.17. N 1/4 COR SEC 3 TO FD ALUM @ NW COR SEC 3 IS S89-28-08W 2642.17. N 1/4 COR SEC 3 TO S 1/4 COR SEC 34 IS N89-27-56E 62.33. N 1/4 COR SEC 3 PLACED ON LINE WITH THE S 1/4 COR SEC 34 & THE SW COR SEC 34 AT MID POINT BETWEEN THE NW & NE CORNERS OF SEC 3. THERE WAS NO RECORD OF THE N 1/4 COR SEC 3 EVER BEING ESTABLISHED.
- 2000 LATHROP #7581 FD ALUM. MON. NO-24-15W 2675.94 TO ALUM. MON. @ CENTER OF SEC 34 & N89-23-50E 2639.78 TO ALUM MON @ SE COR SEC 34
- 2008 BIRRENKOTT #15991 @ CENTER OF SEC 34 FD 2" IRON PIPE 2675.74 TO FD 5/8 IRON REBAR @ S 1/4 COR SEC 34

FD PIN ON SLOPE OF ROAD. THERE IS ABOUT A 4' DIFFERENCE IN ELEVATION BETWEEN THE RD SURFACE & THE PIN. THE NATURAL GROUND IS ABOUT 2' LOWER THAN THE PIN. IT APPEARS FROM RECORD TIES THAT THE PIN AND SLOPE ARE SLIGHTLY DRIFTING TO THE EAST.

C) Was the corner restored through acceptance of (1) an obliterated evidence location, or, (2) a found perpetuated location?

ACCEPTED FD REFERENCE MONUMENTS & USED RECORD MEASUREMENTS TO COMPUTE THE POSTION OF THE CORNER. THIS POSITION IS N68-46-14W 0.10 OF THE PIN.

D) Describe any material discrepancy between the location of the corner as restored or reestablished and the location of that corner as previously restored or reestablished by distance and direction. Show the discrepancy on the plan view drawing under (a), above. Show the distances between the corner as previously restored or reestablished and (1) the corner as restored or reestablished, and (2) to at least 4 of the witness monuments shown on the drawing in (a), above.

THE POSTION OF THE CORNER IS N68-46-14W 0.10 OF THE PIN.
THE PIN AND SLOPE OF THE ROAD APPEARS TO BE SHIFTING TO THE EAST.

- (E) Was the corner reestablished through lost corner proportionate methods? If so, show the method, including the directions and distances to other public land survey corners used as evidence or used for proportioning the corner location.
- I, **Donald Barnes**, hereby certify that the corner location as identified by the corner code index was determined by me under my direction and control and that this U.S. Public Land Survey Monument Record is correct and complete to the best of my knowledge and belief.

Sep 21, 2011

SHEET 2 OF 3

CORNER CODE Z-15(2)

A.E. 7.08 REQUIREMENT

