U.S.

FIELD BOOK_

_PAGE #

PHYSICAL FEATURES, INCLUDING THE EXCAVATION AREA AND DEPTH.

PLANNING & ZONING COMMITTEE ADOPTED THE ABOVE FORM ON 12/2/1982

SHOW A PLAN VIEW DRAWING DEPICTING THE CORNER MONUMENT AND SURROUNDING

LAND PUBLIC SURVEY MONUMENT RECORD

For Public Land Survey Corners in: WI ADMINISTRATIVE CODE A-E 7.08 REQUIREMENT T. 4 N., R. 10 E CORNER CODE INDEX **TWP** COUNTY WI C IF AVAILABLE D ROCK COUNTY COORDINATES PERFERRED E North Elev. **East** O L Hor. Datum _____ Vert. Datum **LATITUDE** _ELLIPS. HT. **LONGITUTE** GPS (X) TRAVERSE (X) ____ BASED ON THE FOLLOWING CONTROL: MONUMENT SYMBOL AT PROPER LOCATION ON ABOVE INDEX WITNESS MONUMENT **♦ CORNER MONUMENT** (a) Assumed Datum N16 °30 'E N66 *29 ' 50 "E 49.25' FD.3/4" / 21.02 (REC. 20. 05') IRON REBAR NORTH 1/4 CORNER SEC.9-4-10. /(FD.CI.MON.) O SET 3/4"x24 9 IRON REBAR N89 °49 'W 2671.49 FOUND STONE DISTURBED, SET 3/4"x24" ROUND IRON REBAR. CORNER FALLS IN FIREPIT. SET 3/4"x24" IRON REBAR MOBILE HOME ÿ O 92' BASED 2663. FD.3/4" IRON REBAR SHED MOBILE HOME ARE BEARINGS WEST 1/4 CORNER SEC.10-4-10. (FD.IRON PIPE) . of <u>Z</u> ١

CORNER CODE ξ -13 (2)

SHEET _


- (B) Describe any record evidence, monument evidence, occupational evidence, testimonial evidence or any other material evidence you considered, and whether the monument was found or placed.

 USED Reference monument (from 5-10-1994 Krizan tic sheet) near shed and distance from North 14 Corner 9-4-10 from D.O.T. (see 4-02-04 tie sheet by Barnes) to establish Corner. Found Stone disturbed (in a firepit). Fences from Krizan tic sheet were gone. I believe stone was disturbed from earthwork that may have been done when fences were removed and/or firepit was built.
- C) Was the corner restored through acceptance of (1) an obliterated evidence location, or, (2) a found perpetuated location?

- D) Describe any material discrepancy between the location of the corner as restored or reestablished and the location of that corner as previously restored or reestablished by distance and direction. Show the discrepancy on the plan view drawing under (a), above. Show the distances between the corner as previously restored or reestablished and (1) the corner as restored or reestablished, and (2) to at least 4 of the witness monuments shown on the drawing in (a), above.
- (E) Was the corner reestablished through lost corner proportionate methods? If so, show the method, including the directions and distances to other public land survey corners used as evidence or used for proportioning the corner location.

NO

I, Steven La hrophereby certify that the corner location as identified by the corner code index was determined by me under by direction and control and that this U.S. Public Land Survey Monument Record is correct and complete to the best of my knowledge and belief.

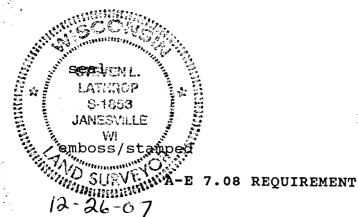

Number of included sheets 2

CORNER CODE

E-13(2)