Paper weight-110# (minimum)

Black nonfading ink required


#### LAND U.S. SURVEY **PUBLIC** MONUMENT RECORD

For Public Land Survey Corners In:

WI ADMINISTRATIVE CODE A-E 7.08 REQUIREMENT

T.  $\frac{4}{10}$  N. R.  $\frac{10}{10}$  E. 4th P.M.

CORNER CODE INDEX

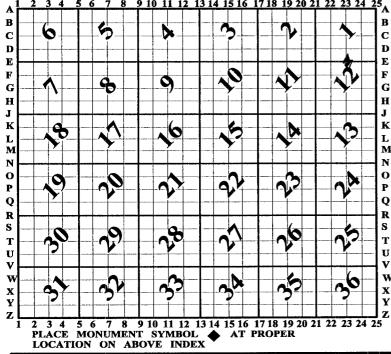

## **UNION TWP ROCK COUNTY WI**

1F AVAILABLE ROCK COUNTY COORDINATES PERFERRED

North	Elev.
East	
Hor. Datum	Vert. Datum
LATITUDE	ELLIPS. HT.
LONGITUDE	
NAD83(91)	NETWORK ADJ. YR 2010
GPS (X)	TRAVERSE (X) X
BASED ON THE	FOLLOWING CONTROL:

**◆ CORNER MONUMENT** 

O WITNESS MONUMENT

(a) ROCK COUNTY PROJECTION BEARINGS ARE BASED ON:\_

FIELD BOOK PAGE #		,	2
OR OBSERVATION SHEET	SHEET	OF	
SHOW A PLAN VIEW DRAWING DEPICTING THE CORNER MONUMENT AND S	SURROUNI	DING	
PHYSICAL FEATURES, INCLUDING THE EXCAVATION AREA AND DEPTH.			
PLANNING & ZONING COMMITTEE ADOPTED THIS FORM ON 12/2/1982			$\langle \cdot \rangle$
CORNER	CODE	123	(I)

#### UN532 N1/4CORSEC12

(B) Describe any record evidence, monument evidence, occupational evidence, testimonial evidence or any other material evidence you considered, and whether the monument was found or placed.

### 1833 HARRISON NOV 5TH 1833

EAST ON RAND BET SECS 1 & 12

2640 TEMPY 1/4 SEC COR

4509.78 BROOK 5.28 CRR SE (NE)

5200.8 INT. E 54.78'N OF P. LAND ROLLING 1ST RATE PRAIRIE

WEST COR. BET 1 & 12

2600.40 QUARTER SEC COR. SET A POST & RAISED MOUND

5200.80 SEC COR.

1870 RUGER AUG REMON-104 EAST ON NORTH LINE OF NW

1/4 SEC 12 ON A VAR 6-50; OFFSET SOUTH 9.9' AT

2618.88 INTERSECTED QUARTER LINE AT QUARTER CORNER. FOUND OLD STAKE AT CORNER. COR VAR 6-37

EAST ON NORTH LINE OF NE 1/4 SEC 12 ON A VAR 6-40'; AT

2620.20 INTERSECTED EAST BOUNDARY LINE 17.16<sup>1</sup>
NORTH OF CORNER. CORNER LOST.
ESTABLISHED IT FROM QUARTER CORNERS NEXT
ADJACENT NORTH AND SOUTH. COR VAR 6-28

1909 KERCH VOL3 PG 51 SHOWS "MON". USED COR TO SUBDIVIDE THE SE 1/4 OF SEC 12.

19?? WIDOT PROJ 1522 SHEET 5 #13295,13296,13313,13297,13298, & 13314 STATES NOTHING ABOUT MON. CALL FOR IT AS STA 5A+00

1962 BATTERMAN JR. VOL 4 PG 147 FD CUT STONE. PLACED TIES.

1972 WEIR CSM VOL 2 PG 270 IRON STAKE FD. 5213.97 TO FD CONC. MON @ N 1/4 COR SEC 1. NORTH 133.40 TO FD IRON STAKE.

1976 BARNES VOL 5 PG 122 REPLACED COR FROM EXISTING

1979 COMBS CSM VOL 8 PG 236 STATES NOTHING ABOUT MON. USED CENTER OF SEC 12 FOR LINE.

1981 COMBS CSM VOL 10 PG 430 SET PIN SOUTH 678.80 & S89-09W TO CI @ NW COR SEC 12

1988 BARNES VOL 6 PG 387 S87-39-59E 2621.10 TO SE COR SEC 1 & N88-32-19W 2624.55 TO SW COR SEC 1

1989 BARNES E-23 FD R/R SPIKE. ACCEPTED FD PERPETUATED LOCATION N88-32-19W 2624.55 TO NW COR SEC 12 & S87-39-59E 2621.10 TO SE COR SEC 1.

1994 KARNS CSM VOL 17 PG 131 FD R/R SPIKE. USED NW COR SEC 12 AS LINE

2008 COMBS CSM VOL 32 PG 93 FD R/R SPIKE. N87-24-02E 2621.21 TO ALUM @ SE COR SEC 1.

# FD R/R WITH FLATTENED HEAD @ CENTER OF PVMT & ON LINE WITH CENTER OF PVMT TO THE WEST.

C) Was the corner restored through acceptance of (1) an obliterated evidence location, or, (2) a found perpetuated location?

## ACCEPTED FD R/R SPIKE.

D) Describe any material discrepancy between the location of the corner as restored or reestablished and the location of that corner as previously restored or reestablished by distance and direction. Show the discrepancy on the plan view drawing under (a), above. Show the distances between the corner as previously restored or reestablished and (1) the corner as restored or reestablished, and (2) to at least 4 of the witness monuments shown on the drawing in (a), above.

I, **Donald Barnes**, hereby certify that the corner location as identified by the corner code index was determined by me under my direction and control and that this U.S. Public Land Survey Monument Record is correct and complete to the best of my knowledge and belief.

SHEET 1 OF 2

CORNER CODE E-23(1)

Barres May 1 2010

