Paper weight-110# (minimum)

Black nonfading ink required

U.S. PUBLIC LAND SURVEY MONUMENT RECORD


For Public Land Survey Corners In:

WI ADMINISTRATIVE CODE A-E 7.08 REQUIREMENT

REV 10/23/2004 USMONREC.DWG

T. $\frac{4}{N}$ N. R. $\frac{10}{E}$ 4th P.M.

CORNER CODE INDEX

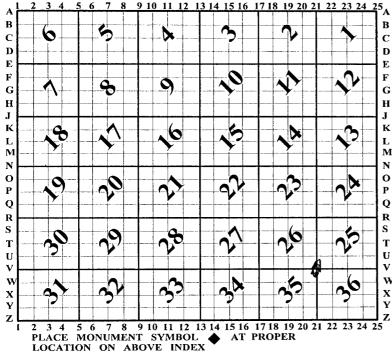

UNION TWP

IF AVAILABLE
ROCK COUNTY COORDINATES PERFERRED

North	Elev.
East	·····
Hor. Datum	Vert. Datum
LATITUDE	ELLIPS. HT
LONGITUDE _	
NAD83(91)	NETWORK ADJ. YR 2010
GPS (X)	TRAVERSE (X) X
BASED ON THE	FOLLOWING CONTROL:

◆ CORNER MONUMENT

WITNESS MONUMENT

CORNER CODE V-2/(2

UN611 NECORSEC35

(B) Describe any record evidence, monument evidence, occupational evidence, testimonial evidence or any other material evidence you considered, and whether the monument was found or placed.

1833 HARRISON (NOV 5TH) NORTH BETWEEN SECS 35 & 36 VAR

2640.00 SET CORNER TO QUARTER SEC {BURR O 10 S33W 49.55'; BURR O 10 S65E 40.26' BURR O 10 & BURR O 10}MARKED

4950.0 ENTER PRIAIRE

5280.00 SET COR TO SECS 25,26,35, & 36 {BURR O 10 N75W 162.36 BURR O 18 S66W 217.8 NOT OTHERS CONVENENT LAND LEVEL 2ND RATE TIMBER ?? BURR O. ??

LAND LEVEL 2ND RATE TIMBER ?? BURR D. ?? GRASS & WEEDS.

1833 HARRISON (NOV 5TH) TOWN 4N RANGE 10E 4TH MER. EAST ON A RAND. BET. 25 & 36

LEAVE PRAIRIE & SET TEMPY 1/4 P

5204.10 INT E BY 49.5' N OF P. 1ST 1/2 LEVEL 1ST RATE PRIAIRIE, 2ND 1/2 LEVEL 1ST RATE WOOD. LAND WITH BURR & TIMBER NO UNDERGROWTH

WEST COR. TO WEST

2602.05 QUARTER SEC COR. {BURR 0 18 S41E 66.0'; BURR 0 12 N4E 63.36' BURR 0 18 & BURR 0 12} MARKED

5204.10 SEC COR

2640.00

1833 HARRISON T4N R10E 4TH MER. EAST ON RANDOM BET 26 & 35

660.00 CREEK 13.2' CRS S.W.

2640.00 TEMPY 1/4 SEC COR

3300 LEAVE PRAIRIE & ENTER TIMBER

5203.44 INT. E BDY N OF P IN W. EDGE OF PRAIRIE LAND 1ST 1/2 LEVEL & WET 3 RATE 2ND 1/2 LEVEL 2ND RATE WITH BURR O TIMBER

WEST COR WEST BET SECS 26 & 35

1232.88 BURR 0 12 IN DIAM

2601.72 QUARTER SEC. COR. IN MARSH - POST & RAISED MOUND

5203.44 INT SEC COR.

1833 HARRISON T4N R10E 4TH MER. NORTH BETWEEN SECS 25
& 26

1650. LEFT PRAIRIE & ENTER TIMBER

2640.00 QUARTER SEC. COR. {BURR O 48 N89R 5.94'; BURR O 10 N70W 19.14'?? BURR O 18

& BURR O 10}MARKED

5280.00 SET COR TO SECS 23,24,25,26 {BURR 0 18 S33W 20.46', BURR 0 18 S22E 208.56'; BURR 0 18 N30E 45.54'; BURR 0 18 N BLANK W 19.14' LAND ROLLING 2ND RATE ??? BRO?? TIMBER RED BURR AND W.O. MOSTLY GRASS ?? & WEEDS

1867 LOCKE VOL 1 PG 301 & #5277 STATES NOTHING ABOUT MON. VAR 7-00 2612.28 TO N 1/4 COR SEC 36. N 1/4 COR SEC 36 LOST. SET STAKE (FROM CORNERS OF SEC) WITH HH ON N,S,E, & W IN MOUND.

1870 RUGER AUG REMON-60 SOUTH ON WEST LINE OF NW 1/4 SEC 36 ON A VAR 7-DO OFFSET EAST 3.3' OFFSET WEST 11.22' AT

SHEET 1 OF 4

corner code V-21(2)

Emboss Farroj

UN611 NECORSEC35

2652.54 INTERSECTED QUARTER LINE 6.6' WEST OF QUARTER COR. FOUND STAKE SET BY LOCKE AND REMAINS OF BOTH STUMPS OF BEARING TREES. COR VAR 6-58

SOUTH ON WEST LINE OF SW 1/4 SEC 36 ON A VAR 6-30 AT 2653.20 INTERSECTED SOUTH BOUNDARY LINE 11.22' WEST OF CORNER. FOUND STAKE SURROUNDED BY STONES SET BY LOCKE AT COR. FOUND STUMP OF NW BEARING TREE AND WHERE STUMP OF NE BEARING TREE HAD BEEN DUG UP. COR VAR 6-45

1870 RUGER AUG RENON-59 WEST ON NORTH LINE OF NE 1/4 OF SEC 36 ON A VAR 6-15 OFFSET SOUTH 21.95' AT

2619.54 FELL 3.3' SOUTH OF QUARTER CORNER ESTABLISHED BY LOCKE. HIS RECORD OF SAID SURVEY IN COUNTY SURVEYOR'S RECORD BOOK. SHOWS THAT HE ESTABLISHED SAID QUARTER COR. AT A POINT IN A TRUE LINE BETWEEN AND EQUI-DISTANT FROM THE NE AND NW CORNERS OF SAID SECTION. THE QUARTER COR. ESTABLISHED BY THE UNITED STATES SURVEYOR HAVING BEEN DESTROYED. I SEARCHED FOR THE QUARTER CORNER. AS ESTABLISHED IN THE UNITED STATES SURVEY, BUT COULD FIND NO TRACE OF IT OR OF THE BEARING TREES, AND I WAS INFORMED BY CREDIBLE PARTIES CONVERSANT WITH THE FACTS, THAT THE ORIGINAL QUARTER CORNER HAD BY MISTAKE BEEN LOCATED CONSIDERABLY TOO FAR TO THE EAST, AND THAT IT AND THE BEARING TREES HAD BEEN PURPOSILY REMOVED AND ALL TRACES OF THEM DESTROYED SEVERAL YEARS BEFORE.

CONTINUED WEST ON A VAR 6-39 OFFSET SOUTH 12.54' AT

5239.08 INTERSECTED WEST BOUNDARY LINE 12.54'
SOUTH OF COR. FOUND OLD STAKE AND
STUMPS OF NW BEARING TREE AND REMAINS OF
STUMP OF SW BEARING TREE. ESTABLISHED
THE NORTH QUARTER CORNER OF SECTION 36
IN A TRUE LINE BETWEEN AND AT A POINT EQUIDISTANT FROM THE NE & NW CORNERS OF SAID
SECTION. IT BEING DISTANT FROM EACH
2619.54 AND IN THE SAME PLACE AS
ESTABLISHED BY LOCKE. CORRECTED
VARIATION ON NORTH LINE OF SECTION 36 6-39

1870 RUGER AUG REMON-64 WEST ON NORTH LINE OF NE 1/4 SEC 35 ON A VAR 7-10 OFFSET SOUTH 15.51' COULD FIND NO TRACE OF NORTH QUARTER CORENR. CONTINUED WEST ON SAME VARIATION AS ABOVE GIVEN AT

5239.74 INTERSECTED WEST BOUNDARY LINE 29.04'
SOUTH OF CORNER. COR VAR 7-01
ESTABLISHED NORTH QUARTER CORNER AT A
POINT IN A TRUE LINE BETWEEN AND EQUIDISTANT FROM THE NE & NW CORNERS OF SAID
SECTION IT BEING DISTANT FROM EACH 2619.87'

SHEET 2 OF 4

Parte Facilies Oct 20,201/

CORNER CODE V-21(2)

UN611 NECORSEC35

- 1870 RUGER AUG 17 REMON-65 NORTH ON WEST LINE OF SW1/4
 SEC 25 ON A VAR 7-02 OFFSET WEST 18.48' AT
 - 2654.36 INTERSECTED QUARTER LINE 28.38' WEST OF QUARTER CORNER FOUND STAKE WITH STONE ON TOP OF IT SET BY LOCKE AT CORNER. ALSO FOUND WEST BEARING TREE AND STUMP OF EAST BEARING TREE.

 COR VAR 6-49 AUGUST 18, 1870

 NORTH ON WEST LINE OF NW 1/4 SEC 25 ON A VAR 7-08 OFFSET WEST 11.88' OFFSET WEST
 - 3.63' AT

 2663.76 INTERSECTED NORTH BOUNDARY LINE 1.65'
 EAST OF COR. FOUND OLD STAKE AT CORNER.
 TESTED IT AND FOUND IT CORRECT. COR VAR
- 1962 BATTERMAN VOL 4 PG 146 FD MON

7-25

- 1967 BATTERMAN VOL 4 PG 297 FD CUT STONE 0.5 EAST OF N/S FENCE LINE & 0.5 NORTH OF E/W FENCE LINE
- 1972 COMBS #5272 FD CUT STONE @ NE COR SEC 35 2623.20
 TO CUT STONE MON. @ N 1/4 COR SEC 10
- 1974 SCHROEDER CSM VOL 4 PG 7 STATES NOTHING ABOUT MON. WEST 1311.60 THENCE SO-57W 2626.70.
- 1978 LEE CSM VOL 7 PG 233 LS . WEST 1311.51 THENCE SO-56-45W 2626.71
- 1980 BARNES VOL 6 PG 27 FD CUT LIMESTONE. 282,599.4X; 2,196,163.9X S89-47-34E 2619.50 TO N 1/4 COR SEC 36, SO-05-02E 2650.47 TO CUT LS @ W 1/4 COR SEC 36. GRID NORTH AT SW COR SEC 36 FROM TRUE NORTH IS + 0-05-48
- 1984 LEE CSM VOL 11 PG 454 STONE MON @ W 1/4 COR SEC 25 & SW COR SEC 25. 2658.95 BETWEEN STONES.
- 1993 BIRRNKOTT V-21 FD CONCRETE MON AS TIED BY
 BATTERMAN ON APRIL 5, 1967. RESET TIES AS SHOWS. 6X6
 LIMESTONE MON WITH CROSS ON THE TOP. 1.7' NORTH OF
 E/W FENCE.
- 1993 BIRRONKOTT CSM VOL 16 PG 378 FD STONE. NO-32-11W 2659.01 TO STONE @ E 1/4 COR SEC 26 & S89-23-12W 2622.52 TO STONE @ S 1/4 COR SEC 26
- 1994 BARNES VOL 6 PG 440 SO-04-58E 2650.48 TO W 1/4 COR SEC 36 & S89-47-28E 2619.51 TO N 1/4 COR SEC 36
- 1996 COMBS CSM VOL 19 PG 431 LS NO-29-15W 2658.97 TO LS @ E 1/4 COR SEC 26
- 1997 COMBS CSM VOL 20 PG 134 LS NO-29-15W 2658.97 TO LS @ E 1/4 COR SEC 26 & SB9-30-22W 624.72 ALONG 1/4 LINE TO EAST R/W LINE OF BROWN SCHOOL RD.
- 1998 KNUDSON #8178 FD SQUARE STONE. S89-53-54E 2619.33
 TO SQUARE STONE @ S 1/4 COR SEC 25, SO-11-17E
 2650.37 TO SQUARE STONE @ W 1/4 COR SEC 36, NO-0228W 2659.07 TO SQUARE STONE @ W 1/4 COR SEC 25
- 2000 COMBS CSM VOL 23 PG 313 FD LS 2658.97 TO LS @ E 1/4 COR SEC 26
- 2001 COMBS BK32 PG 521 MORNINGRIDGE ESTATE 5TH ADDITION" LS. NO-55W 2658.93 TO LS @ W 1/4 COR SEC 25.
- 2000 COMBS CSM VOL 23 PG 313 FD LIMESTONE. NO-29-15W 2658.97 TO LS @ E 1/4 COR SEC
- 2003 WIDOT V-21(1) & #25088 USH 14 CUT STONE 302,035.09; 427,018.560' NO-06-14E 2660.73 TO E 1/4 COR SEC 26. PROJ 5155-00-22 SHEET 4.5 DATED 4-10-2003
- 2004 WIDOT USH 14 PROJ 5155-00-22 SHEET 4.5 #25368,25291 CUT STONE 302,035.090; 427,018.560 NO-06-14E 2660.73 TO CUT STONE @ E 1/4 COR SEC 26

SHEET 3 OF 4

Bacos Oct 20, 2011

corner code V-21(2)

2005 COMBS CSM VOL 29 PG 80 2005 COMBS CSM VOL 29 PG 80 FD LS. @ W 1/4 COR SEC 25 & SW COR SEC 25. 2658.93 BETWEEN MONUMENTS.

2006 COMBS CSM VOL 30 PG 71 FD LIMESTONE @ W 1/4 & SW CORNERS OF SEC 25. 2658.93 BETWEEN LIMESTONES.

I ACCEPTED TIES AS PLACED BY BIRRENKOTT. I USED MY OLD OBSERVATIONS IN TWP ADJUSTMENT.

C) Was the corner restored through acceptance of (1) an obliterated evidence location, or, (2) a found perpetuated location?

ACCEPTED FD PERPETUATED LOCATION.

D) Describe any material discrepancy between the location of the corner as restored or reestablished and the location of that corner as previously restored or reestablished by distance and direction. Show the discrepancy on the plan view drawing under (a), above. Show the distances between the corner as previously restored or reestablished and (1) the corner as restored or reestablished, and (2) to at least 4 of the witness monuments shown on the drawing in (a), above.

NONE

(E) Was the corner reestablished through lost corner proportionate methods? If so, show the method, including the directions and distances to other public land survey corners used as evidence or used for proportioning the corner location.

NO

I, **Donald Barnes**, hereby certify that the corner location as identified by the corner code index was determined by me under my direction and control and that this U.S. Public Land Survey Monument Record is correct and complete to the best of my knowledge and belief.

SHEET 4 OF 4

fight faires paires out 20, 2011

CORNER CODE V-21(2)

A.E. 7.08 REQUIREMENT