Paper weight-110# (minimum)


Black nonfading ink required

LAND U.S. **SURVEY** PUBLIC MONUMENT RECORD

WI ADMINISTRATIVE CODE A-E 7.08 REQUIREMENT For Public Land Survey Corners In:

T. 4 N. R. 10 E. 4th P.M.

CORNER CODE INDEX

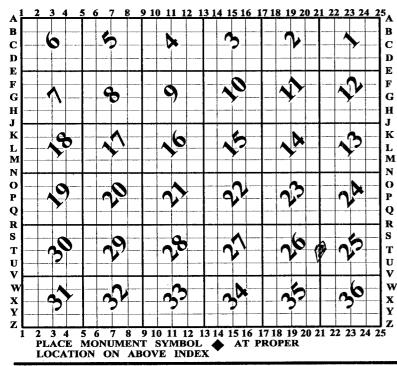

UNION TWP ROCK COUNTY WI

IF AVAILABLE ROCK COUNTY COORDINATES PERFERRED

North	Elev
East	
Hor. Datum	Vert. Datum
LATITUDE _	ELLIPS. HT.
LONGITUDE _	
NAD83(91)	NETWORK ADJ. YR 2010
GPS (X)	TRAVERSE (X) X
BASED ON THI	E FOLLOWING CONTROL:

◆ CORNER MONUMENT

WITNESS MONUMENT

(a) ROCK COUNTY PROJECTION BEARINGS ARE BASED ON:_

FIELD BOOK PAGE # OR OBSERVATION SHEET	SHEET	OF	4
SHOW A PLAN VIEW DRAWING DEPICTING THE CORNER MONUMENT AND PHYSICAL FEATURES, INCLUDING THE EXCAVATION AREA AND DEPTH.	SURROUN	DING	(z)
PLANNING & ZONING COMMITTEE ADOPTED THIS FORM ON 12/2/1982	CODE	T-211	シスタ
CORNER	CODE	1 -11	ヤノ

UN599 W1/4CORSEC25

(B) Describe any record evidence, monument evidence, occupational evidence, testimonial evidence or any other material evidence you considered, and whether the monument was found or placed.

1833 HARRISON T4N R10E 4TH MER. NORTH BETWEEN SECS 25 & 26

1650. LEFT PRAIRIE & ENTER TIMBER

2640.00 QUARTER SEC. COR. {BURR 0 48 N89R 5.94'; BURR 0 10 N70W 19.14'?? BURR 0 18

& BURR O 10 MARKED

5280.00 SET COR TO SECS 23,24,25,26 {BURR 0 18 S33W 20.46', BURR 0 18 S22E 208.56'; BURR 0 18 N30E 45.54'; BURR 0 18 N W 19.14' LAND ROLLING 2ND RATE ??? BRO?? TIMBER RED BURR AND W.O. MOSTLY GRASS ?? &

WEEDS

- 1856 CHURCH VOL 1 PG 63 STATES NOTHING ABOUT MON. USED TO SUBDIVIDE SEC 26. 2630.76 TO CENTER OF SEC 26 & 5261.52 TO W 1/4 COR SEC 26
- 1865 LOCKE VOL 1 PG 232 FD WEST B.T. & STUMP OF EAST AND OLD STAKE W.BT 11.88 SET O. STAKE OVER IT HARD HEAD 13X9X7 1/2. VAR 7-32 2662.77 TO NE COR SEC 26, VAR7-16 2628.45 TO CENTER OF SEC 26, VAR 7-16 5256.90 TO W 1/4 COR SEC 26
- 1865 LOCKE VOL 1 PG 233 SEE SEC 26. USED TO SUBDIVIDE SEC 25. VAR7-06 2606.34 TO CENTER OF SEC 25, VAR 7-06 5212.68 TO E 1/4 COR SEC 25, & 2662.44 TO NW COR SEC 25
- 1870 RUGER AUG 17 REMON-65 NORTH ON WEST LINE OF SW1/4
 SEC 25 ON A VAR 7-02 OFFSET WEST 18.48' AT
 - 2654.36 INTERSECTED QUARTER LINE 28.38' WEST OF QUARTER CORENR FOUND STAKE WITH STONE ON TOP OF IT SET BY LOCKE AT CORNER. ALSO FOUND WEST BEARING TREE AND STUMP OF EAST BEARING TREE.

COR VAR 6-49 AUGUST 18, 1870 NORTH ON WEST LINE OF NW 1/4 SEC 25 ON A VAR 7-08 OFFSET WEST 11.88' OFFSET WEST 3.63' AT

- 2663.76 INTERSECTED NORTH BOUNDARY LINE 1.65'
 EAST OF COR. FOUND OLD STAKE AT CORNER.
 TESTED IT AND FOUND IT CORRECT. COR VAR 725
- 1884 RUGER VOL 2 PG 294 STATES NOTHING ABOUT MON. USED TO SUBDIVIDE SEC 25. VAR 5-34 2612.28 TO CENTER OF SEC 25, VAR 5-34 5221.92 TO E 1/4 COR SEC 25
- 1962 BATTERMAN VOL 4 PG 118 FD MON.
- 1962 BATTERMAN VOL 4 PG 146 FD MON.
- 1962 THOM #5195 FD CUT STONE MON AT THE E 1/4 COR SEC 26.
 WEST 1320.95 TO 1" PIPE IN CTH M. WHICH IS 385.80'
 NORTH OF CENTER OF USH 14. STATES NOTHING ABOUT
 MON @ CENTER OF SEC 26 BUT SHOWS A CIRCLE.
- 1963 BATTERMAN #6993 & 5194 SET 3/8" PIN @ N 1/16TH COR OF SE 1/4 OF SEC 26 & ANGLE OF 89-17-X ALONG EASTERLY E/W 1/4 LINE TO FD 1" PIPE @ THE NW COR OF THE E 1/2 OF THE SE 1/4 SEC 6. PROBLEM WITH DRAWING CALLS OF CENTER & E 1/4 COR SEC 26. STATES FD CUT STONE MON AT E 1/4 COR SEC 26 & WEST 876.25 TO SET 1" PIPE @ SE COR OF LOT.
 1320.95 FROM E 1/4 COR SEC 26 GO FD 1" PIPE @ NW COR

1320.95 FROM E 1/4 COR SEC 26 GO FD 1" PIPE @ NW COR OF THE E 1/2 OF THE SE 1/4 OF SEC 26

1975 COMBS CSM VOL 4 PG 288 STATES NOTHING ABOUT MON.

SHEET 1 OF 4

CORNER CODE T-21(1)

Barnes Oct 27, 2011

- UN599 W1/4CORSEC25
- 1976 COMBS CSM VOL 5 PG 206 STATES NOTHING ABOUT MON.
- 1978 COMBS CSM VOL 8 PG 130 STATES NOTHING ABOUT MON.
- 1978 SHEARMAN #5213 & 5203 STATES NOTHING ABOUT MON.
 CALLS FOR 1 1/4X30 IRON BAR 33.0 SOUTH OF COR. S8937-30E 2634.16 TO RR SPIKE @ CENTER OF SEC 26, S0-1357E 2659.23 TO SW COR SEC 26.
- 1982 COMBS CSM VOL 11 PG 206 STATES NOTHING ABOUT MON.
- 1983 LEE CSM VOL 11 PG 320 N89-59-15W
- 1984 LEE CSM VOL 11 PG 454 STONE MON @ W 1/4 COR SEC 25 & SW COR SEC 25. 2658.95 BETWEEN STONES.
- 1985 BARNES T-21 FD CUT LIMESTONE 1' ABOVE GROUND. SET CARSONITE. REFERENCED SAME. NORTH OF E/W DIRT FARM LANE, 7' EAST OF UP, & ON LINE WITH E/W & N/S FENCE
- 1985 BARNES VOL 6 PG 340 S89-27-41W 2641.39 TO CENTER OF SEC 26 & 5275.12 TO W 1/4 COR SEC 26. SHOWS RECORD DISTANCES.
- 1985 COMBS #13214 FD STONE MON.
- 1986 COMBS #13390 FD CUT STONE MON. SOUTH 761.58 TO CENTER OF STH 14
- 1988 LEE BK 32 PG 57 "COUNTYSIDE ESTATES" CUT STONE. NO-22-00E 1299.53 & N89-07-28W 1317.04 TOWARDS PK SET FROM TIES @ W 1/4 COR SEC 26. IN NORTH RD ROW
- 1990 DOT #17394 CUT STONE.
- 1990 KARNS #2092 CUT STONE. NO-23-30W 1484.60 TO FD IRON STAKE ON SEC LINE
- 1992 KARNS CSM VOL 15 PG 491 CUT STONE.
- 1993 COMBS CSM VOL 16 PG 254 STONE @ W 1/4 & E 1/4 CORNERS OF SEC 25. 5229.70 BETWEEN STONES.
- 1993 BIRRENKOTT CSM VOL 16 PG 378 FD STONE. SO-32-11E 2659.01 TO STONE @ SE COR SEC 26 & S89-27-11W 2641.21 FD ALUM @ CENTER OF SEC 26
- 1993 COMBS BK 32 PG 175 "MORNINGRIDGE ESTATES" FD STONE @ W 1/4 & NW CORNERS SEC 25. 2664.80 BETWEEN STONES.
- 1994 COMBS BK 32 PG 211 "GLACIER VALLEY ESTATES" LS 5229.70 TO LS @ E 1/4 COR SEC 25
- 1995 COMBS BK 32 PG 252 "MORNINGRIDGE ESTATES FIRST ADDITION" FD STONE @ W 1/4 & NW CORNERS SEC 25. 2664.80 BETWEEN STONES.
- 1995 COMBS BK 32 PG 274 "MORNINGRIDGE ESTATES SECOND ADDITION" FD STONE @ W 1/4 & NW CORNERS SEC 25. 2664.80 BETWEEN STONES.
- 1995 COMBS CSM VOL 19 PG 83 LS 5229.70 TO LS @ E 1/4 COR SEC 25
- 1996 COMBS CSM VOL 16 PG 200 FD STONES @ NE COR SEC 26 & E 1/4 COR SEC 26. 2664.8X BETWEEN STONES. WEST 1040.22 TO PIN ON EAST R/W LINE OF CTH M & SO-11-55E TO E 1/4 COR SEC 26
- 1996 COMBS BK 32 PG 315 "MORNINGRIDGE ESTATES THIRD ADDITION" FD STONE @ W 1/4 & NW CORNERS SEC 25. 2664.80 BETWEEN STONES.
- 1996 COMBS BK 32 PG 317 "MORNINGRIDGE ESTATES FOURTH ADDITION" FD STONE @ W 1/4 & NW CORNERS SEC 25. 2664.80 BETWEEN STONES.
- 1996 COMBS CSM VOL 19 PG 431 LS SO-29-15E 2658.97 TO LS @ SE COR SEC 26 & S89-30-22W 1349.72
- 1997 COMBS CSM VOL 20 PG 83 FD LS @ W 1/4 & E 1/4 SEC 25. 5229.70 BETWEEN LIMESTONES.

SHEET 2 OF 4

CORNER CODE T-21(1)

Baires 1 ct 27,2011

- UN599 W1/4CORSEC25
- 1997 COMBS CSM VOL 20 PG 134 FD LS @ E 1/4 COR SEC 26 & SE COR SEC 26. SO-29-15E 2658.97 & S89-30-22W 404.12 TO PIN
- 1997 COMBS BK 32 PG 347 "GLACIER VALLEY ESTATES FIRST ADDITION" FD LS @ W 1/4 COR SEC 25 & E 1/4 COR SEC 35. 5229.70 BETWEEN LIMESTONES.
- 1997 KIENBAUM BK 32 PG 390 "COUNTRY SIDE ESTATES PLAT NO. 5" FD LS. N89-07-08W 2641.16 TO DOT MON IN MON BOX @ CENTER OF SEC 26
- 1998 KNUDSON #8178 FD 6" SQ STONE. S89-53-23E 5229.57 TO LS @ E 1/4 COR SEC 25, S89-56-51W 2641.25 TO ALUM @ CENTER OF SEC 26
- 1999 KNUDSON #7227 FD SQUARE STONE MON OF REC. S89-53-23E 5229.57 TO SQUARE STONE @ E 1/4 COR SEC 25, S89-56-51W 2641.25 TO ALUM @ CENTER OF SEC 26, & SO-02-28E 2659.07 TO SQUARE STONE @ SW COR SEC 25
- 1999 KIENBAUM BK 32 PG 462 "COUNTRYSIDE ESTATES PLAT NO. 6". FD LIMESTONE. USED DOT ALUM. IN MON BOX @ CENTER OF SEC 26 FOR LINE.
- 2000 COMBS CSM VOL 23 PG 247 FD LIMESTONE. USED DOT ALUM. IN MON BOX @ CENTER OF SEC 26 FOR LINE. 2641.28 BETWEEN MONUMENTS.
- 2000 COMBS CSM VOL 23 PG 313 FD LIMESTONE. S0-29-15E 2658.97 TO LS @ SE COR SEC 26 & S89-30-22W 220.60 ALONG E/W 1/4 LINE OF SEC 26
- 2001 COMBS BK 32 PG 521 "MORNINGRIDGE ESTATES FIFTH ADD." FD LIMESTONE 2658.93 TO LS @ SW COR SEC 25.
- 2001 COMBS CSM VOL 25 PG 183 #14297 FD STONE MON. FROM NE COR SEC 26 SO-11-55E TO FD STONE MON @ E 1/4 COR SEC 26.
- 2003 WIDOT T-21(1) PROJ 5155-00-22 SHEET 4.4 DATE 4-10 2003; CUT LIMESTONE 304,695.820; 427,023.390 N89-54 19W 2641.42 TO CEN SEC 26 & SO-06-14W 2660.73 TO SE COR SEC 26
- 2003 KIENBAUM BK 32 PG 598 "COUNTRYSIDE ESTATES PLAT NO. 7". FD LS. NO-00-47E 295.65 & N89-07-08W 2641.16 TO DOT ALUM IN MON BOX @ CENTER OF SEC 26.
- 2003 COMBS CSM VOL 26 PG 213 FD LS. S0-55-00E 2658.93 TO LS @ SW COR SEC 25 & N89-14-20E 339.58 ALONG E/W 1/4 LINE.
- 2003 WIDOT USH 14 PROJECT 5155-00-22 SHEET 4.4 & 4.5 #25088, 25291, 25087, 25366,25290, 25289 CUT LIMESTONE. 304,695.820; 427,023.390
- 2005 COMBS CSM VOL 29 PG 80 FD LS. @ W 1/4 COR SEC 25 & SW COR SEC 25. 2658.93 BETWEEN MONUMENTS.
- 2006 COMBS BK32 PG 763 "GRANDORCHARD ESTATES". FD LS N89-54-25W 2641.27 TO FD DOT DISK @ CENTER OF SEC 26 & N0-08-08W 1192.34 TO REROD
- 2006 COMBS CSM VOL 30 PG 71 FD LIMESTONE @ W 1/4 & SW CORNERS OF SEC 25. 2658.93 BETWEEN LIMESTONES.
- 2007 COMBS CSM VOL 31 PG 223 FD STONE @ NE COR SEC 26 & E 1/4 COR SEC 26. 2664.94 BETWEEN STONES.

SHEET 3 OF 4

CORNER CODE T-21(1)

UN599 W1/4CORSEC25

FD CUT LIMESTONE, CARSONITE POST & REFERENCE MONUMENTS.

C) Was the corner restored through acceptance of (1) an obliterated evidence location, or, (2) a found perpetuated location?

ACCEPTED FD CUT LIMESTONE

D) Describe any material discrepancy between the location of the corner as restored or reestablished and the location of that corner as previously restored or reestablished by distance and direction. Show the discrepancy on the plan view drawing under (a), above. Show the distances between the corner as previously restored or reestablished and (1) the corner as restored or reestablished, and (2) to at least 4 of the witness monuments shown on the drawing in (a), above.

NONE

(E) Was the corner reestablished through lost corner proportionate methods? If so, show the method, including the directions and distances to other public land survey corners used as evidence or used for proportioning the corner location.

 $N\Box$

I, **Donald Barnes**, hereby certify that the corner location as identified by the corner code index was determined by me under my direction and control and that this U.S. Public Land Survey Monument Record is correct and complete to the best of my knowledge and belief.

SHEET 4 OF 4

Danes 6 ct 27,2011

CORNER CODE T-21(1)

A.E. 7.08 REQUIREMENT