

# PLAT AND RECORD

515

V-4

COUNTY BUILDING  
CITY OF JANESVILLE

COUNTY BUILDING  
CITY OF JANESVILLE

Of a Survey on Section 26 T2N R13 E. of the 4 P. M. in LAPRAIRIE Township


Rock County, Wisconsin, made JULY the 6 1971

I hereby certify that the following is a correct record of said survey as made by me.

**MICROFILMED**

*[Handwritten Signature]*  
County Surveyor.

THE GEO. S. BARNARD COMPANY, ST. LOUIS

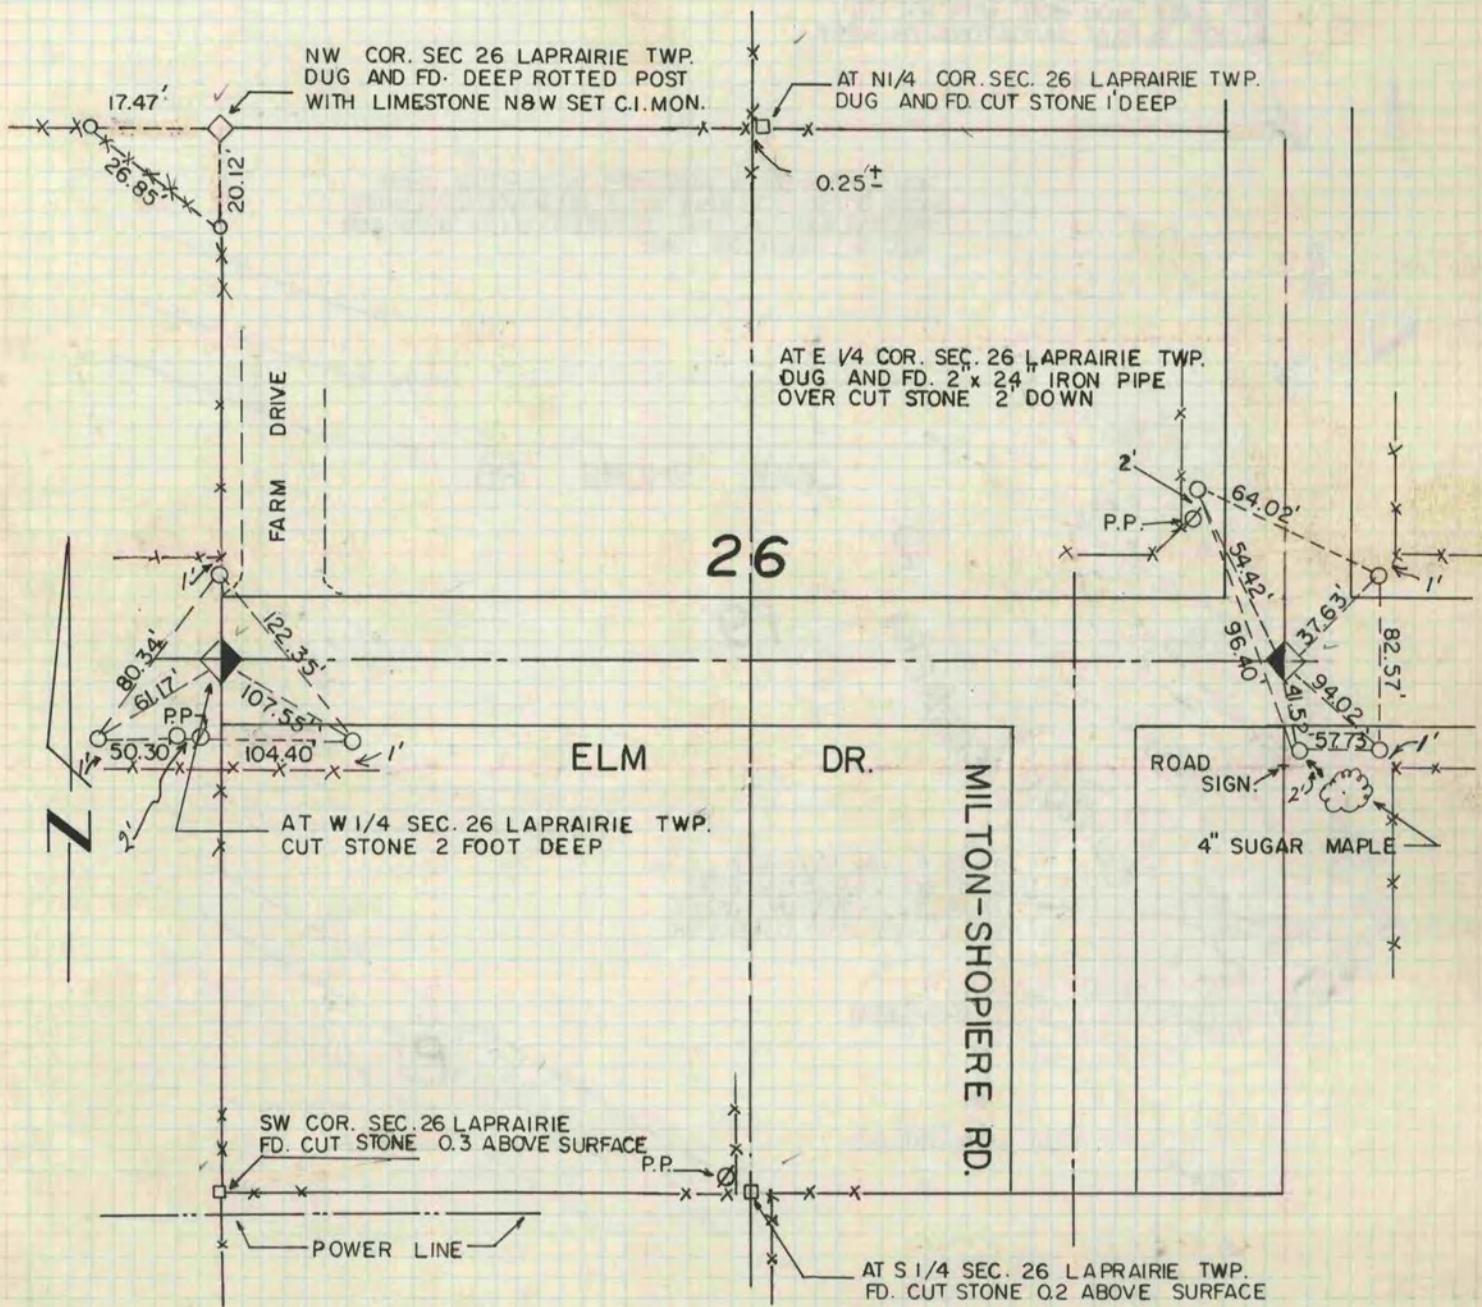

0=1" x 24" IRON PIPE REF. MON.

7-6-71  
JMS  
B.K.  
J.E.L.