

# U.S. PUBLIC LAND SURVEY MONUMENT RECORD

For Public Land Survey Corners in:

WI ADMINISTRATIVE CODE A-E 7.08 REQUIREMENT

T. 2N., R. 12E

CORNER CODE INDEX

|   |   |   |   |   |   |   |   |   |    |    |    |    |    |    |    |    |    |    |    |    |    |    |    |    |  |
|---|---|---|---|---|---|---|---|---|----|----|----|----|----|----|----|----|----|----|----|----|----|----|----|----|--|
| 1 | 2 | 3 | 4 | 5 | 6 | 7 | 8 | 9 | 10 | 11 | 12 | 13 | 14 | 15 | 16 | 17 | 18 | 19 | 20 | 21 | 22 | 23 | 24 | 25 |  |
| A |   |   |   |   |   |   |   |   |    |    |    |    |    |    |    |    |    |    |    |    |    |    |    |    |  |
| B |   |   |   |   |   |   |   |   |    |    |    |    |    |    |    |    |    |    |    |    |    |    |    |    |  |
ROCK TWP  
ROCK COUNTY WI

IF AVAILABLE  
ROCK COUNTY COORDINATES PERFERRED

North \_\_\_\_\_ Elev. \_\_\_\_\_  
East \_\_\_\_\_  
Hor. Datum \_\_\_\_\_ Vert. Datum \_\_\_\_\_  
LATITUDE \_\_\_\_\_ ELLIPS. HT. \_\_\_\_\_  
LONGITUDE \_\_\_\_\_  
GPS (X) \_\_\_\_\_ TRAVERSE (X) \_\_\_\_\_  
BASED ON THE FOLLOWING CONTROL:  
\_\_\_\_\_

PLACE MONUMENT SYMBOL  AT PROPER LOCATION ON ABOVE INDEX

- CORNER MONUMENT
- WITNESS MONUMENT

BEARINGS ARE BASED ON: \_\_\_\_\_

FIELD BOOK \_\_\_\_\_ PAGE # \_\_\_\_\_  
SHOW A PLAN VIEW DRAWING DEPICTING THE CORNER MONUMENT AND SURROUNDING PHYSICAL FEATURES, INCLUDING THE EXCAVATION AREA AND DEPTH.  
PLANNING & ZONING COMMITTEE ADOPTED THE ABOVE FORM ON 12/2/1982

SHEET 1 OF 4

CORNER CODE V-1(1)

PL613

(B) Describe any record evidence, monument evidence, occupational evidence, testimonial evidence or any other material evidence you considered, and whether the monument was found or placed.

- 1833 MULLET *NORTH ON EAST SIDE SECTION 25*  
2640 SET QUARTER SECTION POST BLACK OAK 12 S9W  
117.48' BLACK OAK 8 N1W 314.16'  
3168 ENTER PRAIRIE  
3762 LEAVE PRAIRIE AND ENTER MARSH  
5280 SET POST CORNER SECTION 24 & 25 AND RAISED A  
MOUND LAND FIRST  $\frac{3}{4}$  ROLLING SECOND RATE  
TIMBERED WITH WHITE BLACK AND BUR OAK ASPENS C  
LAST  $\frac{1}{4}$  MARSH  
*NORTH ON EAST SIDE SECTION 36 VAR 8-00 E*  
1758.9 WHITE OAK 16 IN DIAMETER  
2640 SET QUARTER SECTION POST WHITE OAK 12 N22W  
16.5'; WHITE OAK 16 S12W 15.18'  
5280 SET POST CORNERS SECTIONS 25 & 36 WHITE OAK  
12 N59W 227.7'; WHITE OAK 18 S70W 239.58'  
LAND ROLLING SECOND RATE TIMBERED WITH  
WHITE BLACK AND BUR OAK.
- 1833 HARRISON *EAST ON RANDOM BETWEEN  
SECS 25 & 36 (VAR 8-00E)*  
2640 TEMPY  $\frac{1}{4}$  P  
5273.4 INT. E BDY 62.04' NORTH OF POST. LAND BDG 1<sup>ST</sup>  
RATE, TIMBER RED & W.O. ASPEN CHERRY ELM WALNUT  
& ? OF HAZEL WEEDS  
*WEST COR. WEST*  
392.04 W.O. 36  
918.72 W.O. 18  
2636.7 QUARTER SEC COR. WALNUT 15 N72E 6.60'; WALNUT  
24 S33W 3.96' WALNUT 15 WALNUT 24} MARKER  
4224 ELM 12  
4953.96 W.O. 12  
5273.4 SEC COR.
- 1834 HARRISON *WEST ON RAND BET 30 & 31 T2N R12E*  
2640 TEMPY  $\frac{1}{4}$  SEC COR  
5331.48 INT. W BDY 15.84' S OF P LAND BDY 2<sup>ND</sup> RATE WITH  
WO & RED O TIMBER LAST  $\frac{1}{2}$  MILE MUCH  
UNDERGROWTH. HAZEL ???  
*COR EAST*  
2691.48  $\frac{1}{4}$  SEC COR {WO 24 S77E 181.5' RED O 12 S71W  
W.O. 24 RED O 12} MARKED  
5331.48 SEC COR
- 1852 McVEAL VOL 1 PG 14 2655.18 TO N  $\frac{1}{4}$  COR SEC 36.  
1854 TOWN ROAD RECORDS BK 1 PG 35 BEGINNING AT THE NE  
COR OF SEC 25 IN THE TOWN OF PLYMOUTH RUNNING THENCE  
SOUTH ON THIS TOWN LINE BETWEEN SAID TOWNS TO THE SOUTH  
LINE OF THE TOWNS AFORESAID; AND THAT THE ""
- 1868 LOCKE PG 4 *SOUTH ON EAST SIDE OF SEC 25 VAR 6-50*  
1320 LEFT MARSH  
2659.8 INTERSECTED  $\frac{1}{4}$  LINE 20.46' E OF COR. FOUND  
STUMPS OF B.T.S AND OLD STAKE COR 1.32' EAST  
AND 17.49' SOUTH OF COR POST TO FENCE ON  
WEST SIDE OF LANE RUNNING NORTH VAR  
CORRECTED 6-23 $\frac{1}{2}$   
*CONTINUED SOUTH FROM  $\frac{1}{4}$  COR WITH VAR 6-45*  
5308.71 INTERSECTED SOUTH BOUNDARY AT COR. FOUND  
STONE (SET BY CHURCH) & WHERE B.T.S WERE  
DUG OUT COR IN CENTER OF HIGHWAYS.  
PG 5 *WEST BETWEEN SECS 25 & 36 VAR 5-40*  
2659.14 INTERSECTED  $\frac{1}{4}$  LINE 10.56' SOUTH OF COR. FOUND  
WHERE BTS WERE DUG OUT AND OLD STAKE. COR  
20.46' SOUTH OF FENCE ON NORTH

Donald Barnes

SHEET 1 OF 4 CORNER CODE V-1(1)

6-20-03

SIDE OF HIGHWAY AND IN LINE WITH FENCE RUNNING NORTH VAR CORRECTED 5-26

*CONTINUED WEST FROM 1/4 COR WITH VAR 5-40*

- 5304.42 INTERSECTED WEST BOUNDARY 48.18' SOUTH OF COR. FOUND COR AS SET BY SELF (SEE COUNTY SURVEYORS RECORD SEC 26) AND STUMP OF B.T. IN SEC 26 VAR CORRECTED 4-38 COR IN CENTER OF HIGHWAYS AUG 18 1868
- 2661.12 PG 7 SOUTH ON EAST LINE SEC 36 VAR 7-25 INTERSECTED 1/4 LINE 3.3' EAST OF COR. FOUND STUMPS OF B.T.S AND OLD STAKE. VAR CORRECTED 7-21
- CONTINUED SOUTH FROM 1/4 COR WITH VAR 7-25*
- 5311.68 INTERSECTED SOUTH BOUNDARY 5.61' WEST OF COR FOUND STUMPS OF B.T.S AND OLD STAKE VAR CORRECTED 7-32 AUG 19, 1868
- 1870 RUGER VOL 2 PG 46 STONE MON SET BY LOCKE.
- 1874 RUGER VOL 2 PG 127 STONE MON.
- 1895 TWP RD REC BK 2 PG 19 COMMENCING AT THE NORTH END OF A HWY AT OR NEAR THE S.W. COR OF THE NW 1/4 OF SEC 30 OF THE TOWN OF ROCK AND THE S.E. COR OF THE NE 1/4 OF SEC 25 OF THE TOWN OF PLYMOUTH; THENCE RUNNING NORTH ABOUT 1 MILES TO THE 1/4 POST OF SEC 24, OF THE TOWN OF PLYMOUTH AND OF SEC 19 OF THE TOWN OF ROCK; THENCE AT AN ANGLE OF 20 TO A PT 33' EAST OF THE LINE BETWEEN THE SAID TOWNS, THENCE NORTH UPON SAID 33' EAST OF PARALLEL WITH SAID TOWN LINE ABOUT 247.5'; THENCE WEST AT AN ANGLE OF 20 DEGREES TO THE TOWN LINE BETWEEN SAID TOWNS, THENCE NORTH UPON THE TOWN LINE BETWEEN SAID TOWNS TO THE NE COR SEC 24 OF THE TOWN PLYMOUTH AND THE NW COR OF SEC 19 OF THE TOWN OF ROCK TO INTERSECT A HWY IN THE TOWN OF ROCK RUNNING EAST FROM SAID PT OF TERMINATION, THE SAME BEING AN ACCURATE SURVEY THEREOF CAUSED BY US TO BE MADE AND SAID HWY BEING UPON THE TOWN LINE BETWEEN SAID TOWNS OR AS NEAR TO AS THE SITUATION OF THE GROUND WILL ADMIT, THE LINE OF SAID SURVEY IS THE CENTER OF SAID HWY AND THE SAME IS LAID OUT OF THE WIDTH OF 66'.
- 1965 BATTERMAN VOL 4 PG 222 FD CUT STONE & REF SAME.
- 1965 WIDOT MAP #07512 PROJECT S11-01(1) STATES NOTHING ABOUT MON. BEARINGS SHOWN ON THIS PLAT ARE THE TRUE BEARINGS OF EACH TANGENT TO THE NEAREST. N89-32W TO N 1/4 COR SEC 36, S1-01E TO E 1/4 COR SEC 36, & N0-48W TO E 1/4 COR SEC 25.
- 1966 BATTERMAN VOL 4 PG 285 STATE TIES. LAND MARKS ARE CUT CROSS IN BRASS DISK IN 8" CONC. MON. {REF MON}
- 1966 DOT MAP #07516
- 1966 BATTERMN VOL 4 PG 260 REF. WITH 1" PIPES
- 1970 SHIMEALL CSM VOL 1 PG 281 STATES NOTHING ABOUT MON.
- 1972 LEE VOL 4 PG 577 SEE VOL 4 PG 260 888-50-00E 2696.82 TO N 1/4 COR SEC 31 ROCK TWP, NORTH 2647.32 TO E 1/4 COR SEC 25, WPL COORDINATES 219,604.05; 2,234,410.54
- 1974 COMBS CSM VOL 4 PG 170 & 268 & 269 1" PIPE IN MON BOX
- 1977 COMBS CSM VOL 7 PG 71 1" PIPE IN MON. BOX
- 1981 BARNES VOL 6 PG 144 N1-22-22W 2647.21 TO E 1/4 COR SEC 25, S1-37-56E 2658.55 TO E 1/4 COR SEC 36, & N89-47-31E 2698.41 TO N 1/4 COR SEC 31 ROCK TWP
- 1986 BARNES V-1 (ROCK TWP) FD 1" PIPE IN MON BOX. & REFERENCED SAME.
- 1987 LEE MAP #12792 PIPE IN MON. BOX
- 1992 SCHROEDER CSM VOL 15 PG 382 STATES NOTHING ABOUT MON.

FD 1" PIPE IN MON. BOX & REFERENCE MONUMENTS. SET ADDITIONAL REFERENCE MONUMENTS.

SHEET 2 OF 4 CORNER CODE V-1(1)

*Donald Barnes*

6-23-03

PL613

*C) Was the corner restored through acceptance of (1) an obliterated evidence location, or, (2) a found perpetuated location?*

**ACCEPTED FD PIPE IN MON. BOX WHICH, PERPETUATES FD CUT L.S.**

*D) Describe any material discrepancy between the location of the corner as restored or reestablished and the location of that corner as previously restored or reestablished by distance and direction. Show the discrepancy on the plan view drawing under (a), above. Show the distances between the corner as previously restored or reestablished and (1) the corner as restored or reestablished, and (2) to at least 4 of the witness monuments shown on the drawing in (a), above.*

*(E) Was the corner reestablished through lost corner proportionate methods? If so, show the method, including the directions and distances to other public land survey corners used as evidence or used for proportioning the corner location.*

**I, Donald Barnes, hereby certify that the corner location as identified by the corner code index was determined by me under my direction and control and that this U.S. Public Land Survey Monument Record is correct and complete to the best of my knowledge and belief.**

Seal

*Donald Barnes*

*6-20-03*

Emboss

SHEET 3 OF 4

CORNER CODE **V-1(1)**

A-E 7.08 REQUIREMENT

JOHNSON RD

NW CDR  
SEC 31 T2N R12E  
ROCK TWP

FD WIDDT  
DISK IN CONG.  
18' TREE  
1.5

REC N59-34-50E 27.94  
REC N59-34-16E 27.95  
REC N59-34-10E 27.95  
REC N59-34-16E 27.95  
REC N59-34-16E 27.95  
REC N59-34-16E 27.95

FD 1" PIPE  
R/W POST

REC S71-08-54E 120.90  
REC N71-03-36W 120.96  
REC N44-56-30E 98.94  
REC N44-47-41W 98.95  
REC N44-50-33W 98.95

REC S59-08-16E 109.29  
REC S59-10-32E 109.24  
REC S59-10-32E 109.31

REC N87-22-41E 64.72  
REC N5-08-10E 54.40  
REC N5-08-10E 54.37  
REC N63-15-43E 62.19

FD 1" PIPE  
IN MON. BOX

REC S8-32-02E 120.06  
REC S8-34E 120.0X

REC N0-37-00E 132.97  
REC N2-42-20E 133.04  
REC N2-40E 133.0X  
REC N2-40E 133.0X

REC N50-25-15E 98.52  
REC N50-25-15E 98.52  
REC N83-00-51E 124.06  
REC N83-01E 124.0X

REC WIDDT  
DISK IN CONG.  
DID NOT FIND

WPL NAD27  
219,604.05 N/W  
2,234,410.51 E/W  
BARNES 219,604.52 N/S  
2,234,412.88

S74-02-17E 11.34

SET 3/4X24  
REROD/PLASTIC  
CAP



S21-44-49E 55.55  
79.70  
N1-49W 78.7X

REC N1-47-20W 78.58  
REC N1-47-20W 78.58  
REC N1-47-20W 78.58

S44-44-08E 66.99  
S44-43E 67.0X

SET 3/4X24  
REROD/PLASTIC  
CAP

REC 3/4X24  
REROD  
DID NOT FIND

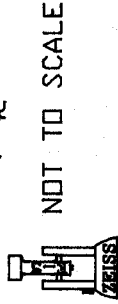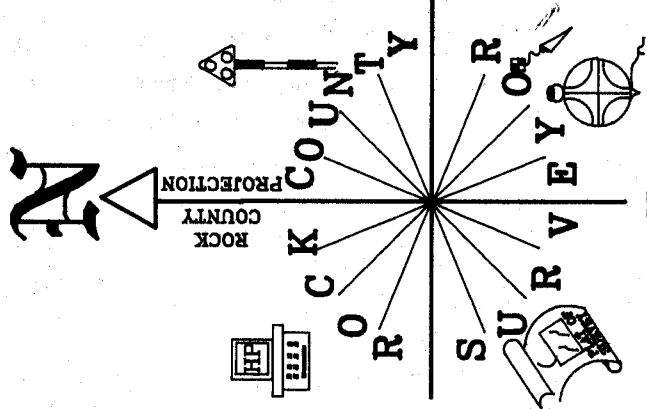

OBSERVATION SHEETS 345, 613  
ROCK TWP FB #2 PG 69 & FB #3 PG 30  
RECORD BEARINGS ARE BASED ON ROCK  
TWP PROJECT.

BEARINGS & DISTANCE TO RECORD  
REF. MONUMENTS THAT WERE NOT  
FOUND WERE COMPUTED FROM  
RECORD OBSERVATIONS

PLYMOUTH  
/CHURCH RD

EMBOSSSED SEAL

Donald Barnes

6-20-03

V-1(1)