

# U.S. PUBLIC LAND SURVEY MONUMENT RECORD

For Public Land Survey Corners In:  
T. 2N. R. 12E. 4th P.M.  
CORNER CODE INDEX

WI ADMINISTRATIVE CODE A-E 7.08 REQUIREMENT  
REV 10/23/2004 USMONREC.DWG

A	1	2	3	4	5	6	7	8	9	10	11	12	13	14	15	16	17	18	19	20	21	22	23	24	25	A
B																										B
C	6						5					4					3				2			1		C
D																										D
E																										E
F																										F
G	7						8					9					10				11			12		G
H																										H
J																										J
K	18						17					16					15				14			13		K
L																										L
M																										M
N																										N
O																										O
P	19						20					21					22				23			24		P
Q																										Q
R																										R
S																										S
T	30						29					28					27				26			25		T
U																										U
V																										V
W																										W
X	31						32					33					34				35			36		X
Y																										Y
Z																										Z

Rock TWP  
ROCK COUNTY WI

IF AVAILABLE  
ROCK COUNTY COORDINATES PREFERRED

North \_\_\_\_\_ Elev. \_\_\_\_\_

East \_\_\_\_\_

Hor. Datum \_\_\_\_\_ Vert. Datum \_\_\_\_\_

LATITUDE \_\_\_\_\_ ELLIPS. HT. \_\_\_\_\_

LONGITUDE \_\_\_\_\_

NAD83(91) \_\_\_\_\_ NETWORK ADJ. YR \_\_\_\_\_

GPS (X) \_\_\_\_\_ TRAVERSE (X) \_\_\_\_\_

BASED ON THE FOLLOWING CONTROL:  
\_\_\_\_\_

PLACE MONUMENT SYMBOL  AT PROPER LOCATION ON ABOVE INDEX

CORNER MONUMENT       WITNESS MONUMENT

BEARINGS ARE BASED ON: \_\_\_\_\_

FIELD BOOK \_\_\_\_\_ PAGE # \_\_\_\_\_ SHEET 1 OF 2

SHOW A PLAN VIEW DRAWING DEPICTING THE CORNER MONUMENT AND SURROUNDING PHYSICAL FEATURES, INCLUDING THE EXCAVATION AREA AND DEPTH.

PLANNING & ZONING COMMITTEE ADOPTED THIS FORM ON 12/2/1982

CORNER CODE Z-7 (1)

RO624

(B) Describe any record evidence, monument evidence, occupational evidence, testimonial evidence or any other material evidence you considered, and whether the monument was found or placed.

1833 MULLETT & BRINK SOUTH BOUNDARY T2N R12E VAR 7-25  
EAST ON SOUTH SIDE SEC 32

2640 SET QUARTER SECTION POST & MADE MOUND

5280 SET POST CORNER SECTIONS 32 & 33 IN MARSH &  
MADE MOUND LAND LEVEL WET MARSH FLAG?  
BUSHES WILLOW GRASS

1834 HARRISON INTERIOR OF BELOIT TWP. DID NOT ESTABLISH  
THE N 1/4 COR SEC 5.

1971 LEE VOL 4 PG 539 2671 FROM N/S FENCE NEAR S 1/4 COR SEC  
32 TO THE CI @ THE SE COR SEC 32

1981 BARNES VOL 6 PG 143 NB9-46-05E 2652.29 TO THE SW COR  
OF SEC 32, 173.0 TO THE N 1/4 COR SEC 5, NB9-36-32E  
2669.30 TO THE SE COR SEC 32.

1981 BARNES VOL 6 PG 167 BELOIT FB# 1 PG 24 DUG & FD COR  
POST. REPLACED WITH CAST IRON MON.

1990 BARNES Z-007 FB#3 PG 15 FD CI & REFERENCED SAME.

FD C.I. & REFERENCE PINS. ALSO FD REMAINS OF BURNED  
CARSONITE POST. REMEASURED TO MY OLD STATION  
3510R, A FD R/R SPIKE, 4538R, FD PK, THE PIPE IN THE MON BOX  
AT THE E 1/4 COR SEC 5, CI MON AT N 1/4 COR SEC 5, THE CI @ S 1/4  
COR SEC 32 ROCK TWP., & REFERENCE MONUMENTS

S 1/4 COR SEC 32 NB9-57-38E 175.37 TO N 1/4 COR SEC 5 BELOIT  
TWP.

NB9-35-52W 2651.98 TO SW COR SEC 32

SB9-45-20E 2669.73 TO SE COR SEC 32

C) Was the corner restored through acceptance of (1) an obliterated evidence location, or, (2) a found perpetuated location?


ACCEPTED FD CI MONUMENT.

D) Describe any material discrepancy between the location of the corner as restored or reestablished and the location of that corner as previously restored or reestablished by distance and direction. Show the discrepancy on the plan view drawing under (a), above. Show the distances between the corner as previously restored or reestablished and (1) the corner as restored or reestablished, and (2) to at least 4 of the witness monuments shown on the drawing in (a), above.

(E) Was the corner reestablished through lost corner proportionate methods? If so, show the method, including the directions and distances to other public land survey corners used as evidence or used for proportioning the corner location.

I, **Donald Barnes**, hereby certify that the corner location as identified by the corner code index was determined by me under my direction and control and that this U.S. Public Land Survey Monument Record is correct and complete to the best of my knowledge and belief.

Seal

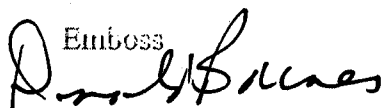
Emboss  


4-6-2006

SHEET 1 OF 2

CORNER CODE **Z-7(1)**

A.E. 7.08 REQUIREMENT

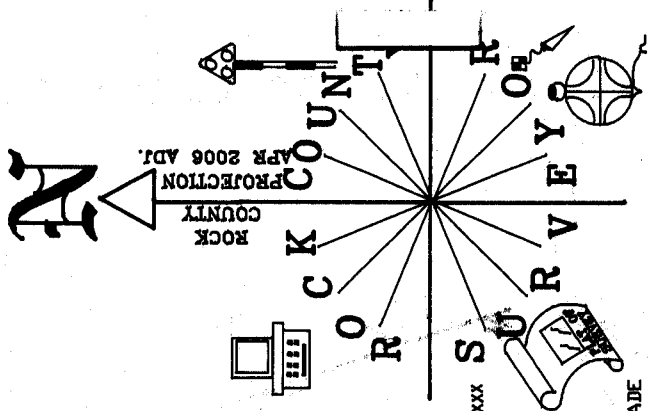


OBSERVATION SHEETS 624R & 9003R

S 1/4 COR  
SEC 32  
ROCK TWP

N 1/4 COR  
SEC 5  
BELDIT TWP

VERY WET SOIL  
SAW GRASS

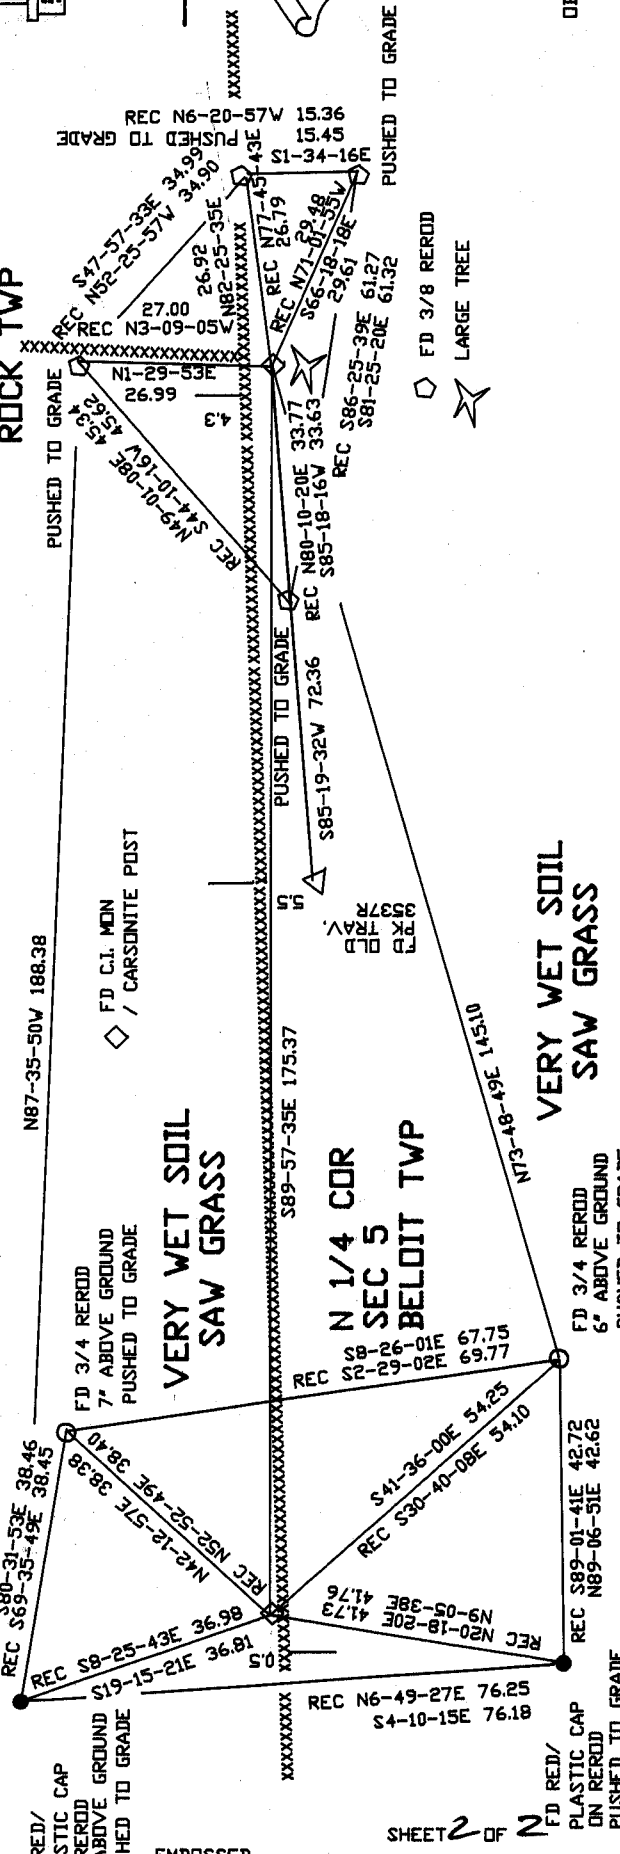

FD RED/  
ON REROD  
PLASTIC CAP  
5" ABOVE GROUND  
PUSHED TO GRADE

EMBOSSED  
SEAL

SHEET 2 OF 2

FD REROD/  
ON REROD  
PLASTIC CAP  
6" ABOVE GROUND  
PUSHED TO GRADE

*Dual Barney*  
Z-7(1)  
4-6-2006