U.S.


PUBLIC LAND SURVEY MONUMENT RECORD

For	Public	Land	Survey	Corners	in:
COL	Public	Lano	Survey	Corners	IN:

WI ADMINISTRATIVE CODE A-E 7.08 REQUIREMENT

. T. 2N., R. 12E

CORNER CODE INDEX

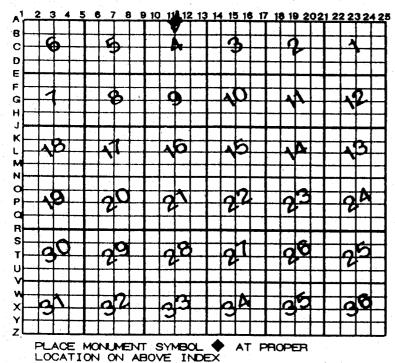

ROCK COUNTY WI

IF AVAILABLE
ROCK COUNTY COORDINATES PERFERRED

North _____ Elev. ____

East _____

Hor. Datum ____ Vert. Datum ____

LATITUDE ____ ELLIPS. HT.

LONGITUTE ____ TRAVERSE (X) ___

BASED ON THE FOLLOWING CONTROL:

◆CORNER MONUMENT

WITNESS MONUMENT

BEAFINGS ARE BASED ON:

(a)

							,	1
FIELD	воок	PAGE	#			SHEET	/ OF	4
				_	NER MONUM			•
					AREA AND D	3011110	ONDING	
	1				ON 10/0/1000			

R0506

(B) Describe any record evidence, monument evidence, occupational evidence, testimonial evidence or any other material evidence you considered, and whether the monument was found or placed.

1833 MULLETT NOV

EAST ON SOUTH SIDE SECTION 33

2640 SET 1/4 SECTION POST BUR DAK B N52 1/2E 353.76', BUR DAK B S34 1/2E 251.46'

5280 SET POST CORNERS SECTIONS 33 & 34 BUR OAK 12 N68E 139.92', BUR OAK 8 N88W 170.28' LAND ROLLING SECOND RATE LAST ½ TIMBERED WITH WHITE BLACK AND BUR OAK HICKORY CROSSING FIRST ½ DRY PRAIRIE

1834 HARRISON

NORTH BETWEEN SECS 4 & 5

2640 QUARTER SEC COR ON GROUND DESCENDING SE POST & MOUND

3960 SUMMIT OF RIDGE E & W

5383.62 INT. N BDY 16.5' EAST OF POST SET POST & MOUND LAND ROLLING 1ST RATE PRAIRIE SOIL GOOD ????

1834 HARRISON

NORTH BET SECS 3 & 4

1650 LEFT PRAIRIE

2372.04 HICKORY 10"

2640 QUARTER SEC COR {BUR DA 10 N72E 330', BUR D 10 N55W 69.96' BUR D 10 BUR D 10} MARKED

3525.72 BURR 0 12

5016 BROOK 5.28' CRS S.E.

5313 SAME BROOK S.W.

5338.08 INT N BDY 33' W OF POST {BURR OAK 20 855E 108.24', BURR OA 12 857W 126.06'

- 1847 MARCY JANESVILLE TWP REC BK1 PG 97 MINUTES OF THE SURVEY OF A ROAD TAKEN THE 15TH DAY OF MAY, 1847 BY J. MARCH ARE AS FOLLOWS: BEGINNING AT THE NORTHWEST CORNER OF SEC 1, T2N R12, W.T.; THENCE NORTH 89 WEST ON THE LINE BETWEEN T2 AND 3, 612 RODS (10,098') TO A STAKE; THENCE SOUTH 66W 18 1/2 RODS (305.25') TO A STAKE; THENCE NORTH 83W 8 RODS (132') TO A STAKE; THENCE NBOW 18 1/2 RODS (305.25'); THENCE NORTH 83W 132 RODS (2178') TO A QUARTER POST ON THE NORTH LINE OF SEC. 4; THENCE 83 W TWO MILES AND 132 RODS (12,738') ON THE TOWN LINE TO THE WEST LINE OF SEC 6 MAKING A DISTANCE OF FIVE MILES AND ONE ROD BY SECTIONS (26,416.5'). THE TOWN LINE IS TO BE THE CENTER OF THE ROAD EXCEPT WHERE IT CROSSES THE CREEK NEAR THE CORNER OF SEC 3 AND 4; AND THE ROAD FOUR WIDE. VARIATION OF THE NEEDLE 7 E. I DO HEREBY CERTIFY THAT THE ABOVE IS A TRUE DESCRIPTION OF THE ROAD DESCRIBED; THEREIN CALLED THE TOWN LINE ROAD. JONATHAN MARCY, SURVEYOR
- 1858 JANESVILLE TWP REC BK 1 PG 284 WE THE UNDERSIGNED SUPERVISORS OF THE TOWN OF JANESVILLE IN THE COUNTY OF ROCK HAVING BY AN ORDER BEARING DATE THE 4TH DAY OF DECEMBER A.D. 1858 UPON DUE APPLICATION FOR THAT PURPOSE LAID OUT A HIGHWAY AS FOLLOWS TO WIT: SAID HIGHWAY IS TO COMMENCE AT A POINT IN THE CENTER OF THE GALENA ROAD (SO CALLED) AND AT THE NORTHEAST CORNER OF THE SOUTHWEST QUARTER OF SECTION 33, TOWN 3 NORTH, RANGE 12 EAST, RUNNING THENCE SOUTH ON THE QUARTER SECTION LINE TO THE SOUTHEAST CORNER OF SAID QUARTER SECTION AND TO INTERSECTION THE AFTON ROAD (SO CALLED). THE LINE OF SAID SURVEY TO BE THE CENTERLINE OF SAID HIGHWAY. AND CERTAIN OWNERS OF LANDS THROUGH WHICH SAID HIGHWAY IS LAID OUT TO WIT: SOLOMON HUTSON NOT HAVING RELEASE ALL CLAIM TO DAMAGES SUSTAINED BY REASON OF THE LAYING AND OPENING SAID HIGHWAY AND NOT BEING ABLE TO AGREE WITH LINE AS TO THE AMOUNT OF SUCH DAMAGE HAVING APPLIED SHEET 1 OF 4

CORNER CODE A-11(1)

Nordd Banes 7/27/04

RD506

TO HIM FOR THAT PURPOSE AND ENDEAVORED TO MAKE SUCH AGREEMENT WE DID PROCEED AND ASSESS THE DAMAGES WHICH SAID OWNER WOULD SUSTAIN BY REASON OF THE LAYING OUT SUCH HIGHWAY THROUGH HIS LANDS AS FOLLOWS: TO SOLOMON HUTSON ON THE S.W. QUARTER OF SECTION 33, TOWN 3 NORTH, RANGE 12 EAST WE HAVE AWARDED THE SUM OF ONE HUNDRED AND SEVENTY-FIVE DOLLARS FOR DAMAGES TO SAID LAND.

- 1860 RUGER VOL 1 PG 126 STATES NOTHING ABOUT N 1/4 COR SEC 4, 2626.8 TO NE COR SEC 4, VAR 7-37 2628.78 FROM NW COR SEC 4 TO S 1/4 COR SEC 33, SHOWS S 1/4 COR SEC 33 1.98' EAST OF N 1/4 COR SEC 4.
- 1881 LEE VOL 2 PG 318 @ S 1/4 COR SEC 33 FD REMAINS OF OLD STAKE DROVE NEW ONE, VAR 6-40 2661.12 TO SE COR SEC 33 FD STUMPS OF NE B & FENCE POST AT COR MARKED IT BY AXE ABOVE & BELOW WIRE, & 2638.68 TO CENTER OF SEC 33.
- 1932 SUNNY VOL 3 PG 208 S ¼ COR SEC 33 DUG LARGE HOLE FOUND NOTHING. SHOWS N ¼ COR SEC 4 WEST OF S ¼ COR SEC 33. WESTERLY 2659.3 TO N/S FENCE LINE, EASTERLY 2659.6 TO N/S FENCE, NORTHERLY 2662.95 TO PIPE 0.4W OF CENTER OF CONCRETE, NORTHERLY 5325.9 TO CENTER OF GRAVEL ROAD & N/S FENCE.
- 1970 BATTERMAN VOL 4 PG 436 DUG & FD REMAINS OF OLD STAKE SET BY RK LEE AT S 1/4 COR SEC 33, SET 1" PIPE & REFERENCED, @ N 1/4 COR SEC 4 DUG LARGE HOLE & FOUND NOTHING. RESET. SET 1" PIPE & REFERENCED SAME. B.25 WEST OF S 1/4 COR SEC 33.
- 1977 COMBS CSM VOL 6 PG 261
- 1977 COMBS CSM VOL 6 PG 360
- 1979 COMBS CSM VOL 8 PG 446
- 1981 BARNES VOL 6 PG186 2634.83 TO FD MON BOX @ NW COR SEC 4, 2647.93 TO ALUM MON @ NE COR SEC 4 (FD PIECES OF STAKE SURROUNDED BY 5 L.S. & SET ALUM.) NE COR SEC 4 IS 20.04 WEST OF SE COR SEC 33. @ SE COR SEC 33 FD 1' DEEP 3 L.S. ON E,W, & S AND A HH ON NORTH. SET ALUM. N 1/4 COR IS 8.25 WEST OF S 1/4 COR SEC 4. ANGLE @ N 1/4 COR SEC 4 FROM NE TO NW COR SEC 4 IS 179-29-04
- 1983 SCHROEDER CSM VOL 11 PG 366
- 1988 BARNES REMON USED POLY
- 1991 BARNES REMON USED POLY
- 1986 BARNES Z-11 FD POLY MONS IN MON. BOX & REFERENCED. COORDINATES & ELEV. SHOWN. CORNER CALLED FOR SWITCHED 12/16/96 DAB, NOW CALLS FOR N 1/4 COR SEC 4 WEST 8.14 OF THE S 1/4 COR SEC 33.
- 1987 RKT #11570
- 1987 BARNES VOL 6 PG 363 FD MON. BOX WITH PIPE, DROVE PIPE DEEP & PLACED POLY MON ON TOP {AT S 1/4 & N 1/4 CORNERS).
- 1987 COMBS CSM VOL 13 PG 152
- 1990 BARNES A-11 FD POLY MONS IN MON. BOX & REFERENCED. COORDINATES & ELEV. SHOWN. CORNER CALLED FOR SWITCHED 12/16/96 DAB, NOW CALLS FOR N 1/4 COR SEC 4 WEST 8.14 OF THE S 1/4 COR SEC 33.
- 1990 DOT #16708
- 1993 COMBS CSM VOL 17 PG 115
- 1998 LATHROP CSM VOL 21 PG 396
- 1999 DOT #22165
- 1999 DOT #22163
- 2000 COMBS #7958
- 2000 DOT #24849 & 24848 & 24847
- 2001 COMBS CSM VOL 24 PG 180

Darlo Barres 7/27/2004

SHEET 2 OF 4 CORNER CODE **A-11(1)**

AN ERROR WAS DISCOVERED IN THE ADJUSTMENT DATA BASE. THE NUMBERS FOR THE N 1/4 COR SEC 4 AND THE S 1/4 COR SEC 33 WERE REVERSED. THE APPROPRIATE CHANGES WERE MADE AND THE REMONUMENTATION MAPS CORRECTED.

C) Was the corner restored through acceptance of (1) an obliterated evidence location, or, (2) a found perpetuated location?

IN PREVIOUS REMONUMENTATION PROJECTS I ACCEPTED THE N 1/4 COR AS ESTABLISHED BY BATTERMAN IN 1970. HOWEVER, SINCE MAKING THE CHANGES AND REEVALUATING THE INFORMATION I BELIEVE THE CORNER IS QUESTIONABLE FOR THE FOLLOWING REASONS:

- 1) BATTERMAN NEVER STATED WHY HE PLACED THE N 1/4 COR 8.25' WEST OF THE S 1/4 COR SEC 33.
- 2) A POINT MIDWAY BETWEEN THE NW AND NE CORNERS OF SEC 4 IS 1.70' WEST OF THE S 1/4 COR SEC 33 WHICH IS IN HARMONY WITH RUGER'S 1.98' DISTANCE.
- D) Describe any material discrepancy between the location of the corner as restored or reestablished and the location of that corner as previously restored or reestablished by distance and direction. Show the discrepancy on the plan view drawing under (a), above. Show the distances between the corner as previously restored or reestablished and (1) the corner as restored or reestablished, and (2) to at least 4 of the witness monuments shown on the drawing in (a), above.

THERE IS A DISCREPANCY BETWEEN THE JOG DISTANCE AS IS AND RUGER'S DISTANCE. ALSO POSITION AS MONUMENTED IS NOT MID WAY BETWEEN THE NE AND NW CORNERS OF SEC 4 AS CALLED FOR BY THE FEDERAL MANUAL.

(E) Was the corner reestablished through lost corner proportionate methods? If so, show the method, including the directions and distances to other public land survey corners used as evidence or used for proportioning the corner location.

I, Donald Barnes, hereby certify that the corner location as identified by the corner code index was determined by me under my direction and control and that this U.S. Public Land Survey Monument Record is correct and complete to the best of my knowledge and belief.

1/27/04

SHEET 3 OF 4

A-11(1)CORNER CODE

A.E. 7.08 REQUIREMENT

