


The above is a record & plat of a survey made by me on section 22 Harmony July 6, 1893 &

O. E. Bledsoe
 County Surveyor

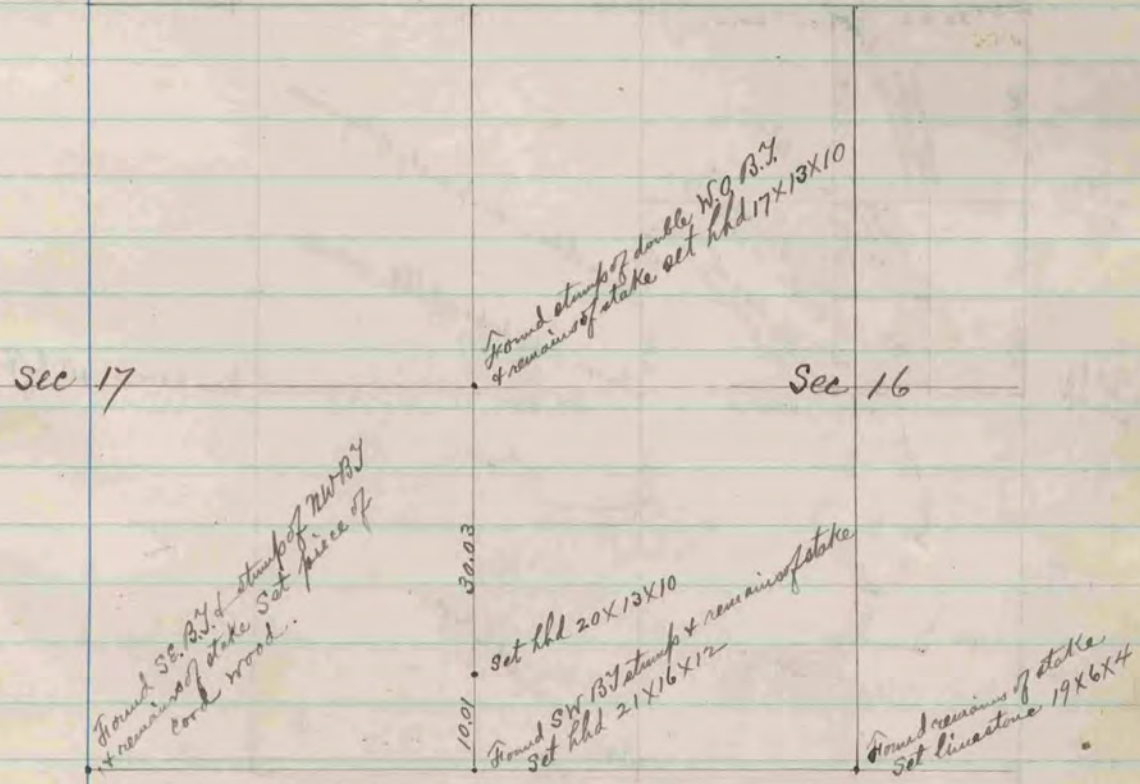

The above is a record & plat of a survey made by me on sections 16 & 17 Town 5 range 13 Aug 31, 1893 & Sept 1, 1893

O. E. Bledsoe
 County Surveyor