

Paper weight-110# (minimum)

Black nonfading ink required

U.S. PUBLIC LAND SURVEY MONUMENT RECORD

For Public Land Survey Corners In:
T. 4 N. R. 10 E. 4th P.M.
CORNER CODE INDEX

WI ADMINISTRATIVE CODE A-E 7.08 REQUIREMENT
REV 10/23/2004 USMONREC.DWG

UNION TWP
ROCK COUNTY WI

IF AVAILABLE
ROCK COUNTY COORDINATES PREFERRED

A	1	2	3	4	5	6	7	8	9	10	11	12	13	14	15	16	17	18	19	20	21	22	23	24	25	A
B																										B
C																										C
D																										D
E																										E
F																										F
G																										G
H																										H
I																										I
J																										J
K																										K
L																										L
M																										M
N																										N
O																										O
P																										P
Q																										Q
R																										R
S																										S
T																										T
U																										U
V																										V
W																										W
X																										X
Y																										Y
Z																										Z

North _____ Elev. _____

East _____

Hor. Datum _____ Vert. Datum _____

LATITUDE _____ ELLIPS. HT. _____

LONGITUDE _____

NAD83(91) _____ NETWORK ADJ. YR 2010 _____

GPS (X) _____ TRAVERSE (X) X

BASED ON THE FOLLOWING CONTROL:

PLACE MONUMENT SYMBOL AT PROPER LOCATION ON ABOVE INDEX

CORNER MONUMENT WITNESS MONUMENT

BEARINGS ARE BASED ON: ROCK COUNTY PROJECTION

FIELD BOOK _____ PAGE # _____
OR OBSERVATION SHEET _____

SHEET 1 OF 3

SHOW A PLAN VIEW DRAWING DEPICTING THE CORNER MONUMENT AND SURROUNDING PHYSICAL FEATURES, INCLUDING THE EXCAVATION AREA AND DEPTH.

PLANNING & ZONING COMMITTEE ADOPTED THIS FORM ON 12/2/1982

CORNER CODE C-9(1)

UN516 W1/4CORSEC4

(B) Describe any record evidence, monument evidence, occupational evidence, testimonial evidence or any other material evidence you considered, and whether the monument was found or placed.

- 1833 (NOV) HARRISON (NOV 9) T4N R10E 4TH MER. NORTH
BETWEEN 4 & 5
2640.00 QUARTER SEC COR {BURR O 18 S16W 38.94';
BURR O 12 N78E 27.72' BURR O 18 & BURR O
12} MARKED
5181.00 INT. NORTHERN BOUNDARY 92.4' WEST OF P
{W.O. 12 S48E 110.22'; BURR O 18 S79W 108.9'
W.O. 12 & BURR O 18} MARKED LAND SAME NOV
9TH 1833
- 1856 CHURCH VOL 1 PG 61 STATES NOTHING ABOUT MON. VAR
7-30 2726.46 TO CENTER OF SEC 6 & VAR 7-30 5481.96?
TO W 1/4 COR SEC 5
- 1870 RUGER AUG REMON-117 NORTH ON WEST LINE OF SW
1/4 SEC 4 ON A VAR 7-30; OFFSET WEST
7.92' OFFSET EAST 15.84' AT
2654.52 INTERSECTED QUARTER LINE 42.24' WEST OF
QUARTER CORNER. FOUND LARGE STONE
SURROUNDED BY SEVERAL STONES AT CORNER.
ALSO FOUND STUMP OF EAST BEARING TREE.
COR VAR 6-25
NORTH ON WEST LINE OF NW 1/4 SEC 4
ON A VAR 6-50; OFFSET EAST 11.22'
OFFSET WEST 15.84' AT
2561.46 INTERSECTED NORTH BOUNDARY LINE 1.98'
EAST OF CORNER. COR VAR 6-58
- 1904 KERCH VOL 3 PG 22 MONUMENT 2569.0 TO NE COR SEC 5
- 1968 BATTERMAN VOL 4 PG 488 DUG & FD 6X6 CUTSTONE.
REFERENCED SAME.
- 1970 COMBS CSM VOL 1 PG 351 SET 1" PIPE OVER CUT STONE
- 1976 SCHROEDER CSM VOL 5 PG 238 STATES NOTHING ABOUT
MON. EAST TO E 1/4 COR SEC 4 FOR LINE. SO-48W 35.00 TO
LOT COR.
- 1976 SCHROEDER CSM VOL 5 PG 262 STATES NOTHING ABOUT
MON.
- 1977 COMBS #12956 MORTGAGE INSPECTION STATES NOTHING
ABOUT MON.
- 1978 LEE #5073 FD 1" PIPE NO-27-44W 2569.61 TO CUT STONE @
NW COR SEC 4, N89-28-19E 2658.26 TO CENTER OF SEC 4,
& N89-28-19E 5333.08 TO E 1/4 COR SEC 4.
- 1980 FED #5075 FD 1" PIPE 4' SOUTH OF E/W PVMT CENTER & 5'
WEST OF N/S PVMT CENTER. NO-23-37W 2569.69 TO 6X6
LIMESTONE @ NW COR SEC 4, N89-32-26E 2658.38 TO 1/2
REBAR @ CENTER OF SEC 4, & N89-32-26E 5332.91 TO FD 1"
PIPE @ E 1/4 COR SEC 4.
- 1986 KARNS #13305 & #13304 SEC COR. NO-1949E TO NE COR
SEC 5 & WEST 2813.02 TO 1/16TH COR.
- 1987 WILLIAMSON CSM VOL 13 PG 137 FD PK NO-22-36E TO CUT
LS @ E 1/4 COR SEC 5
- 1987 RADEL C-9 1 FD A P.K. NAIL AT THE EAST 1/4 COR OF SEC
5, TOWN OF UNION. THE PK WAS APARENTLY SET IN THE
ASPHALT PAVEMENT OVER THE CUT LIMESTONE AS SHOWN
ON THE EXISTING ROCK COUNTY TIE SHEE. THE
REFEERENCE TIES ARE STILL IN PLACE AND THE TIES
MEASURE CORRECTLY WITH RESPECT TO THE EXISTING TIE
SHEET.
- 1991 COMBS CSM VOL 15 PG 295 FD ALUM. 2658.32 TO FD SPIKE
@ CENTER OF SEC 4
- 1991 COMBS CSM VOL 15 PG 336 FD ALUM. 2658.32 TO FD SPIKE
@ CENTER OF SEC 4
- 1993 COMBS CSM VOL 16 PG 251 1993 COMBS CSM VOL 16 PG
251 FD CUT STONE 2666.0X TO FD PK @ E 1/4 COR SEC 5

SEAL

SHEET 1 OF 3

CORNER CODE C-9(1)

Emboss
Donald
Barnes

OCT 20, 2011

UN516W1/4CORSEC4

2006 LATHROP CSM VOL 30 PG 307 FD PK NO-03-37E 2569.52 TO CUT LS. @ NW COR SEC 4 & EAST 5332.95 TO ALUM @ E 1/4 COR SEC 4. PIN 33.00 NORTH OF W 1/4 COR SEC 4
2007 KARNS CSM VOL 32 PG 38 FD ROCK COUNTY COR.
2009 BTK #16231
2011 DALRING CSM PRELIM FD PK NAIL. S88-55-14W 2812.70 TO CENTER OF CENTER OF SEC 5, S88-55-14W 5523.93 TO FD ALUM. MON @ W 1/4 COR SEC 5

FD PK & 1968 BATTERMAN REFERENCE PIPES. NORTH REFERENCE PIPE IS ON THE NORTH EDGE OF WOOD FENCE POST & IMPOSSIBLE TO GET A RANGE POLE PLUMBED OVER IT.

C) Was the corner restored through acceptance of (1) an obliterated evidence location, or, (2) a found perpetuated location?

DID NOT ACCEPT FD PK. INTERSECTION OF BATTERMAN'S DISTANCE FROM THE HIS FOUND CUT LIMESTONE TO THE REFERENCE PIPES CHECK. ACCEPTED THE RECORD CUT LIMESTONE LOCATIONS AS PERPETUATED BY FD PIPE.

D) Describe any material discrepancy between the location of the corner as restored or reestablished and the location of that corner as previously restored or reestablished by distance and direction. Show the discrepancy on the plan view drawing under (a), above. Show the distances between the corner as previously restored or reestablished and (1) the corner as restored or reestablished, and (2) to at least 4 of the witness monuments shown on the drawing in (a), above.

SHOWN IN DIAGRAM. THE FD PK IS N70-51E 0.20' FROM THE CUT LIMESTONE.

(E) Was the corner reestablished through lost corner proportionate methods? If so, show the method, including the directions and distances to other public land survey corners used as evidence or used for proportioning the corner location.

NO

I, **Donald Barnes**, hereby certify that the corner location as identified by the corner code index was determined by me under my direction and control and that this U.S. Public Land Survey Monument Record is correct and complete to the best of my knowledge and belief.


Donald Barnes

SHEET 2 OF 3

OCT 20, 2011

CORNER CODE C-9(1)


A.E. 7.08 REQUIREMENT

E 1/4 COR
 SEC 5
 T4N R10E
 UNION TWP

OBSERVATION SHEET #1516
 1968 BATTERMAN VOL 4-488


- FD 1" PIPE
- FD PIN/LATH
- ◡ TALL WOOD POST
- REC L.S.

PK

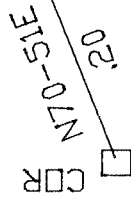

N69-02-20W CELL 12,455'

HOLT RD

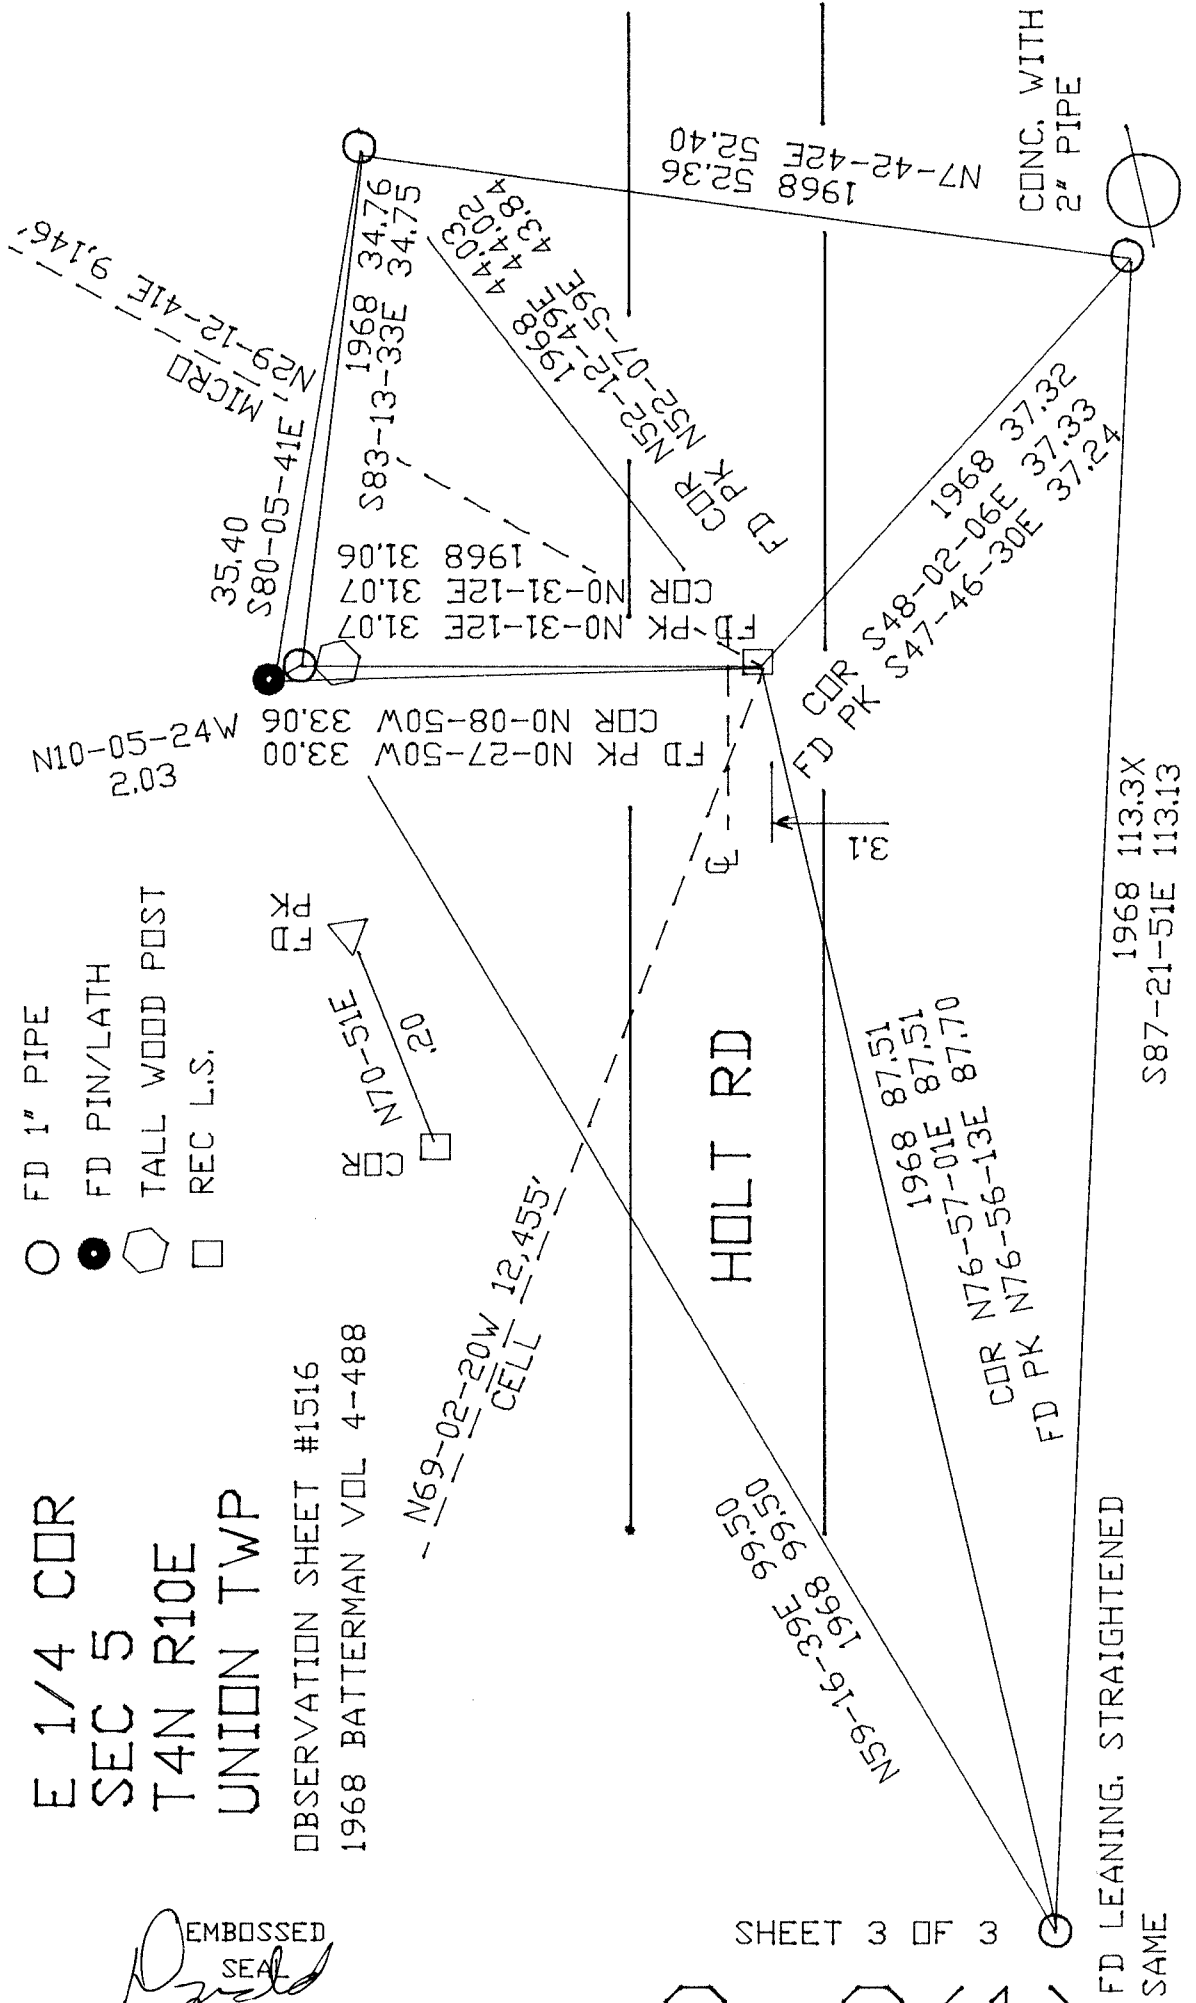

C-961

SHEET 3 OF 3

EMBOSSED SEAL
D. J. Barnes
 Oct 20, 2011