Paper weight-110# (minimum)

Black nonfading ink required

U.S. PUBLIC LAND SURVEY MONUMENT RECORD


For Public Land Survey Corners In:

WI ADMINISTRATIVE CODE A-E 7.08 REQUIREMENT

REV 10/23/2004 USMONREC.DWG

T. 4 N. R. 10 E. 4th P.M.

CORNER CODE INDEX

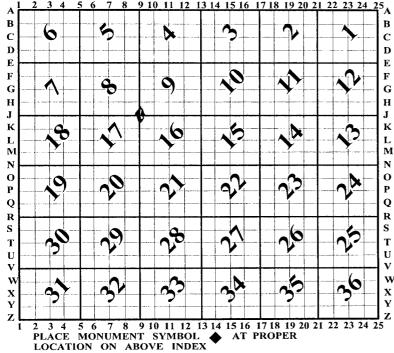

UNION TWP

IF AVAILABLE ROCK COUNTY COORDINATES PERFERRED

North	Elev
East	
Hor. Datum	Vert. Datum
LATITUDE	ELLIPS. HT.
LONGITUDE	
NAD83(91)NI	ETWORK ADJ. YR 2010
GPS (X) TF	RAVERSE (X) X
BASED ON THE FOI	LOWING CONTROL:

♦ CORNER MONUMENT

WITNESS MONUMENT

FIELD BOOK _____ PAGE # _____ OF SHEET ____ OF SHOW A PLAN VIEW DRAWING DEPICTING THE CORNER MONUMENT AND SURROUNDING PHYSICAL FEATURES, INCLUDING THE EXCAVATION AREA AND DEPTH.

PLANNING & ZONING COMMITTEE ADOPTED THIS FORM ON 12/2/1982

CORNER CODE 5-9(1)

UN545 SECORSEC8

(B) Describe any record evidence, monument evidence, occupational evidence, testimonial evidence or any other material evidence you considered, and whether the monument was found or placed.

1833 (NOV) HARRISON TAN RIDE 4TH MER. NORTH BETWEEN 16 &

2640.00 QUARTER SEC COR. {BURR 0 14 S76W 34.32'; BURR 0 12 N61E 9.24' BURR 0 14 & BURR 12}MARKED

4111.80 WO 24

4521.00 BROOK 9.9' CRS E

5280.00 COR TO SECS 8,9,16,&17 {BURR O 24 N52W 124.08'; BURR O 12 S75W 53.46; W.O. 24 N79E 151.8'; BURR O 30 S43E 7.92' LAND GENTLY LEVEL 2ND RATE WITH BURR & W.O. TIMBER

1833 HARRISON EAST ON RAND. BET SECS 9 & 16

2640.00 TEMPY 1/4 SEC COR.

4884.00 ROAD N.W.

5299.80 INT E BDY 26.4'S OF P LAND SAME WEST COR WEST

2649.90 QUARTER SEC COR. {BURR O 12 S46E 15.18'; BURR O 12 N78E 17.82' BURR O 12 & BURR O 12}MARKED

5299.80 SEC COR.

1833 (NOV) HARRISON (NOV 9) T4N R10E 4^{TH} MER. NORTH BETWEEN 8 & 9

13.2 ROAD S.W

2640.00 QUARTER SEC COR {BURR 0 12 N54W 26.4'; BURR 0 12 N81E 27.72'

5280.00 SEC COR TO SECS 4,5,8,9 {BURR O 12 S70E 44.88'; BURR O 10 S84W 46.2'; BURR O 10 S84W 44.22'; BURR O 12 N28E LAND LEVEL 2ND RATE TIMBER ALL BURR O. UNDERGROWTH GRASS & WEEDS.

1833 HARRISON (NOV 10) EAST ON RAND. BET SECS 8 & 17

1026.96 ROAD S.E.

2640.00 TEMPY 1/4 SEC COR.

3960.00 BROOK 5.28 CRS S.E.

5286.60 ROAD S.W

5330.16 E BDY 19.8'S OF P LAND ROLLING 2ND RATE TIMBER RED BURR & W.O. GROWTH GRASS & WEEDS

WEST COR WEST BET 8 & 17

2663.43 QUARTER SEC COR {BURR 0 20 N40W 13.2'; BURR 0 12 S72E 19.8' BURR 0 20 & BURR 0 12}MARKED

5330.16 SEC COR

NOV 10TH 1833

1856 CHURCH VOL 1 PG 60 2663.1 TO N 1/ COR SEC 16

1863 REGISTER OF DEEDS TRACT BOOK. BOOK 54 PG 415 "STRIP 50" WIDE EACH SIDE OF CENTER LINE OF BELOIT & MADISON RAIL ROAD ACCROSSES SE 1/4 OF SE 1/4 & SW 1/4 OF SE 1/4 OF SEC 8

1870 RUGER AUG REMON-91 SOUTH ON EAST LINE OF NE 1/4
SEC 17 ON A VAR 7-40; OFFSET WEST 17.16'
AT

2663.76 INTERSECTED QUARTER LINE 5.28' WEST OF QUARTER CORNER. FOUND OLD STAKE AT CORNER. COR VAR 7-25'

SOUTH ON EAST LINE OF SE 1/4 SEC 17 ON A VAR 7-40; OFFSET WEST 5.28' OFFSET EAST 17.16' OFFSET WEST 24.42' AT

2636.70 INTERSECTED SOUTH BOUNDARY LINE 21.12' EAST OF CORNER. COR VAR 6-58

SHEET 1 OF 5 CORNER CODE **J-9(1)**

0 ct 24, 2011

UN545 SECORSEC8

1870 RUGER AUG 27 REMON-92 EAST ON NORTH LINE OF NW
1/4 SEC 16 ON A VAR 8-15, AT

2706.66 INTERSECTED QUARTER LINE AT QUARTER CORNER. FOUND STAKE SURROUNDED BY 4 HARD HEAD STONES SET BY SELF IN A PREVIOUS SURVEY AT CORNER.

EAST ON NORTH LINE OF NE 1/4 SEC 16 ON A VAR 8-05; AT

2678.28 INTERSECTED EAST BOUNDARY LINE 8.08 SOUTH OF CORNER. FOUND STAKE SURROUNDED BY 4 HARD HEAD STONES SET BY SELF AT CORNER IN A PREVIOUS SURVEY.

COR VAR 8-15

1870 RUGER AUG REMON-90 EAST ON NORTH LINE OF NW 1/4

SEC 17 ON A VAR 7-10; OFFSET NORTH 20.46'

OFFSET NORTH 18.15' OFFSET SOUTH 15.84'

COULD FIND NO TRACE OF QUARTER CORNER.

CONTINUED EAST ON SAME VARIATION AT

5379.00 INTERSECTED EAST BOUNDARY LINE AT CORNER ESTABLISHED NORTH QUARTER CORNER IN A TRUE LINE BETWEEN AND EQUI-DISTANT FROM THE NE AND NW CORNERS OF SAID SECTION, IT BEING 2689.50 DISTANT FROM EACH. COR VAR 7-40

1870 RUGER AUG REMON-120 SOUTH ON WEST LINE OF NW

1/4 SEC 9 ON A VAR 6-35; OFFSET EAST 19.8'

OFFSET EAST 7.26 OFFSET WEST 7.92' OFFSET

EAST 3.30' AT

2654.52 INTERSECTED QUARTER LINE 8.58' EAST OF QUARTER CORNER. FOUND OLD STAKE AT CORNER. ALSO FOUND STUMPS OF BEARING TREES. COR VAR 6-58'

SOUTH ON WEST LINE OF SW 1/4 SEC 9 ON A VAR 7-10; OFFSET EAST 11.88 AT

2644.62 INTERSECTED SOUTH BOUNDARY LINE 11.88 EAST OF CORNER. SEPTEMBER 8 1870

- 1873 ATLAS OF ROCK COUNTY IN REGISTER OF DEEDS OFFICE SHOWS R/R IS IN.
- 1890 BLEEDORN VOL 2 PG 430 FD MON
- 1957 BATTERMAN VOL 3 PG 516 CUT STONE MON REMOVED DURING REGRADING RESET AUG 15, 1957. REFERENCED,. CORNER IS ON SOUTH SIDE OF ROAD & WEST R/W FENCE OF R/R. 33.50' SOUTH OF CENTER OF RD. & 33.30' TO CENTER OF TRACKS. 2710.17 TO S 1/4 COR SEC 9
- 1976 SCHROEDER CSM VOL 5 PG 312 STATES NOTHING ABOUT MON.
- 1979 LEUENBERGER CSM VOL 8 PG 394 FD PK IN R/R ROW
- 1979 BARNES VOL 5 PG 532 THE SEC COR AS REFERENCED IN VOL 3 PG 516 IS INCORRECT. THE TERRAIN AND CUTS FOR THE ROAD & RAILROAD INDICATES THE STONE WAS DISTURBED AS STATED. THE STONE IS INCORRECT FOR THE FOLLOWING REASONS:
 - 1) THE REMONUMENTATION FIELD NOTES OF 1870 STATES THE N 1/4 COR OF SEC 17 IS ON LINE WITH THE NE & NW CORNERS OF SEC 17
 - 2) THE PRORATED DISTANCES TO THE SOUTH, NORTH, EAST, & WEST ARE IN HARMONY WITH THE ABOVE REASON. REFERENCED SAME.
- 1979 BARNES VOL 5 PG 528 CALLS FOR S88-56-07W 2694.14 TO N 1/4 COR SEC 17, N89-47-06E 2711.33 TO N 1/4 COR SEC 16, S0-24-25E 2670.20 TO 1/4 COR SEC 17, & N0-11-47E 2651.00 TO E 1/4 COR SEC 8

1980 DOT RD REC MAP #332

CORN

SHEET 2 OF 5 CORNER CODE J-9(1)

James 0 ct 24,2811

UN545 SECORSEC8

- BARNES VOL 6 PG 275 FD PK AS REFERENCED IN VOL 5 PG 1982 532
- KARNS CSM VOL 17 PG 321 2709.64 TO N 1/4 COR SEC 16 1994
- LATHROP CSM VOL 18 PG 318 PK SO-38-20W 2669.43 TO LS 1995 @ S 1/4 COR SEC 17
- SCHROEDER #8678 & #8704 STATES NORTHING ABOUT 1997 MONUMENT. CALLS FOR IT IN THE CENTER OF R.R. S88-56-07W 70.32 TO PK ON R/R R/W LINE, S0-24-25E TO PIN ON R/R R/W LINE
- BARNES J-9 FD SMALL HOLE IN ASHHALT. DUG O.2' DEEP 1997 FD NOTHING. PK WAS PROBABLY DESSTROYED WHEN SHORT INNER RAILS WERE INSTALLED. PLACED COTTON GIN PIN FROM REFERENCE MONUMENTS.
- SCHROEDER CSM VOL 20 PG 162 SEC COR. STATES 1997 NOTHING ABOUT MON. IN R/R ROW

FD COTTON GIN SPINDLE, CUT LIMESTONE, & NW REFERENCE PIPE. ACCEPTED FD COTTON GIN SPINDLE.

C) Was the corner restored through acceptance of (1) an obliterated evidence location, or, (2) a found perpetuated location?

HISTORIC DOCUMTENTS INDICATES THE RAIL ROAD TRACKS WERE PROBABLY IN PRIOR TO RUGER PLACING THE CUT LIMESTONE. HOWEVER IT IS DIFFICULT TO ACCEPT RUGER PLACED THE FD STONE IN THE ROADWAY AND THAT CLOSE TO THE RAIL WITHOUT MENTIONING IT IN HIS FIELD NOTES. THE RAILS MAY HAVE BEEN PLACED JUST AFTER THE CUT LIMESTONE AND THE DEEDS WERE REFERING TO THE PENDING INSTALLATION OF RAILS. SINCE IN 1890 BLEEDORN VOL 2 PG 430 FD THE MON, IT MUST OF CO-EXISTED WITH THE TRAIN TRACKS. EITHER THE TRACKS WHERE IN A DIFFERENT LOCATION OR THE STONE WAS MOVED WHEN THE TRACKS WERE INSTALLED.

ACCEPTED FD COTTON GIN SPINDLE. DID NOT ACCEPT THE CUT LIMESTONE, WHICH WAS RESET BY BATTERMAN. THE SPINDLE IS IN HARMONY WITH PRORATION OF RUGERS DISTANCES & HIS CALL FOR THE S 1/4 COR SEC 8 BEING ON LINE WITH THE SW & SE CORNERS OF SEC 8.

- D) Describe any material discrepancy between the location of the corner as restored or reestablished and the location of that corner as previously restored or reestablished by distance and direction. Show the discrepancy on the plan view drawing under (a), above. Show the distances between the corner as previously restored or reestablished and (1) the corner as restored or reestablished, and (2) to at least 4 of the witness monuments shown on the drawing in (a), above.
- IN 1957 BATTERMAN VOL 3 PG 516 STATED THE CUT STONE MON WAS REMOVED DURING REGRADING - RESET AUG 15, 1957. HE REFRENCED THE CUT LIMESTONE. THE L.S. IS ON SOUTH SIDE OF ROAD & WEST R/W FENCE OF R/R. 2710.17 TO S 1/4 COR SEC 9. THE CUT LIMESTONE @ THE N 1/4 COR OF SEC 17 IS 0.22' OFF A LINE BETWEEN FD CUT LIMESTONE @ THE NW COR OF SEC 17 & THE FD COTTON GIN SPINDLE @ THE NE COR SEC 17. THIS IS IN HARMONY WITH RUGER'S CALL OF THE N 1/4 COR SEC 17 BEING ON THIS LINE. THE PRORATION WITH RUGER'S REMONUMENTATION DISTANCES TO ADJACENT CUT LIMESTONES IS IN HARMONY WITH THE CALLS FOR THE NORTH LINE OF SEC 17.
- $(E) \ Was \ the \ corner \ reestablished \ through \ lost \ corner \ proportion at e \ methods? \ If \ so, \ show \ the \ method,$ including the directions and distances to other public land survey corners used as evidence or used for proportioning the corner location.
- I, Donald Barnes, hereby certify that the corner location as identified by the corner code index was determined by me under my direction and control and that this U.S. Public Land Survey Monument Record is correct and complete to the best of my knowledge and belief.

SHEET 3 OF 5

CORNER CODE J-9(1)

A.E. 7.08 REQUIREMENT Oct 24, 2011

