## Paper weight-110# (minimum) Black nonfading ink required PUBLIC LAND SUI U.S. SURVEY MONUMENT RECORD


For Public Land Survey Corners In:

WI ADMINISTRATIVE CODE A-E 7.08 REQUIREMENT

REV 10/23/2004 USMONREC.DWG

T. 4 N. R. 10 E. 4th P.M.

CORNER CODE INDEX

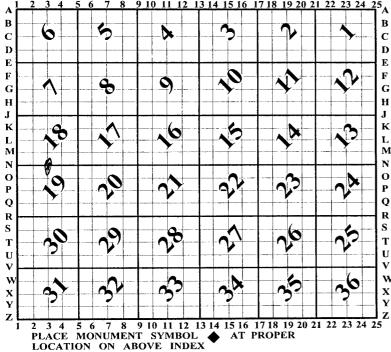

UNION TWP **ROCK COUNTY WI** 

IF AVAILABLE ROCK COUNTY COORDINATES PERFERRED

North \_\_ Elev. East Hor. Datum \_\_\_\_\_ Vert. Datum LATITUDE ELLIPS. HT.

LONGITUDE \_ NAD83(91) \_\_\_\_\_NETWORK ADJ. YR 2010

GPS (X) \_\_\_\_ TRAVERSE (X) X

BASED ON THE FOLLOWING CONTROL:

<b>♦</b> CORNER	MONUMENT
-----------------	----------

O WITNESS MONUMENT

	L
(a)	
ROCK COUNTY PROJECTION	
į	_
	BASED
ļ	ARE
1	BEARINGS

FIELD BOOK PAGE #		1 /
OR OBSERVATION SHEET	SHEET	OF
SHOW A PLAN VIEW DRAWING DEPICTING THE CORNER MONUMENT AND S	URROUN	IDING
PHYSICAL FEATURES, INCLUDING THE EXCAVATION AREA AND DEPTH.		N - 3(0)
PLANNING & ZONING COMMITTEE ADOPTED THIS FORM ON 12/2/1982		

## UN562 N1/4CORSEC19

- (B) Describe any record evidence, monument evidence, occupational evidence, testimonial evidence or any other material evidence you considered, and whether the monument was found or placed.
- 1833 HARRISON (NOV) T4N R1DE 4<sup>TH</sup> MER. WEST BETWEEN SECS 18 & 19
  - 2640.00 QUARTER SEC COR. SET POST & RAISED MOUND
  - 5491.20 INT. BNDY LINE OF RANGE 9E 950.40 N OF P SET COR TO SECS 18 & 19 POST & RAISED MOUND LAND LEVEL & SOMEWHAT WET 2ND RATE PRAIRIE GROWTH GRASS & WEEDS
- 1860 RUGER VOL 1 PG 149 SET HARDHEAD 14X12X9
  SURROUNDED BY 4 HH. USED TO SUBDIVIDE SEC 19,
  2653.20 TO NE COR SEC 19, 2844.60 TO NW COR SEC 19
- 1861 RUGER VOL 1 PG 166 STATES NOTHING ABOUT MON. USED TO SUBDIVIDE SEC 18, 2647.92 TO SE COR SEC 18 & 2925.12 TO SW COR SEC 18.
- 1870 RUGER AUG REMON-87 EAST ON NORTH LINE OF NW 1/4
  SEC 19 ON A VAR 8-00; AT
  - 2844.60 INTERSECTED QUARTER LINE AT QUARTER CORNER. FOUND HARD HEAD STONE AT CORNER SET BY SELF IN A PREVIOUS SURVEY.

EAST ON NORTH LINE OF NE 1/4 SEC 19 ON A VAR 7-25; AT

- 2653.20 INTERSECTED EAST BOUNDARY LINE AT CORNER. FOUND STONE AT CORNER SET BY SELF IN A PREVIOUS SURVEY.
- 1976 BARNES VOL 5 PG 136 DUG 2.5 DEEP FD CUT STONE
  MARKED "S 1/4". SET ALUM IN 1976. REFERENCED SAME.

  @ N 1/6 COR OF NW 1/4 SEC 19 DUB A HOLE 2.5 DEEP FD
  12X5X3 LIMESTONE WITH LIMESTONES ON N AND S SIDES.
  ALL COVERED BY METAL KETTLY. SET 1 1/4X25" IP &
  REFERENCED SAME.
- 1976 BARNES VOL 5 PG 141 USED TO ESTABLISH NW COR SEC 19.
  WESTERLY 1319.31 TO 1/16TH COR & 2849.52 TO NW COR
  SEC 19
- 1979 BARNES VOL 5 PG 528 SHOWS REC DISTANCES
- 1979 KARNS CSM VOL 8 PG 376 FD ALUM.
- 1995 BIRRENKOTT #9211 FD ALUM. MON EAST 1530.66 TO FD IRON STAKE THENC EAST 1319.19 TO ALUM MON @ N 1/4 COR SEC 19
- 2007 COMBS CSM VOL 32 PG 13 ALUM. 2657.98 TO ALUM @ SE COR SEC 18
- 2011 OFTEDAHL N-01 FD ALUM. MON 2" BELOW RD SURFACE. SET SW REFERENCE REBAR, FD NE REFERENCE PIPE @ 35.27 [REC 35.21], FD NW REFERENCE PIPE @ 36.01 [35.94], & FD SW REFERENCE PIPE @ 35.57 [REC 35.64].

FD ALUM MON WITH TOP BROKE OFF. ACCORDING TO OFTEDAHL'S TIES, IT IS IN HARMONY WITH THE FD 3 REFERENCE PIPES.

C) Was the corner restored through acceptance of (1) an obliterated evidence location, or, (2) a found perpetuated location?

ACCEPTED FD ALUM. WHICH PERPETUATES THE FD CUT LIMESTONE.

D) Describe any material discrepancy between the location of the corner as restored or reestablished and the location of that corner as previously restored or reestablished by distance and direction. Show the discrepancy on the plan view drawing under (a), above. Show the distances between the corner as previously restored or reestablished and (1) the corner as restored or reestablished, and (2) to at least 4 of the witness monuments shown on the drawing in (a), above.

## NONE

I, **Donald Barnes**, hereby certify that the corner location as identified by the corner code index was determined by me under my direction and control and that this U.S. Public Land Survey Monument Record is correct and complete to the best of my knowledge and belief.

SHEET 1 OF 1

CORNER CODE N-0 (1)