Paper weight-110# (minimum)

Black nonfading ink required

#### U.S. LAND **PUBLIC** SURVEY MONUMENT RECORD


For Public Land Survey Corners In:

WI ADMINISTRATIVE CODE A-E 7.08 REQUIREMENT

USMONREC.DWG REV 10/23/2004

T. 4 N. R. 10 E. 4th P.M.

CORNER CODE INDEX

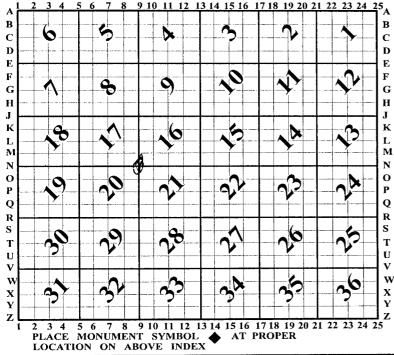

## **UNION TWP** ROCK COUNTY WI

IF AVAILABLE ROCK COUNTY COORDINATES PERFERRED

North	Elev
East	
Hor. Datum	Vert. Datum
LATITUDE	ELLIPS. HT
LONGITUDE	
NAD83(91)	NETWORK ADJ. YR 2010
GPS (X)	TRAVERSE (X) X
BASED ON THE	FOLLOWING CONTROL:

**◆ CORNER MONUMENT** 

WITNESS MONUMENT

(a) ROCK COUNTY PROJECTION BEARINGS ARE BASED ON:\_

FIELD BOOK PAGE #		/	2
OR OBSERVATION SHEET	SHEET		
SHOW A PLAN VIEW DRAWING DEPICTING THE CORNER MONUMENT AND	D SURROUN	DING	
PHYSICAL FEATURES, INCLUDING THE EXCAVATION AREA AND DEPTH.			
PLANNING & ZONING COMMITTEE ADOPTED THIS FORM ON 12/2/1982		1017	

CORNER CODE 19(1)

QUARTER CORNER FOUND STAKE AT CORNER. COR VAR 6-09

> SOUTH ON EAST LINE OF SE 1/4 SEC 16 ON A VAR 6-15; OFFST EAST 3.96 AT

- 2656.17 INTERSECTED SOUTH BOUNDARY LINE 7.26 EAST OF CORNER. FOUND OLD STAKE AT CORNER. COR VAR 6-11
- 1870 RUGER AUG REMON-92 AUGUST 27,1870 WEST ON
  SOUTH LINE OF SE 1/4 SEC 17 ON A VAR 7-15;
  COULD FIND NO TRACE OF SOUTH QUARTER CORNER.
  CONTINUED WEST ON SOUTH LINE OF SW 1/4 OF
  SAID SECTION, AT
  - 5327.19 INTERSECTED WEST BOUNDARY LINE AT CORNER. ESTABLISHED SOUTH QUARTER CORNER AT A POINT IN A TRUE LINE BETWEEN AND EQUIDISTANT FROM THE SE & SW CORNERS OF SAID SECTION, IT BEING DISTANT FROM EACH 2663.60
- 1870 RUGER AUG 29 REMON-95 SOUTH ON EAST LINE OF NE 1/4 SEC 20 ON A VAR 6-22; OFFSET EAST 7.26' AT
  - 2645.94 INTERSECTED QUARTER LINE 5.94' WEST OF QUARTER CORNER. FOUND OLD STAKE AT CORNER. COR VAR 6-39 AUGUST 29,1870

    SOUTH ON EAST LINE OF SE 1/4 SEC 20
    ON A VAR 6-22; OFFSET WEST 5.94'
    OFFSET EAST 4.29' OFFSET WEST 4.29' AT
  - 2641.98 INTERSECTED SOUTH BOUNDARY LINE 6.73'
    WEST OF CORNER. COR VAR 7-42
- 1890 BLEEDORN VOL 2 PG 430 MON 2634.39 TO E 1/4 COR SEC 17
- 1891 BLEEDORN VOL 2 PG 459 MON 2648.42 TO N 1/4 COR SEC 20 & 2664.09 TO E 1/4 COR SEC 20
- 1938 SUNNY VOL 3 PG 403 DUG LARGE & DEEP HOLES AT BOTH PLACES. FD NOTHING. 2659 FROM E/W PVMT CENTER @ WEST N/S FENCE LINE ON WEST SIDE OF RD. 2631.4 FROM N/S PVMT CENTER TO STONE MON. @ S 1/4 COR SEC 16
- 1974 BATTERMAN VOL 4 PG 246 DUG & FD NOTHING.
- 1979 BARNES VOL 5 PG 528 THE REMONUMENTATION FIELD NOTES OF 1870 STATES THE S 1/4 COR WAS MIDWAY & ON LINE WITH THE SE & SW CORNERS OF SEC 17. THIS LOCATION IS OVER A CMP. DID NOT DIG OR REESTABLISH THE CORNER.
- 1982 BARNES N-9 SET R/R SPIKE. REFERENCED COR. 29' WEST OF N/S PVMT CENTER, 4' NORTH OF E/W PVMT CENTER, & 1' EAST OF EAST CSM EDGE. BJ SUNNY DUG AT CENTER OF ROADS. I DID NOT DIG BECAUSE OF THE CMP. THE MONUMENT WAS DESTROYED BY THE CULVERT. I USED RUGER'S 1870 REMONUMENTATION DISTANCES TO SET THE CORNER. RUGER MEASURED

S 1/4 SEC 17 TO SE COR SEC 17 2663.60 2670.16 SE COR SEC 17 TO S 1/4 COR 16 2653.86 2660.38

TOTAL 5317.46 5330.54

5330.54 = X

5317.46 = 2663.60

IS 2670.16 PRORATED

W 1/4 COR SEC 17 TO SE COR 17 2636.70 2641.31 SE COR SEC 17 TO E 1/4 COR 20 2645.94 2650.58 W 1/4 COR SEC 20 TO SE COR 20 2641.98 2646.61 TOTAL 7924.62 7938.50

7938.50 = X

7924.62 = 2641.98 IS 2646.61 PRORATED

SHEET 1 OF 2

CORNER CODE N-9(1)

Dans Band Oct 20, 2011

#### UN565 SECORSEC17

IN RUGER'S FIELD BOOK HE STATES HE SET THE S 1/4 COR OF SEC 17 ON LINE WITH THE SE & SW CORNERS OF SEC 17 AT PROPORTIONATE DISTANCE. IF THE SW & S 1/3 COR IS DOUBLED OVER IT IS 2.64' SOUTH & 1.13 EAST OF THE SE CORNER AS SET BY ME.

- 1982 BARNES N-9 SET R/R SPIKE & REFERENCED SAME. 29 WEST OF N/S PVMT CENTER, 4' NORTH OF E/W PVMT CENTER, & 1' EAST OF EAST CMP EDGE. FB# PG 72. IN THE FIELD BOOK, RUGER STATES HE SET THE S 1/4 COR OF SEC 17 ON LINE WITH THE SE & SW CORNERS OF SEC 17 AT PROPORTIONATE DISTANCE. IF THE SW & S 1/4 COR IS DOUBLED OVER IT IS 2.64' SOUTH & 1.13' EAST OF THE SE CORNER AS SET BY ME. 2660.38 TO S 1/4 COR SEC 16. SUNNY DUG @ CENTER OF RD INTERSECTION. I DID NOT DIG BECAUSE OF THE CMP.
- 1982 COMBS CSM VOL 11 PG 152 SET PIPE.
- 1982 BARNES VOL 6 PG 288 N89-32-02E 2660.38 TO N 1/4 COR SEC 21, NO-27-06W 2641.31 TO E 1/4 COR EC 17, & SO-05-35E 2650.58 TO E 1/4 COR SEC 20
- 1983 LEE CSM VOL 11 PG 211 FD PIPE. N89-32-02E TO CONC MON @ 5 1/4 COR SEC 16 & N0-27-06W ALONG SEC LINE
- 1995 LATHROP CSM VOL 18 PG 458 PK N1-49-20E 2644.68 TO LS @ E 1/4 COR SEC 17
- 1999 JRK CSM VOL 22 PG 438 FD R/R SPIKE 2670.06 TO COR COUNTY MON @ N 1/4 COR SEC 20
- 2000 KARNS CSM VOL 23 PG 115 R/R SPIKE N1-15-23E TO LS @ E 1/4 COR SEC 17 & N89-20-44W 2670.02 TO ALUM @ S 1/4 COR SEC 17
- 2004 COMBS CSM VOL 27 PG 215 FD R/R SPIKE N89-37-53W 2670.01 TO ALUM @ N 1/4 COR SEC 20
- 2004 COMBS CSM VOL 29 PG 65 FD R/R 2641.94 TO LS @ E 1/4 COR SEC 17

CUT LIMESTONE WAS PROBABLY DESTROYED BY INSTALLATION OF CMP. THE LOCATION OF THE S 1/4 COR SEC 17 IS 1.29 OFF A LINE BETWEEN THE SW & SE CORNERS OF SEC 17 AND WITHIN 0.62 OF THE MID POINT. RUGER ESTABLISHED THE S 1/4 COR SEC 17 MIDWAY & ON LINE WITH THE SW & SE CORNERS OF SEC 17. I ACCEPTED FD TIES & USED OLD OBSERVATIONS IN TWP ADJUSTMENT.

C) Was the corner restored through acceptance of (1) an obliterated evidence location, or, (2) a found perpetuated location?

# ACCEPTED LOCATION THAT I ESTABLISHED BY OBLITERATED EVIDENCE LOCATION.

D) Describe any material discrepancy between the location of the corner as restored or reestablished and the location of that corner as previously restored or reestablished by distance and direction. Show the discrepancy on the plan view drawing under (a), above. Show the distances between the corner as previously restored or reestablished and (1) the corner as restored or reestablished, and (2) to at least 4 of the witness monuments shown on the drawing in (a), above.

### NONE

(E) Was the corner reestablished through lost corner proportionate methods? If so, show the method, including the directions and distances to other public land survey corners used as evidence or used for proportioning the corner location.

NC

I, **Donald Barnes**, hereby certify that the corner location as identified by the corner code index was determined by me under my direction and control and that this U.S. Public Land Survey Monument Record is correct and complete to the best of my knowledge and belief.

SHEET 2 OF 2

CORNER CODE N-9(1)

A.E. 7.08 REQUIREMENT

oct 20,2011